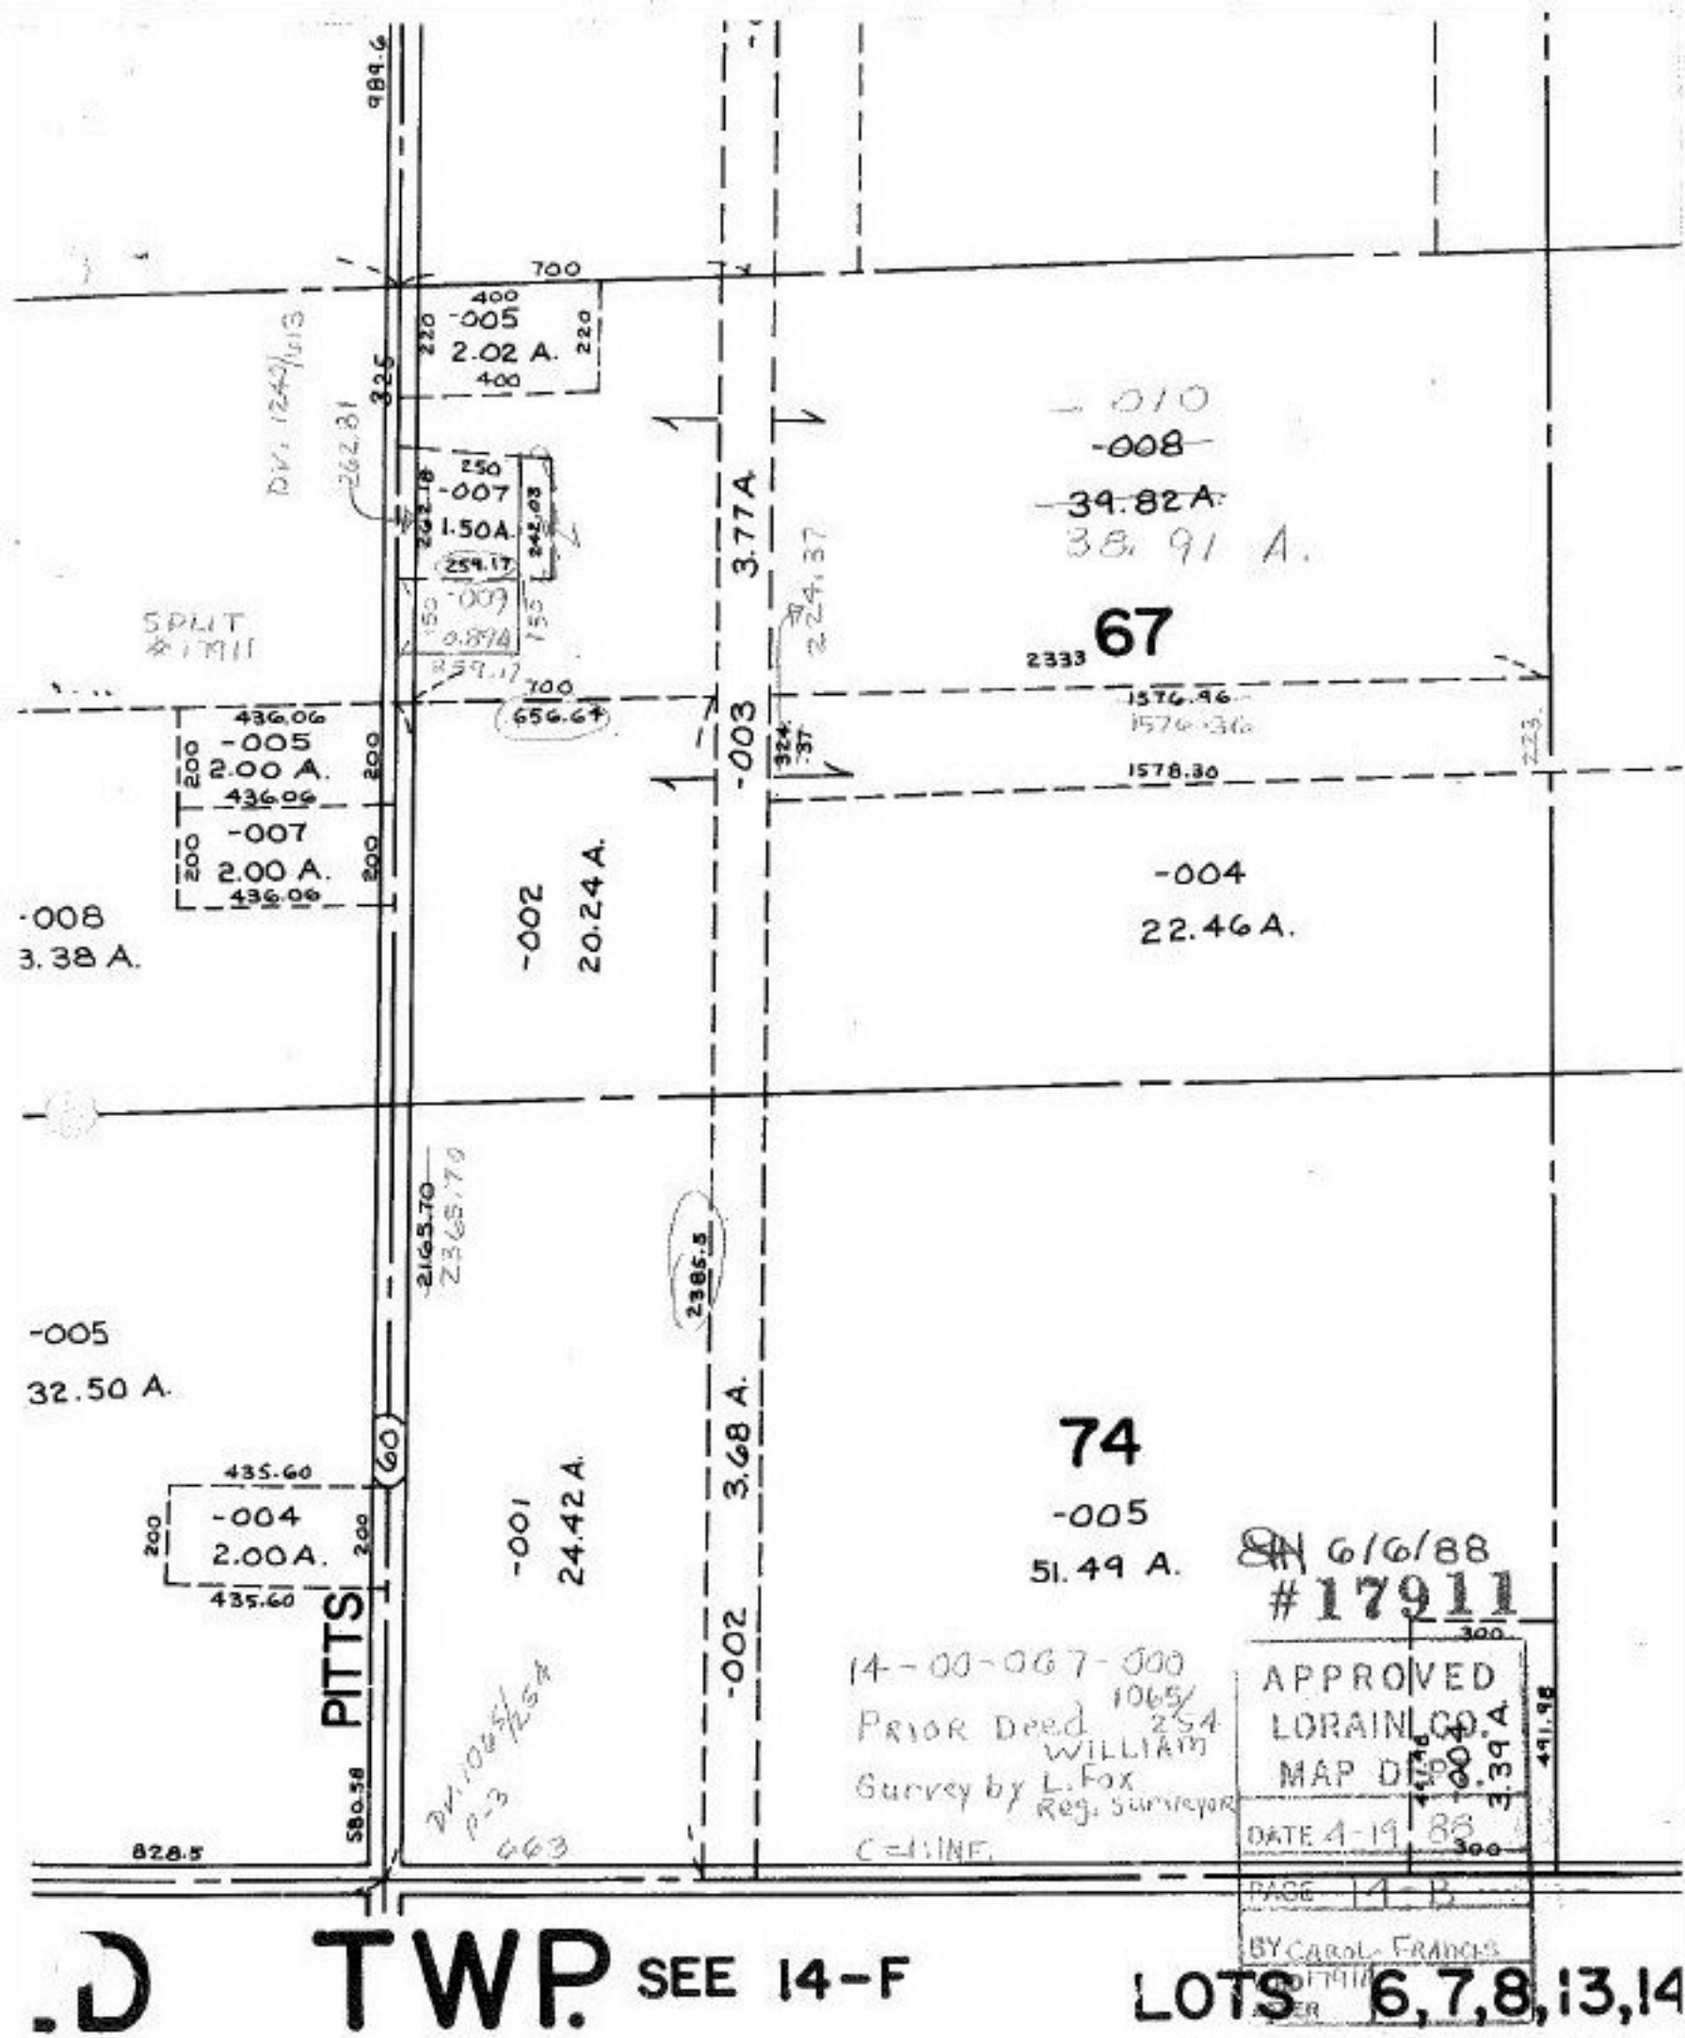

.D TWP. SEE 14-F

LOTS 6,7,8,13,14
46,47,48,53,54,