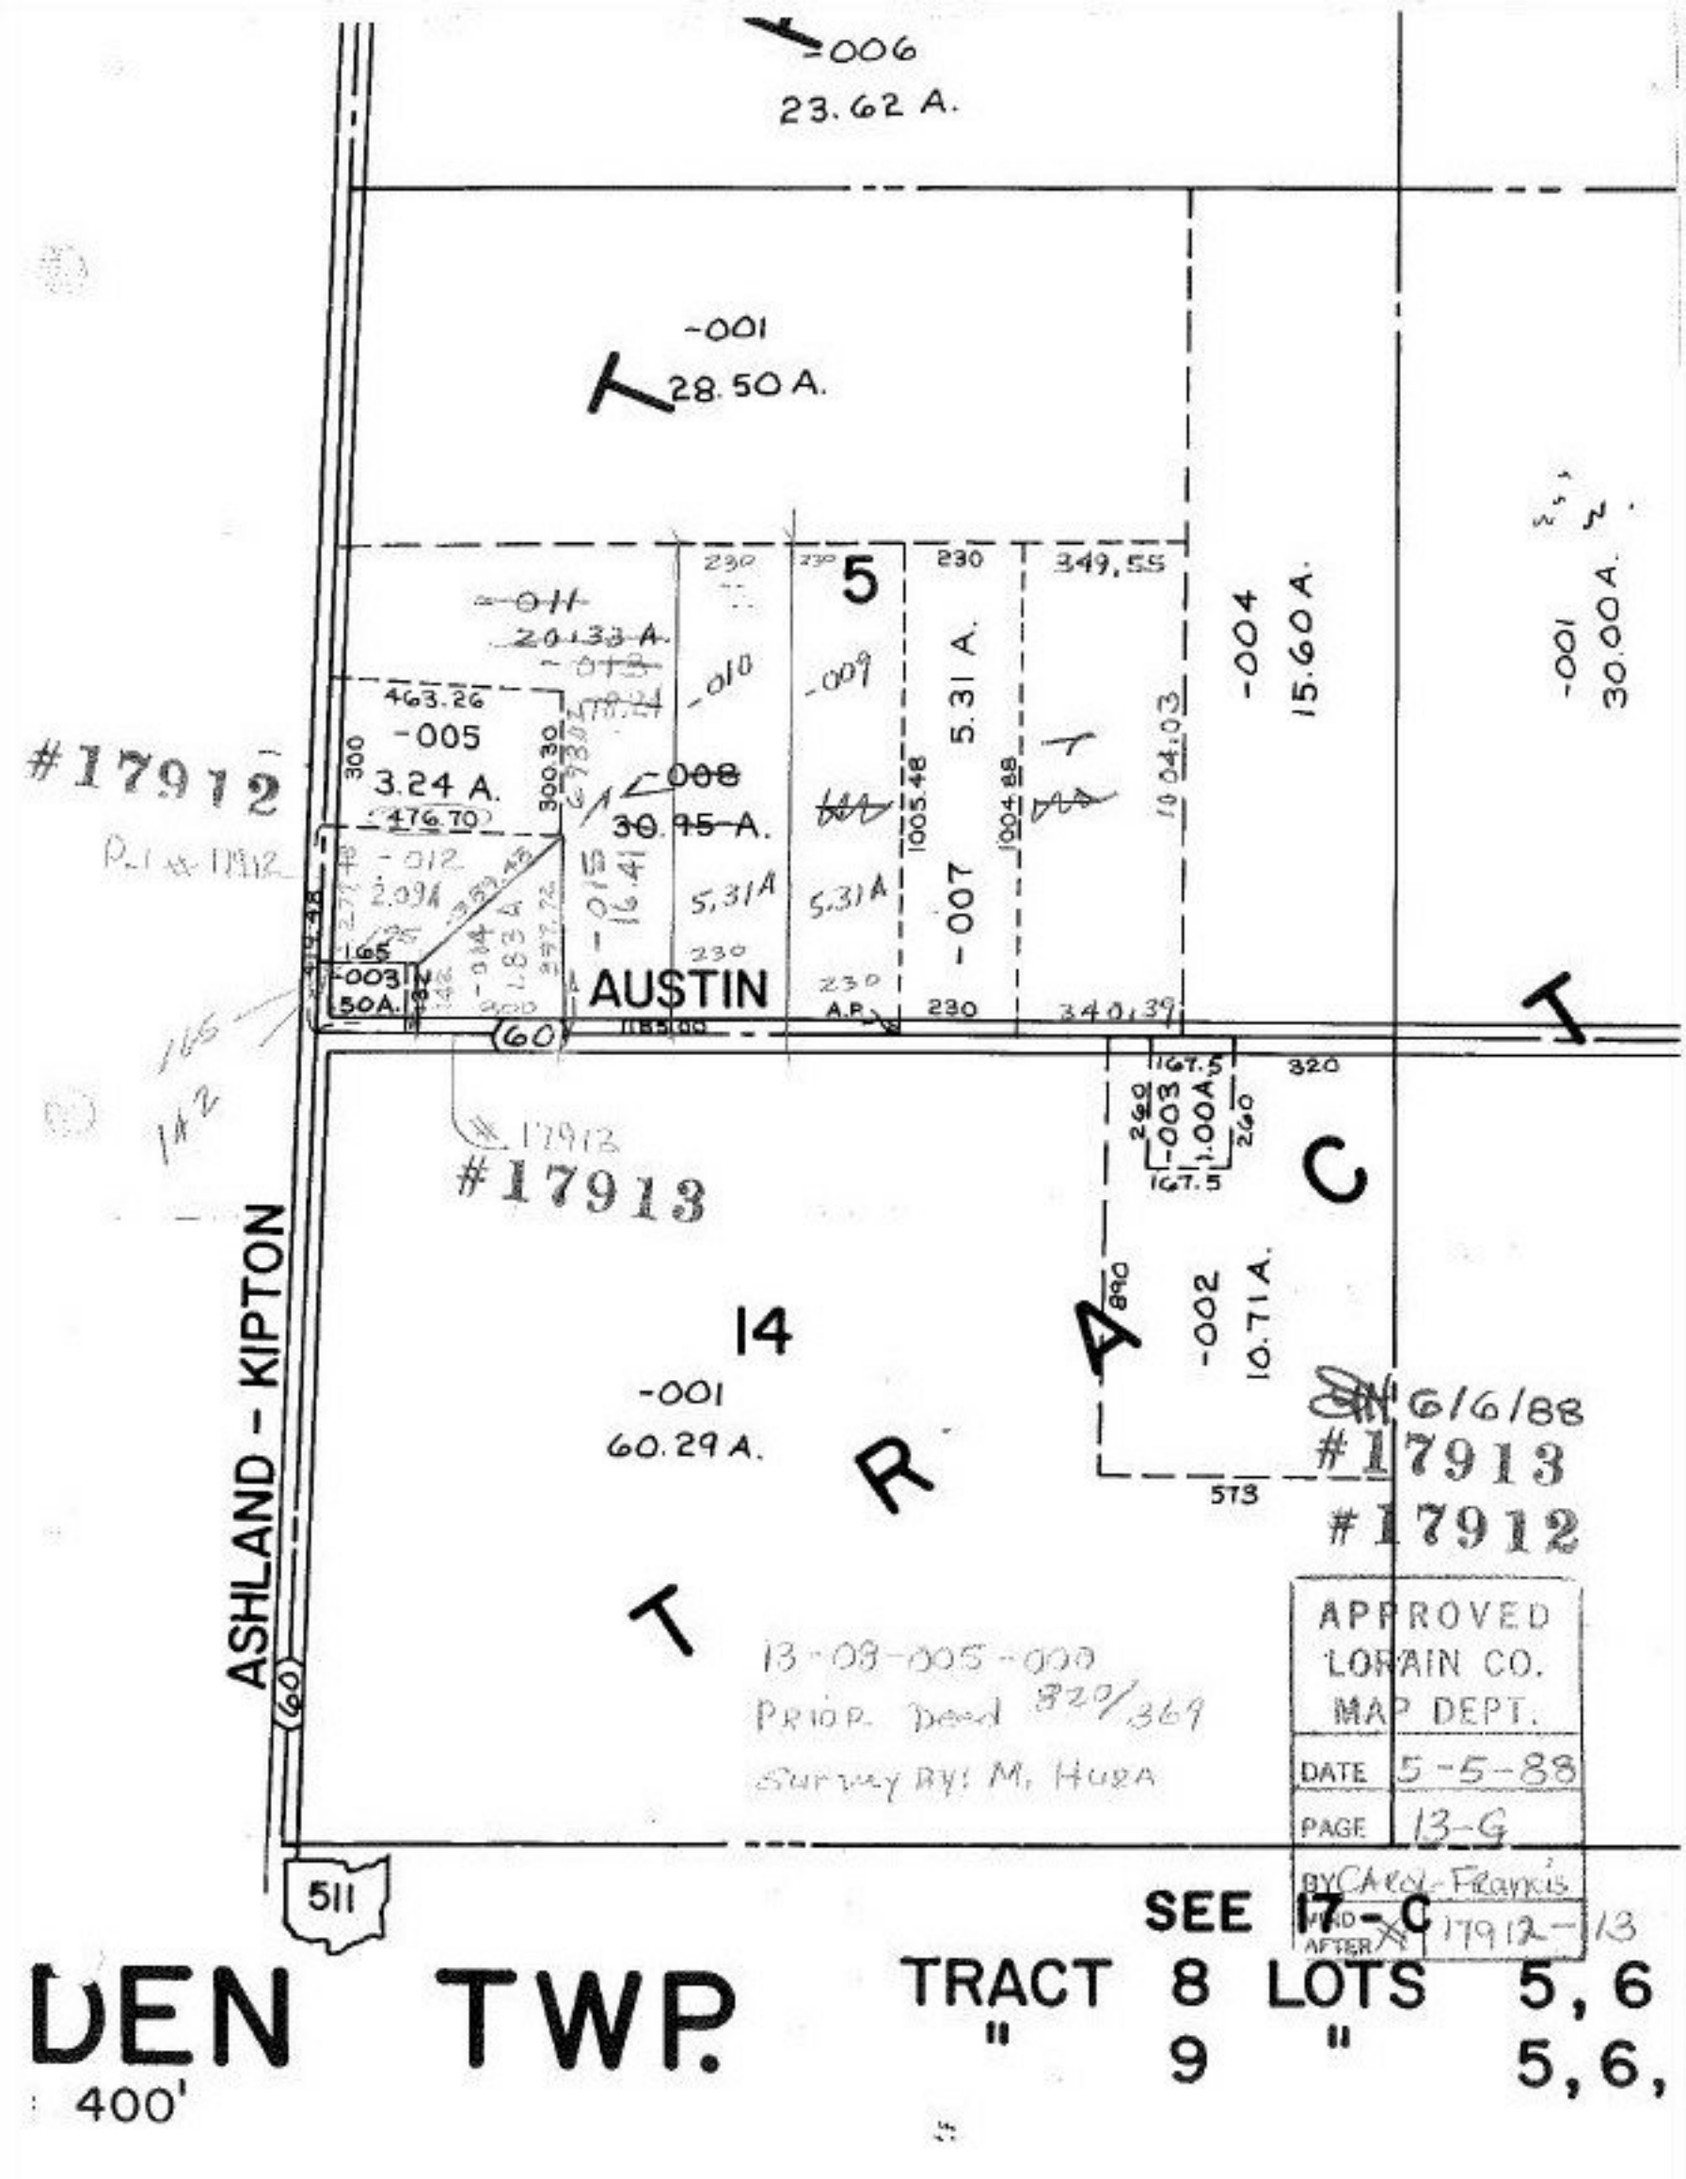
-006
23.62 A.
-001
28.50 A.
-011
20.33 A.
-010
-009
-005
3.24 A.
-008
30.95 A.
-012
2.09A
-015
16.41
-004
15.60 A.
-001
30.00 A.
5
5.31 A.
-007
5.31A
5.31A
AUSTIN
-003
50A.
60
-003
1.00A.
-002
10.71 A.
14
-001
60.29 A.
ASHLAND - KIPTON
511
#17912
#17913
#17913
#17912
6/6/88
13-08-005-000
PRIOR Deed 329/369
Survey By: M. Hura
APPROVED
LORAIN CO.
MAP DEPT.
DATE 5-5-88
PAGE 13-G
BY Carol Francis
17912-13
SEE 17-C
DEN TWP.
TRACT 8 LOTS 5, 6
" 9 " 5, 6,
400'