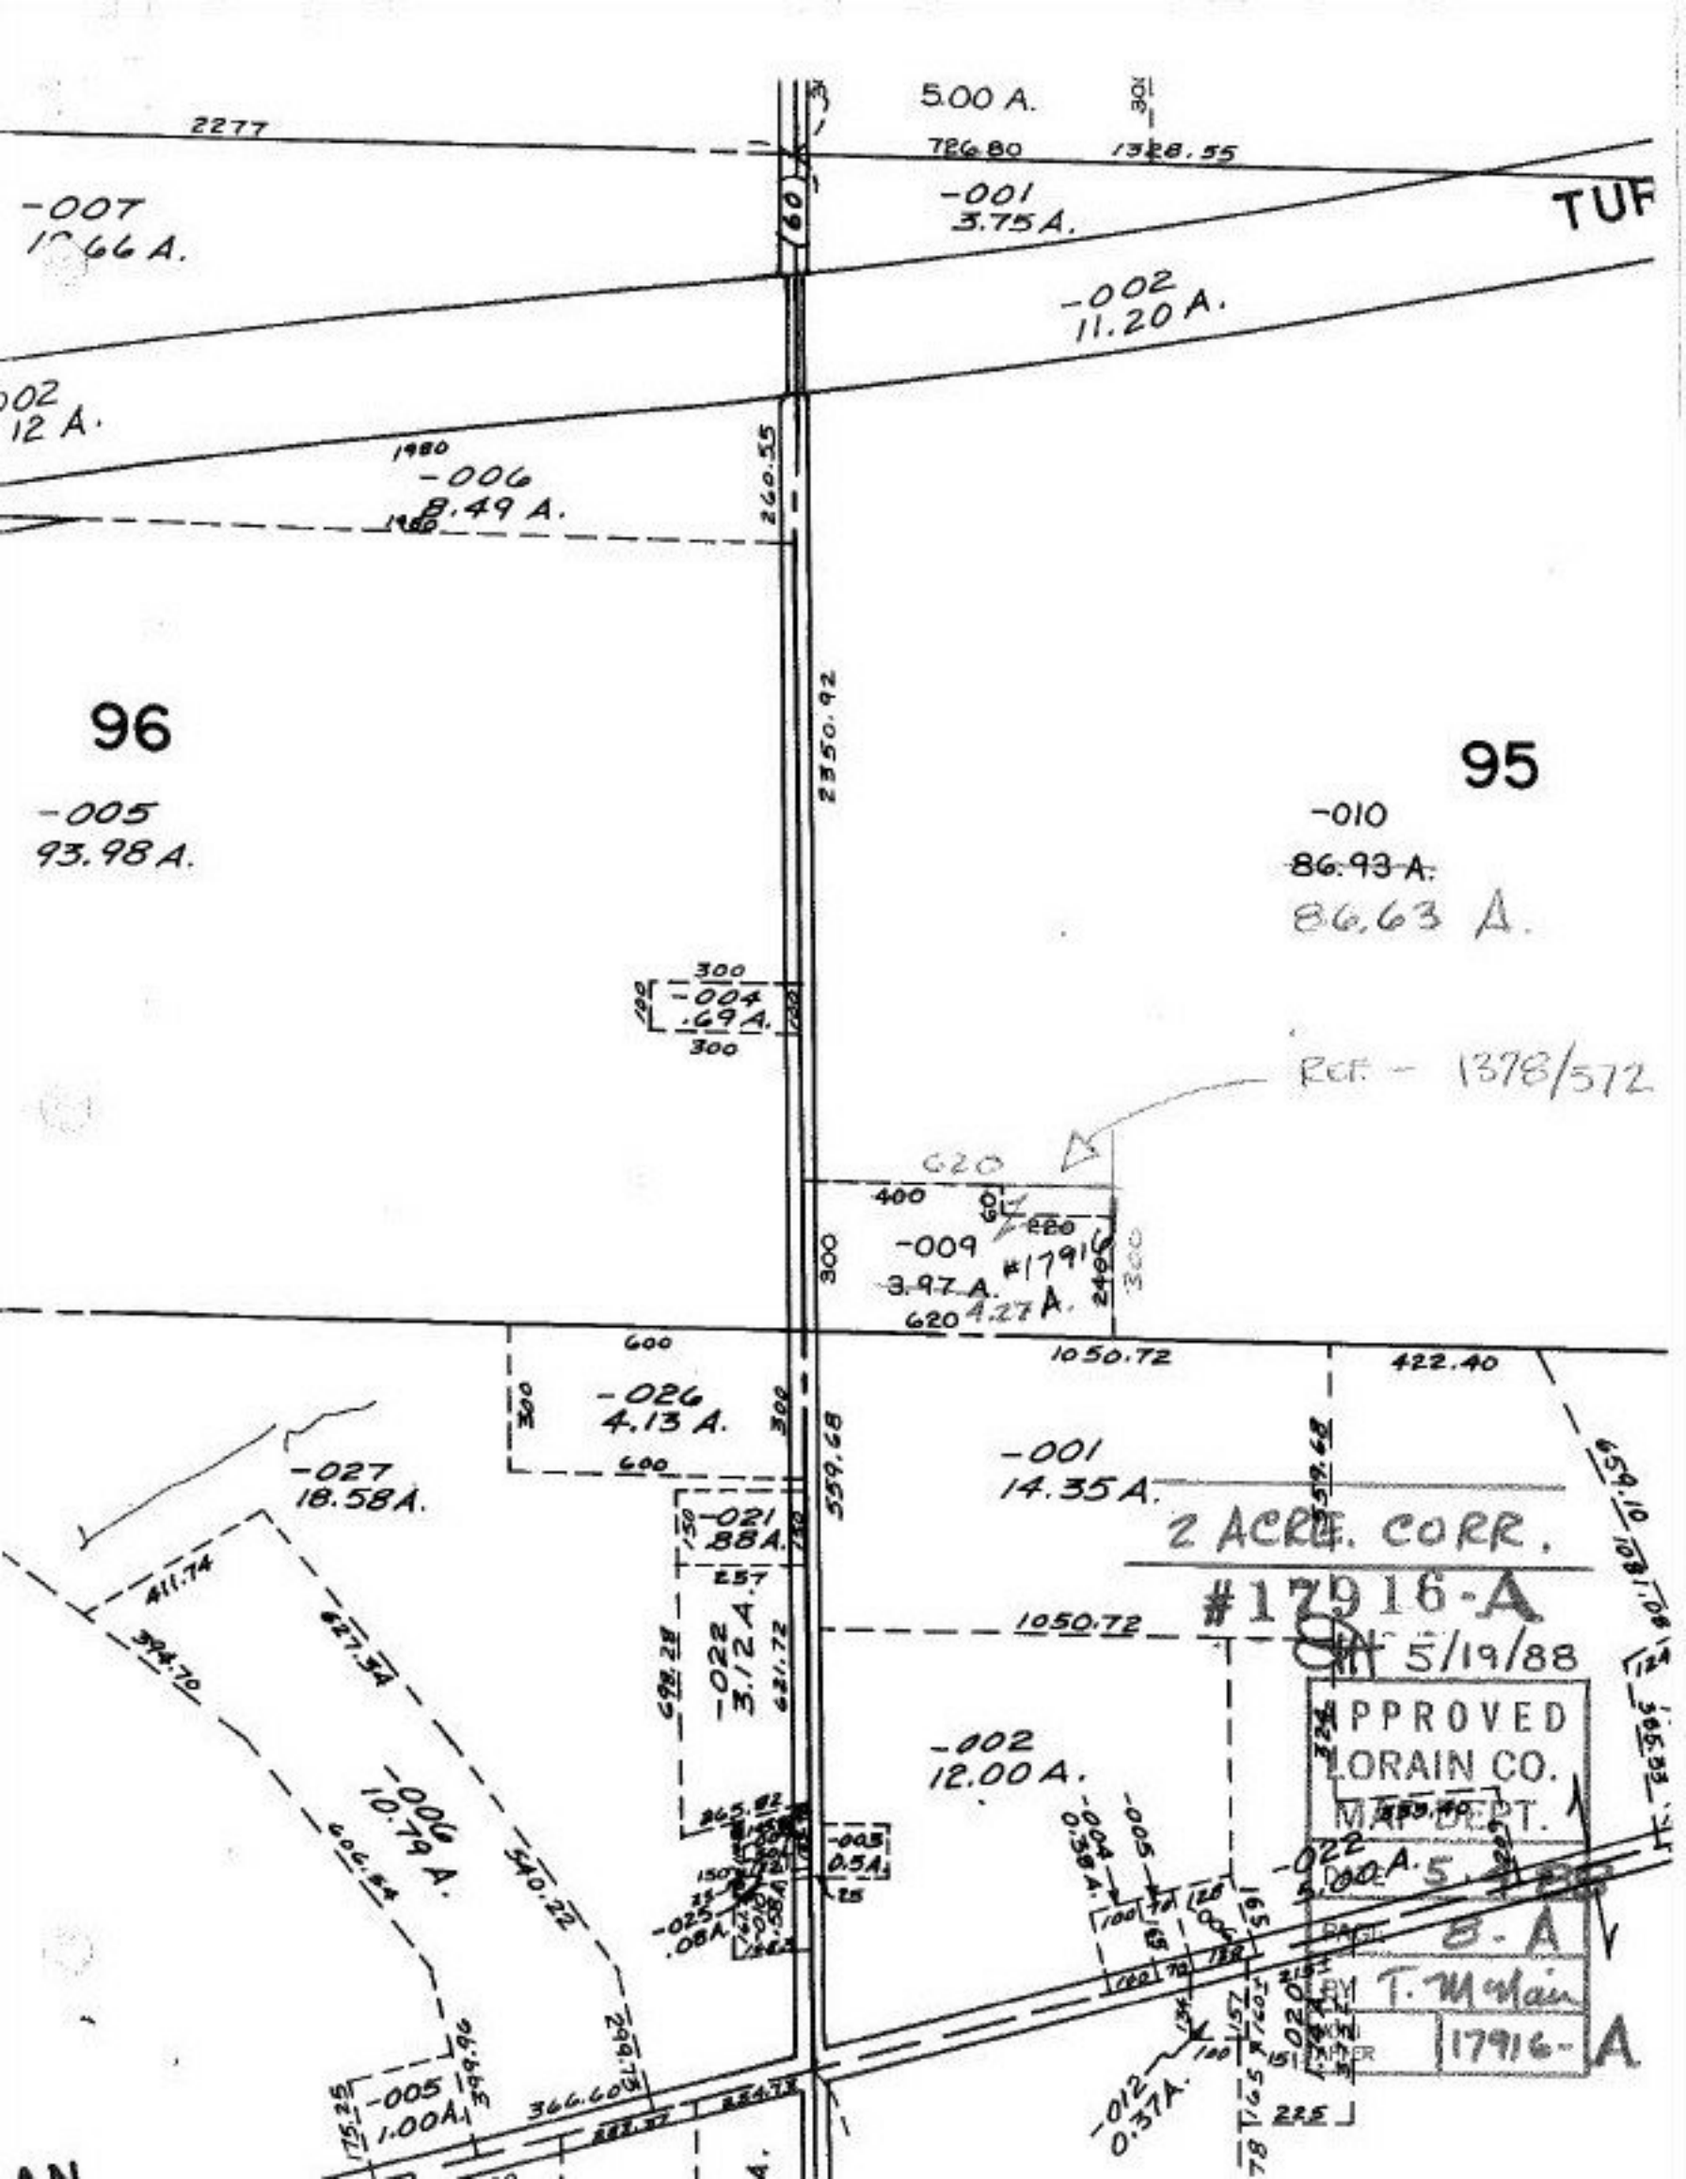

5.00 A.
2277
726.80
1328.55
-007
-001
3.75 A.
TUF
-002
11.20 A.
-006
8.49 A.
260.55
2350.92
96
95
-005
93.98 A.
-010
~~86.93 A.~~
86.63 A.
-004
.69 A.
REF - 1378/572
620
400
-009
~~3.97 A.~~
#17916
4.27 A.
1050.72
422.40
-026
4.13 A.
-027
18.58 A.
-001
14.35 A.
559.68
-021
.88 A.
2 ACRE. CORR.
#17916-A
5/19/88
-022
3.12 A.
1050.72
-002
12.00 A.
-006
10.79 A.
540.22
-005
1.00 A.
366.60
-012
0.37 A.
-022
5.00 A.
APPROVED
LORAIN CO.
MAP DEPT.
DATE 5-4-88
PAGE 8-A
BY T. McMain
17916-A