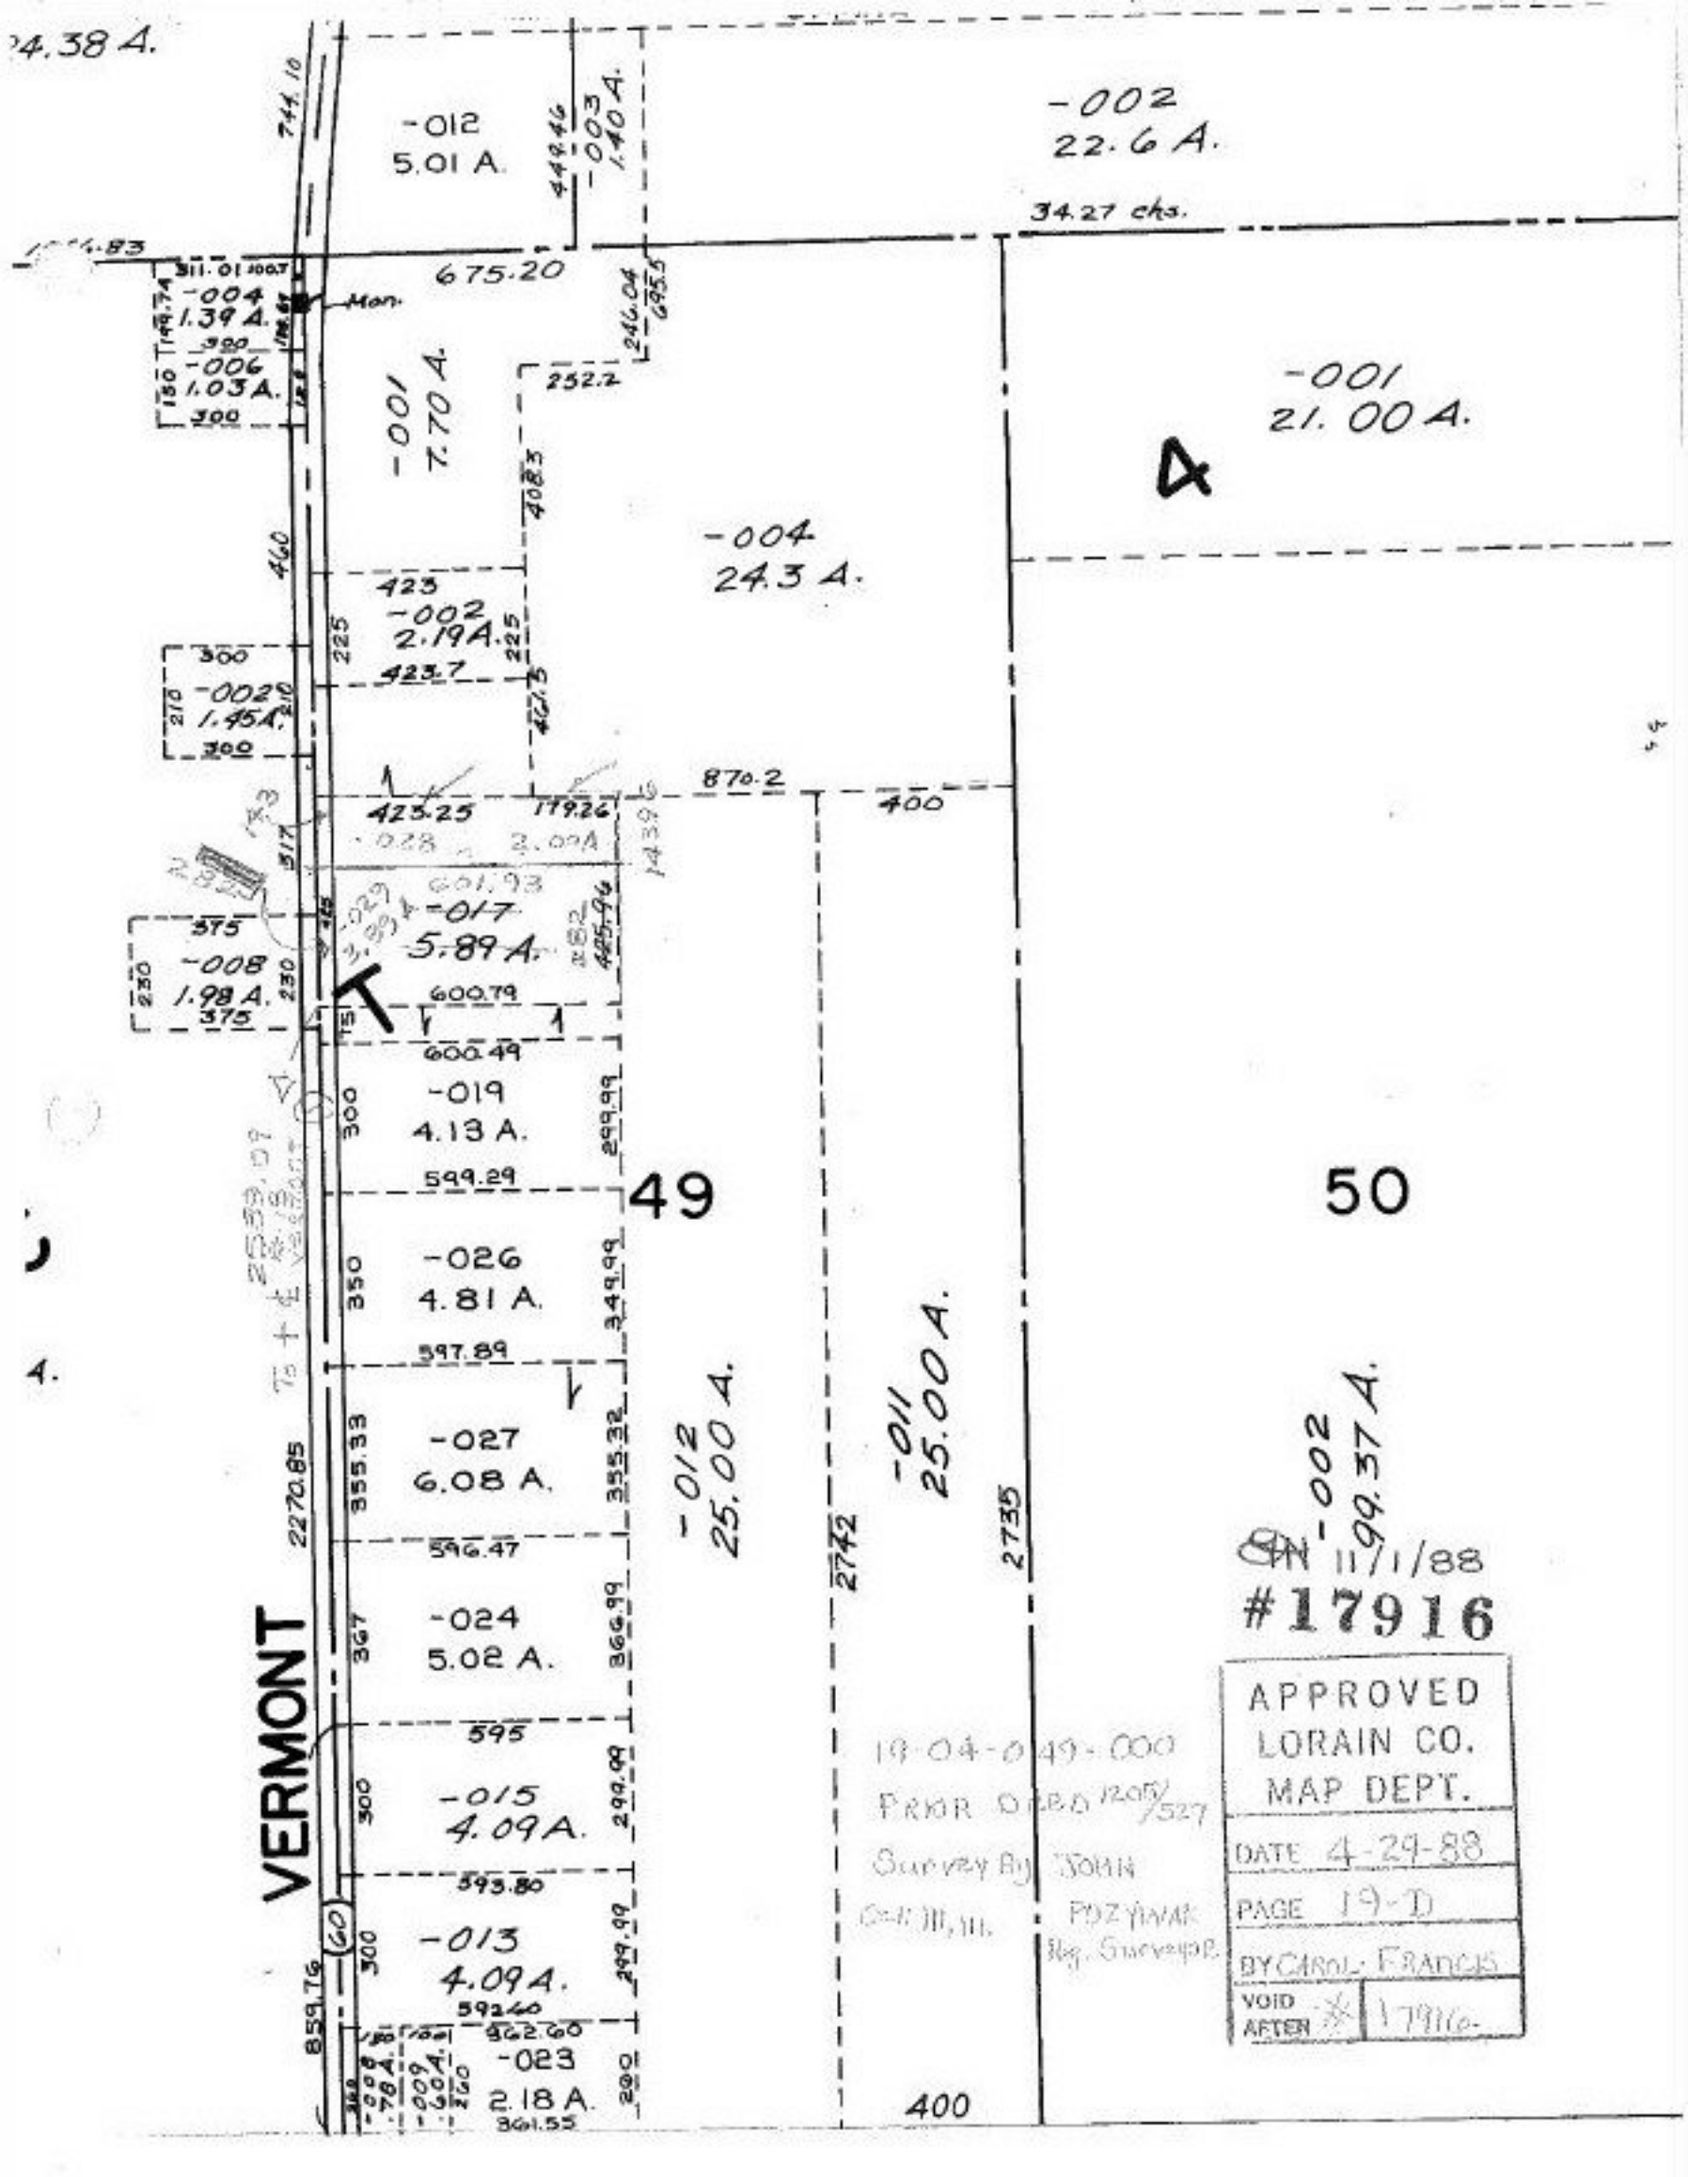

24.38 A.
-012
5.01 A.
-003
1.40 A.
-002
22.6 A.
34.27 chs.
675.20
-004
1.39 A.
Mon.
-006
1.03 A.
-001
7.70 A.
-001
21.00 A.
-004
24.3 A.
-002
2.19 A.
-002
1.45 A.
870.2
400
-017
5.89 A.
-008
1.98 A.
600.79
600.49
-019
4.13 A.
599.29
49
50
-026
4.81 A.
597.89
-027
6.08 A.
-012
25.00 A.
-011
25.00 A.
-002
99.37 A.
596.47
-024
5.02 A.
VERMONT
595
-015
4.09 A.
593.80
-013
4.09 A.
592.60
-023
2.18 A.
361.55
400
2270.85
2742
2735
19-04-049-000
PRIOR DEED 1205/527
Survey By JOHN
POZYWAK
Reg. Surveyor
11/1/88
#17916
APPROVED
LORAIN CO.
MAP DEPT.
DATE 4-29-88
PAGE 19-D
BY CAROL FRANCIS
VOID AFTER 17916