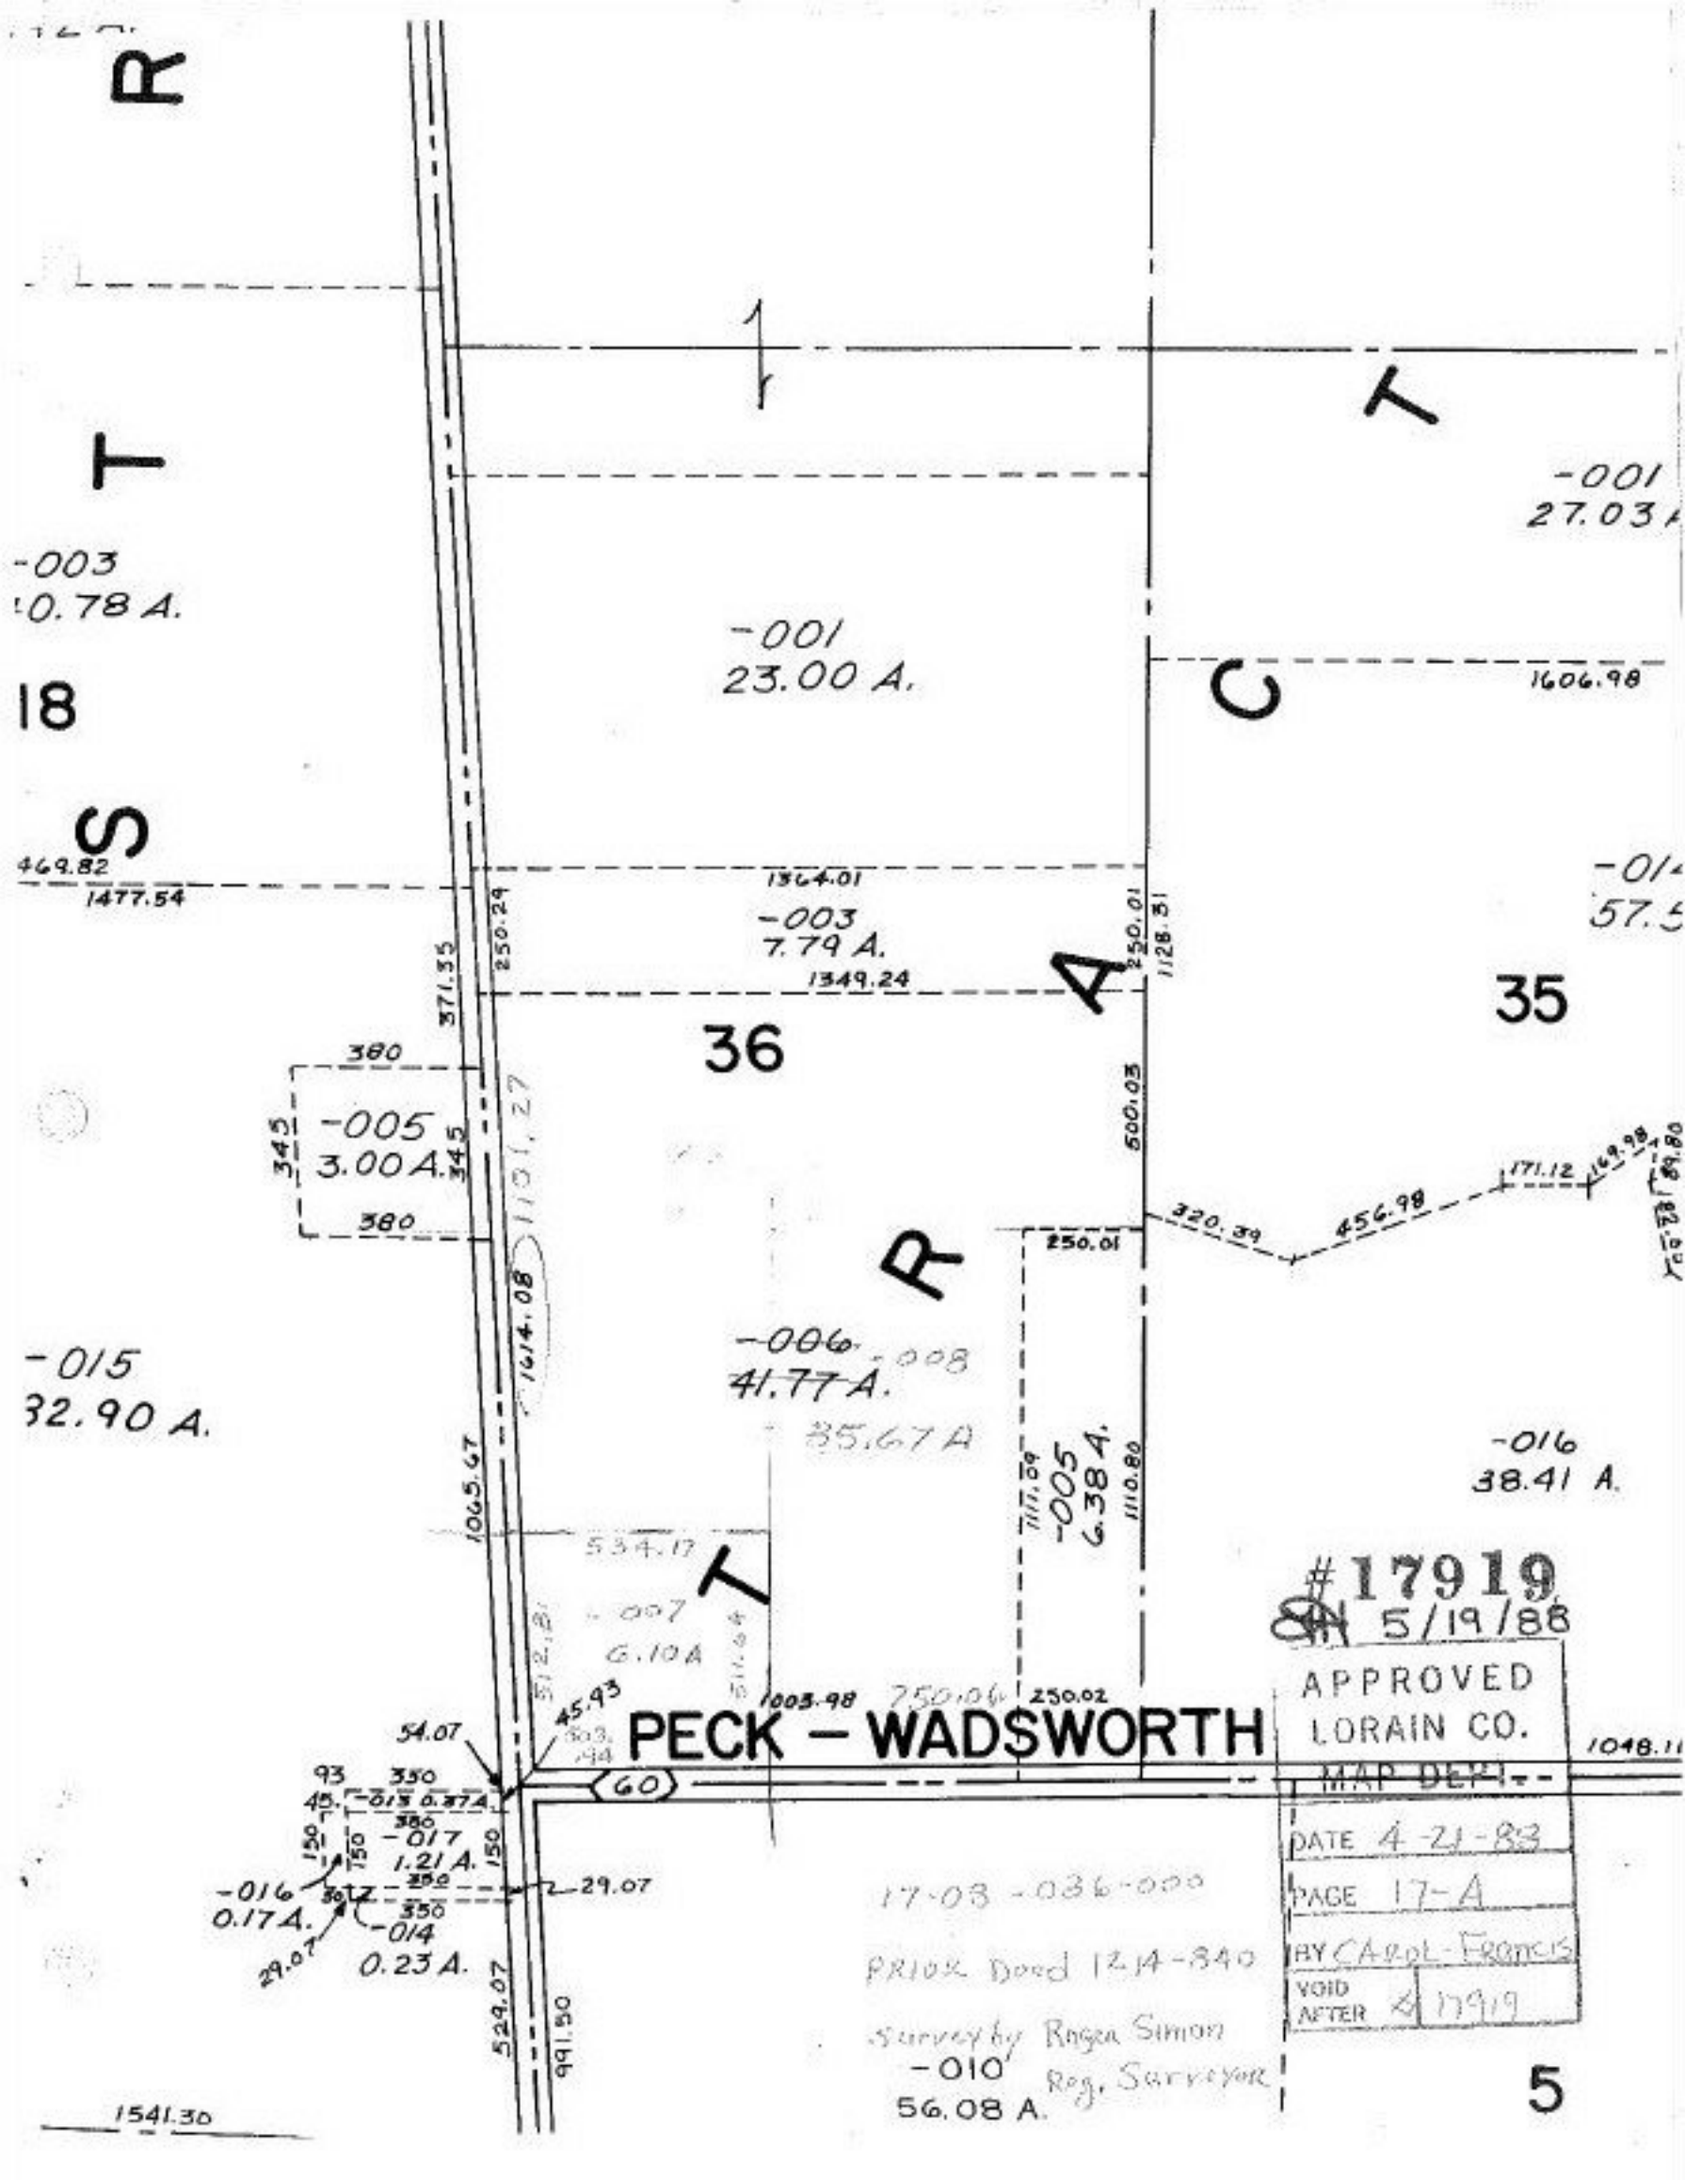

PECK – WADSWORTH
-001
23.00 A.
-003
7.79 A.
-005
3.00 A.
-006
41.77 A.
-008
35.67 A
-005
6.38 A.
-007
6.10 A
-015
32.90 A.
-016
38.41 A.
-001
27.03 A
-010
56.08 A.
-017
1.21 A.
-016
0.17 A.
-014
0.23 A.
36
35
18
5
1606.98
1364.01
1349.24
1477.54
469.82
1541.30
1048.11
1003.98
750.06
250.02
250.01
1128.31
500.03
320.39
456.98
171.12
169.98
1110.80
1111.09
1065.67
1614.08
1101.27
371.35
250.29
380
345
534.17
512.81
511.64
54.07
45.93
29.07
529.07
991.50
17-03-036-000
PRIOR Deed 1214-840
Survey by Roger Simon
Reg. Surveyor
#17919
5/19/88
APPROVED
LORAIN CO.
MAP DEPT.
DATE 4-21-83
PAGE 17-A
BY CAROL FRANCIS
VOID AFTER 17919