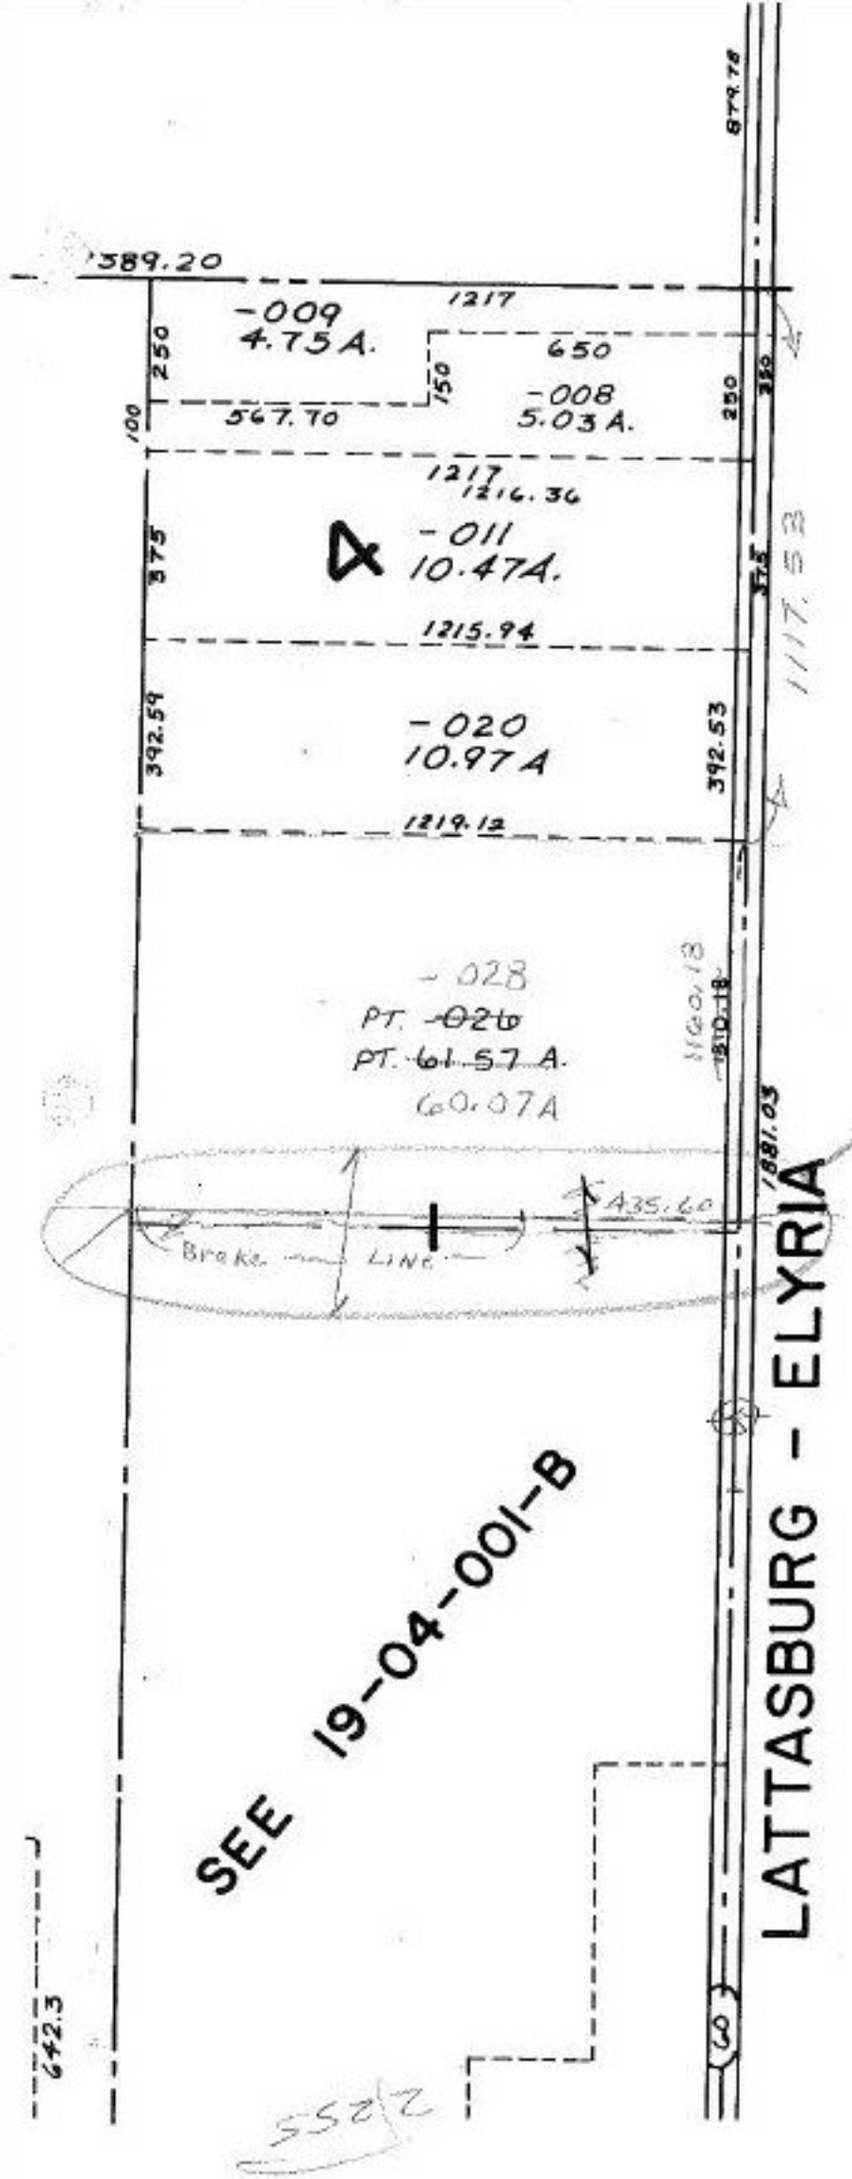

DISREGARD
DATE DUE
ANYTHING

19-04-001-000

5/19/88
#17923

APPROVED
LORAIN CO.
MAP DEPT.
DATE 4-25-88
PAGE 19-B
BY CAROL-FRANCIS
VOID AFTER # 17923