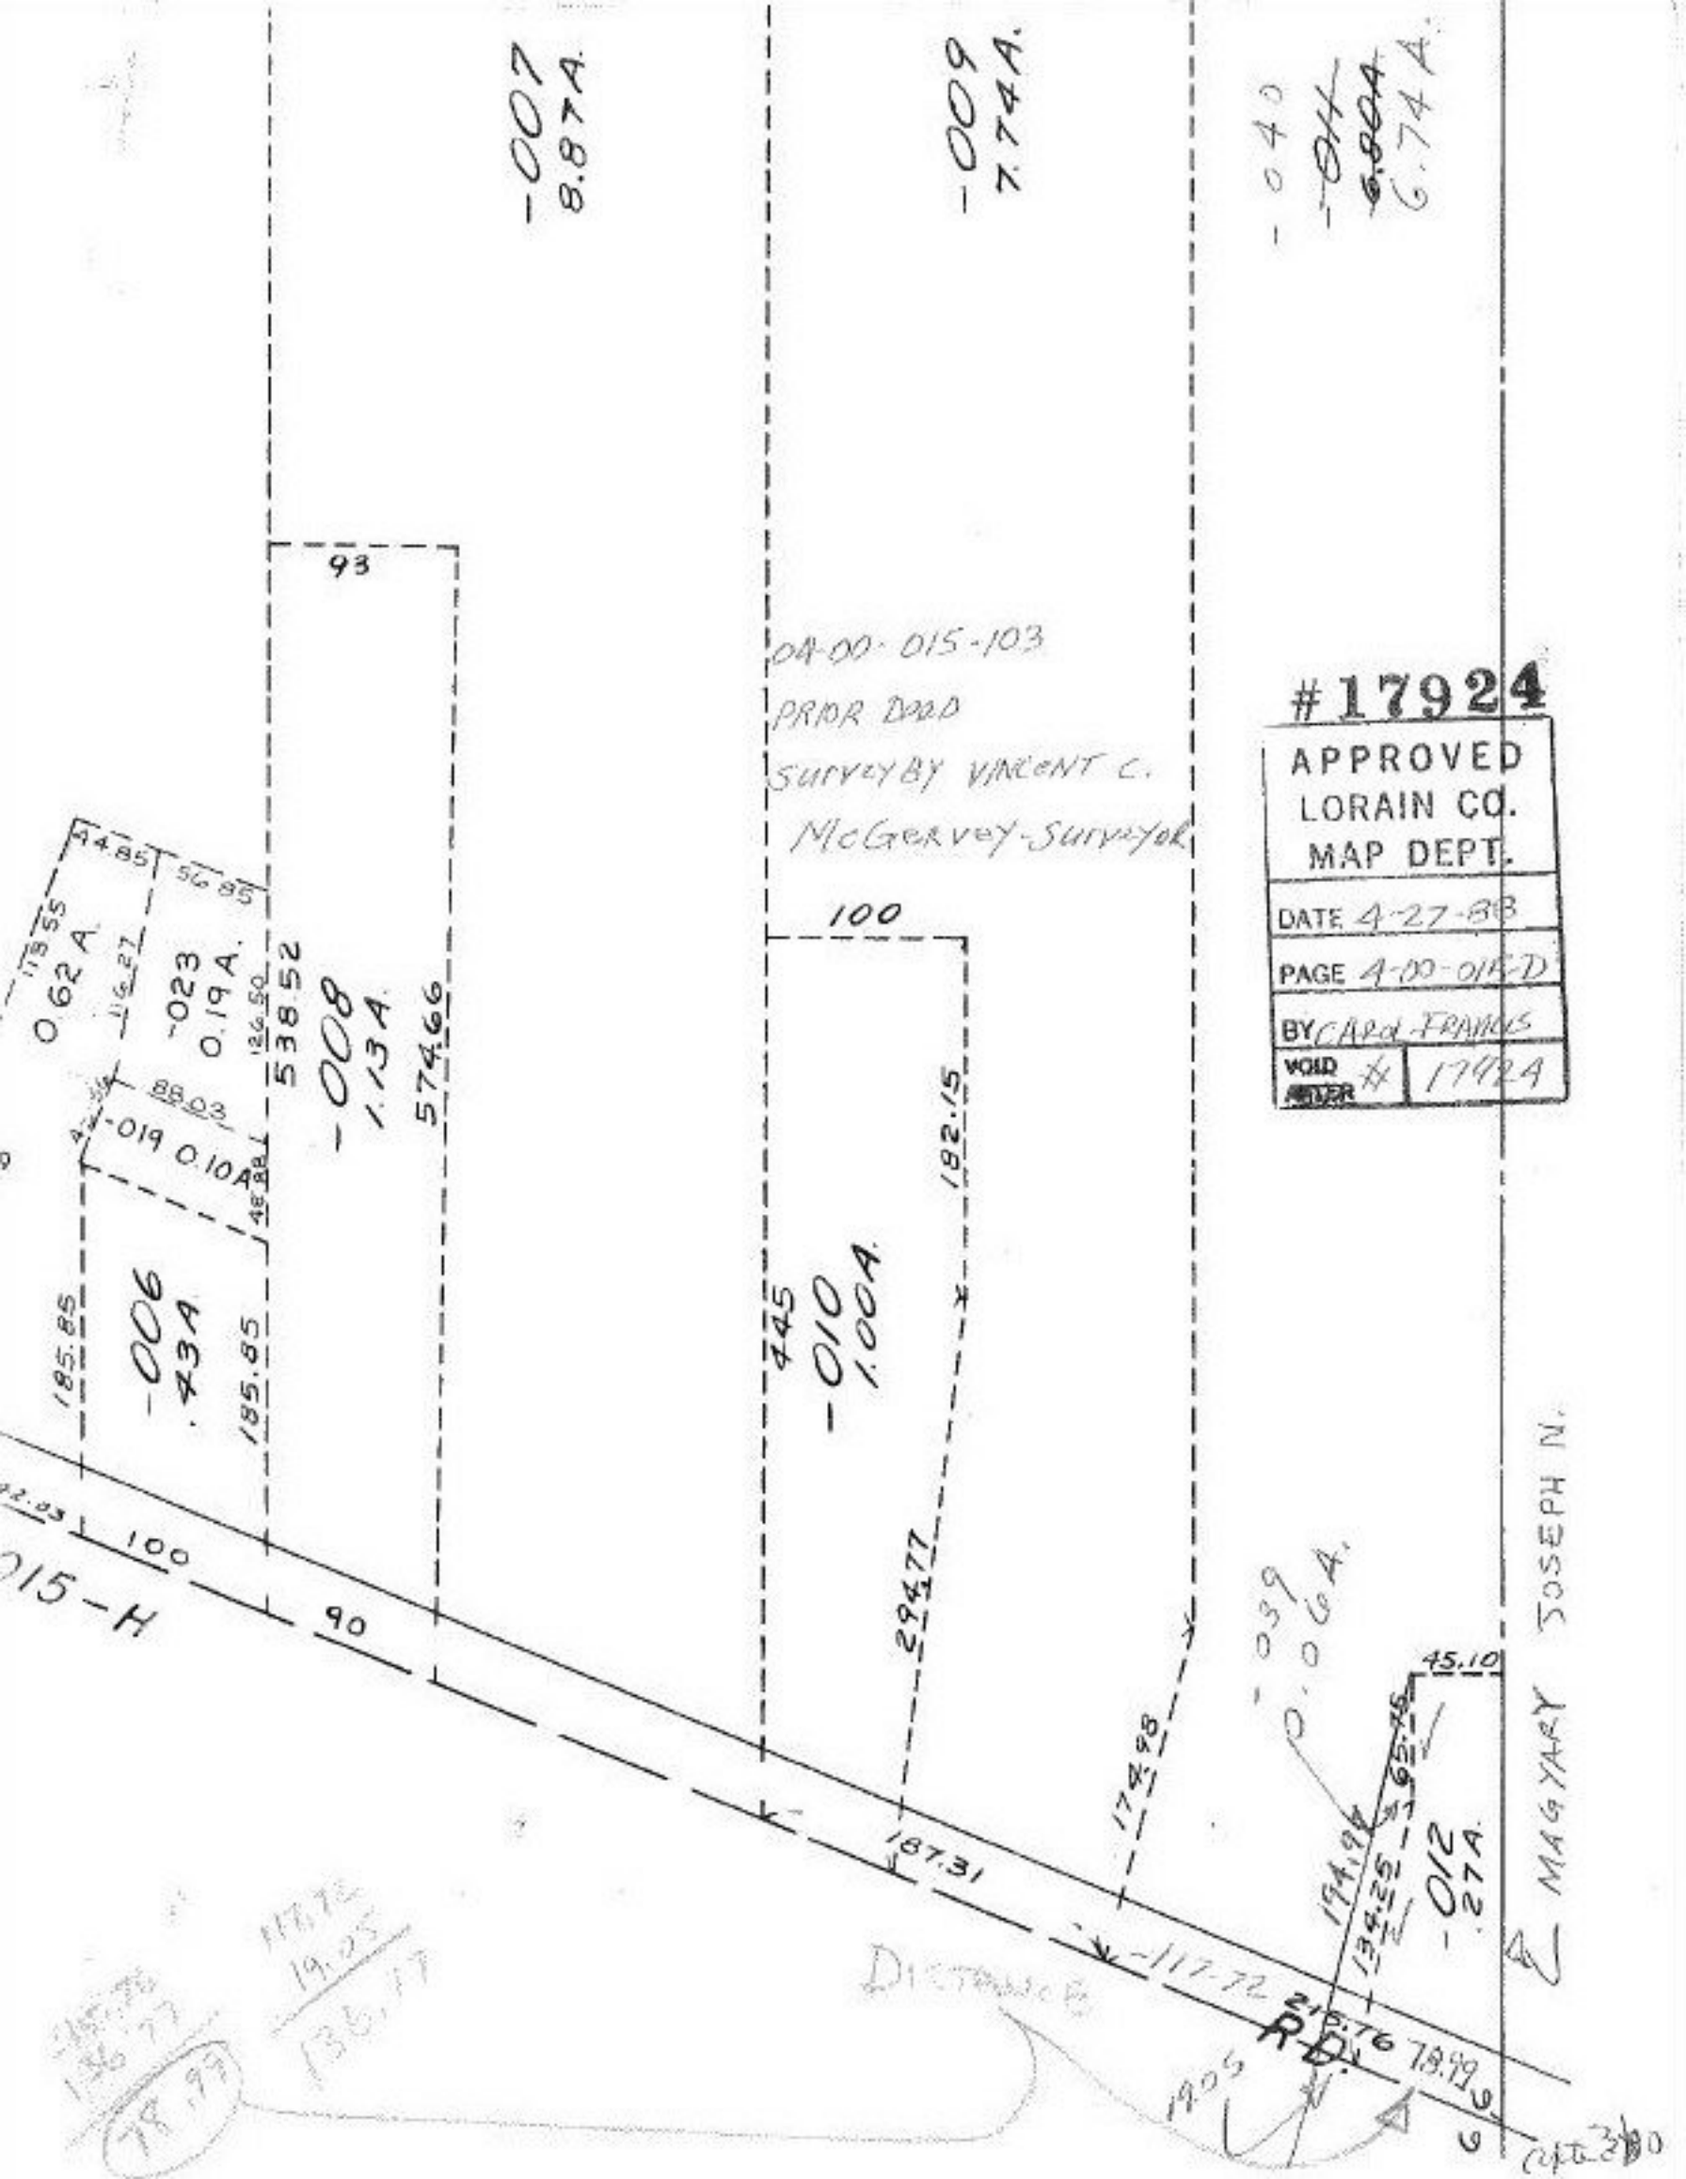
-007
8.87A.
-009
7.74A.
-040
-041
6.74A.
93
04-00-015-103
PRIOR DEED
SURVEY BY VINCENT C.
McGERVEY-SURVEYOR
#17924
APPROVED
LORAIN CO.
MAP DEPT.
DATE 4-27-88
PAGE 4-00-015-D
BY CAROL FRANKS
VOID AFTER # 17924
-023
0.19A.
-008
1.13A.
538.52
574.66
-019 0.10A.
-006
.43A.
0.62A.
100
-010
1.00A.
182.15
294.77
745
187.31
174.98
-039
0.06A.
45.10
-012
.27A.
194.98
134.25
117.72
MAGYARY
JOSEPH N.
90
015-H