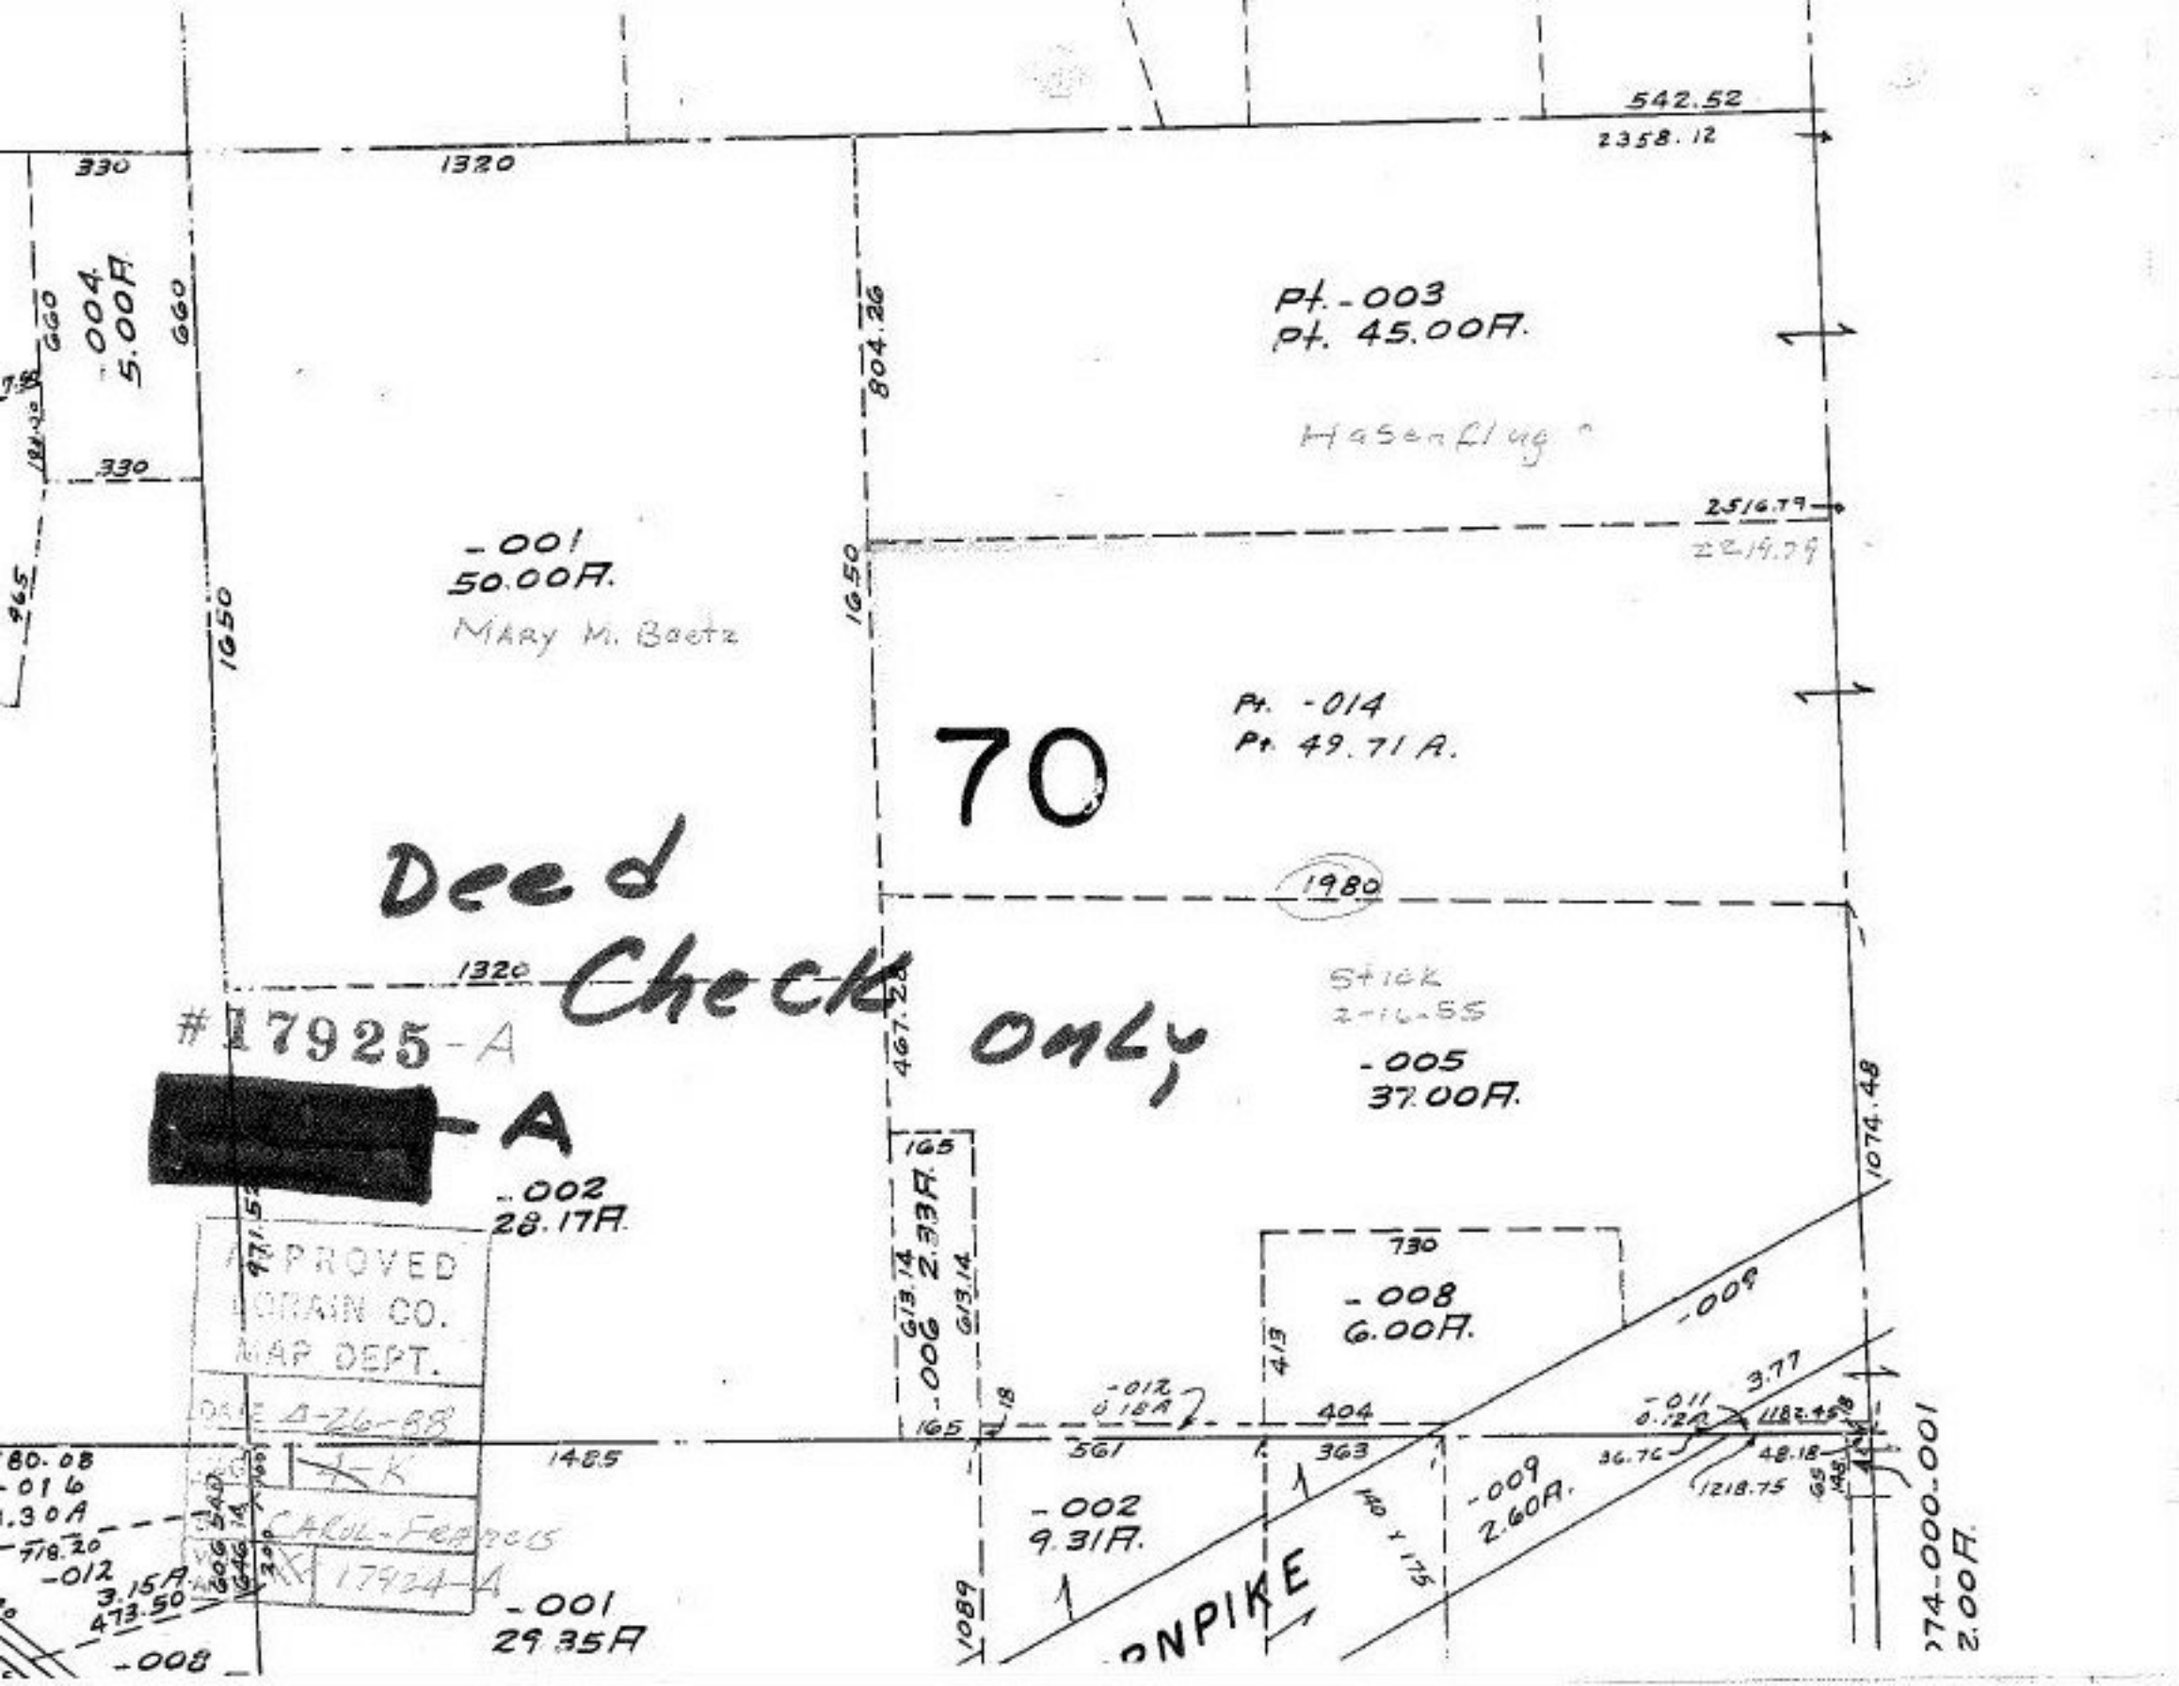

542.52
2358.12
330
1320
.004
5.00A
660
804.26
Pt. -003
Pt. 45.00A.
Hasenflug
2516.79
2219.79
-001
50.00A.
Mary M. Baetz
1650
Pt. -014
Pt. 49.71 A.
70
Deed Check Only
1980
1320
Stick
2-16-55
#17925-A
[redacted]-A
467.28
-005
37.00A.
1074.48
165
-002
28.17A.
APPROVED
LORAIN CO.
MAP DEPT.
DATE 4-26-88
CAROL-FRANCIS
17924-A
730
-008
6.00A.
-009
413
-012
0.18A
404
-011
0.12A
3.77
1182.45
36.76
48.18
1218.75
1485
561
363
-002
9.31A.
-009
2.60A.
140 x 175
1089
-001
29.35A
-008
-012
3.15A
473.50
718.20