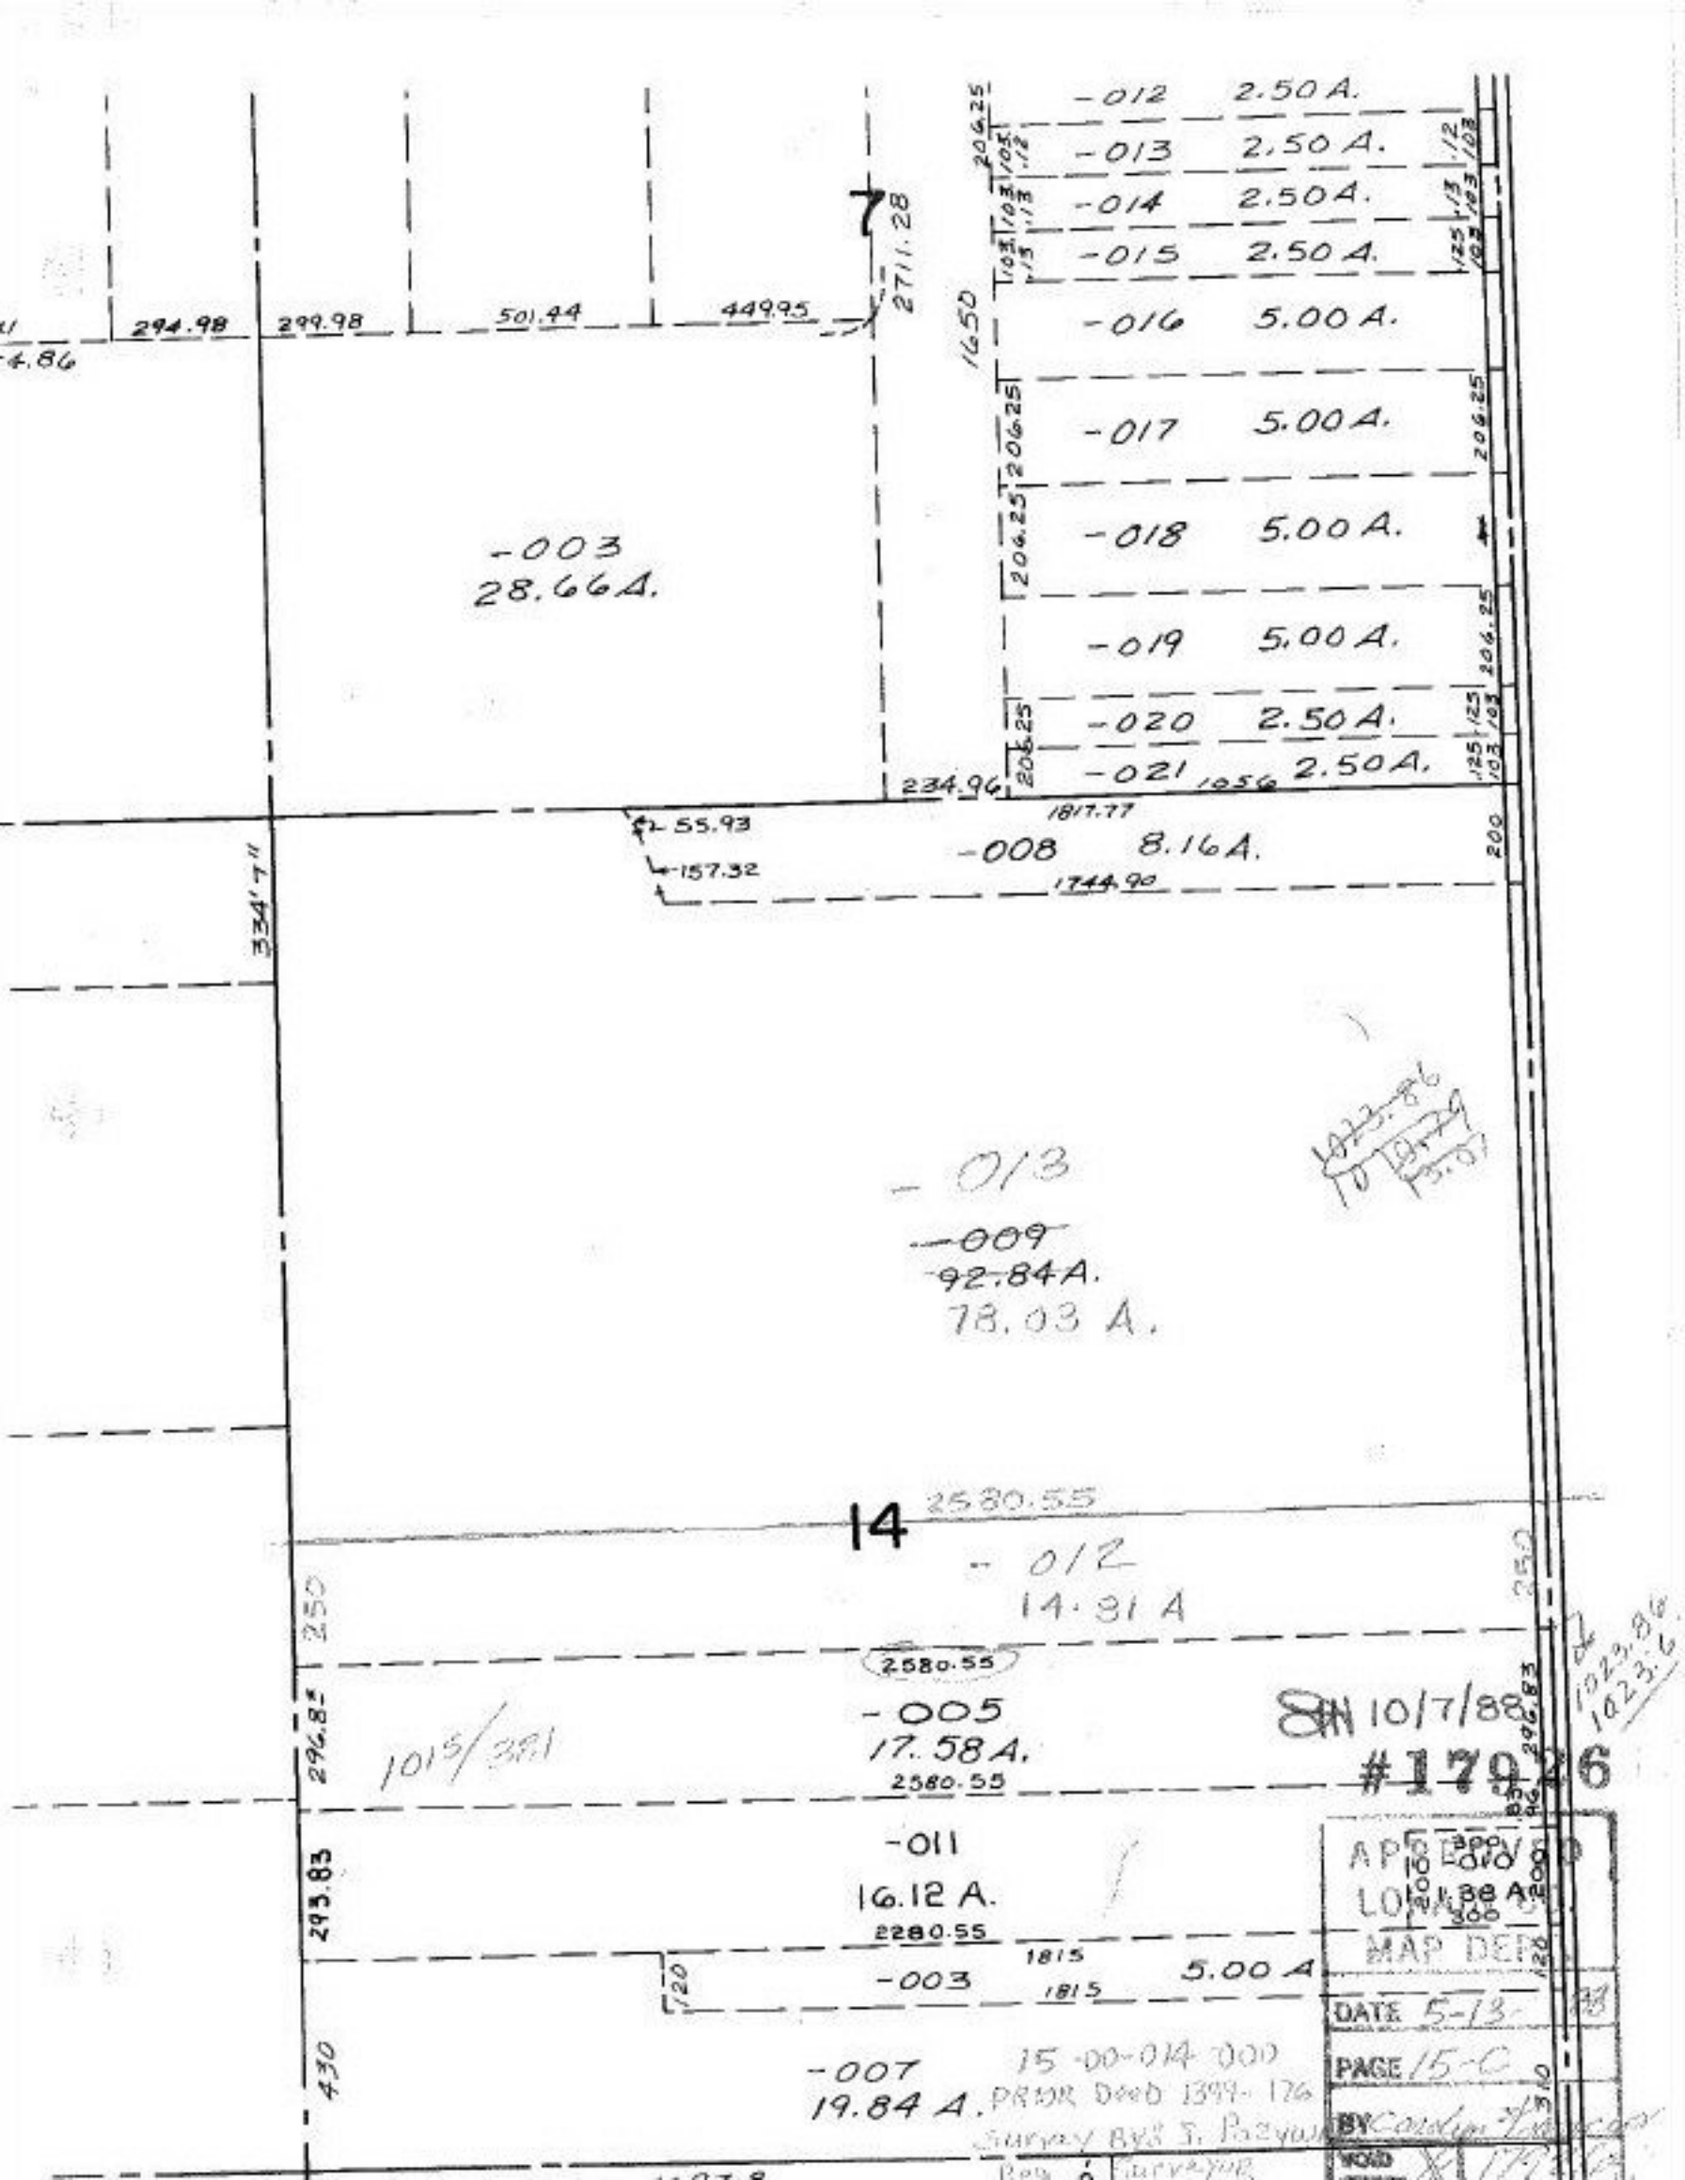

-012 2.50 A.
-013 2.50 A.
-014 2.50 A.
-015 2.50 A.
-016 5.00 A.
-017 5.00 A.
-018 5.00 A.
-019 5.00 A.
-020 2.50 A.
-021 2.50 A.
7
2711.28
1650
294.98
299.98
501.44
449.95
-003
28.66 A.
234.96
1817.77
55.93
157.32
-008 8.16 A.
1744.90
334'7"
-013
-009
92.84 A.
78.03 A.
14
2580.55
-012
14.81 A
250
2580.55
-005
17.58 A.
2580.55
1015/381
296.83
-011
16.12 A.
2280.55
293.83
-003
1815
5.00 A
1815
430
-007
19.84 A.
15-00-014-000
PRIOR DEED 1399-176
Survey By: J. Pazyuk
Reg. Surveyor
8 IN 10/7/88
#17926
APPROVED
LOCATION
MAP DEPT.
DATE 5-13-88
PAGE 15-C
BY
VOID