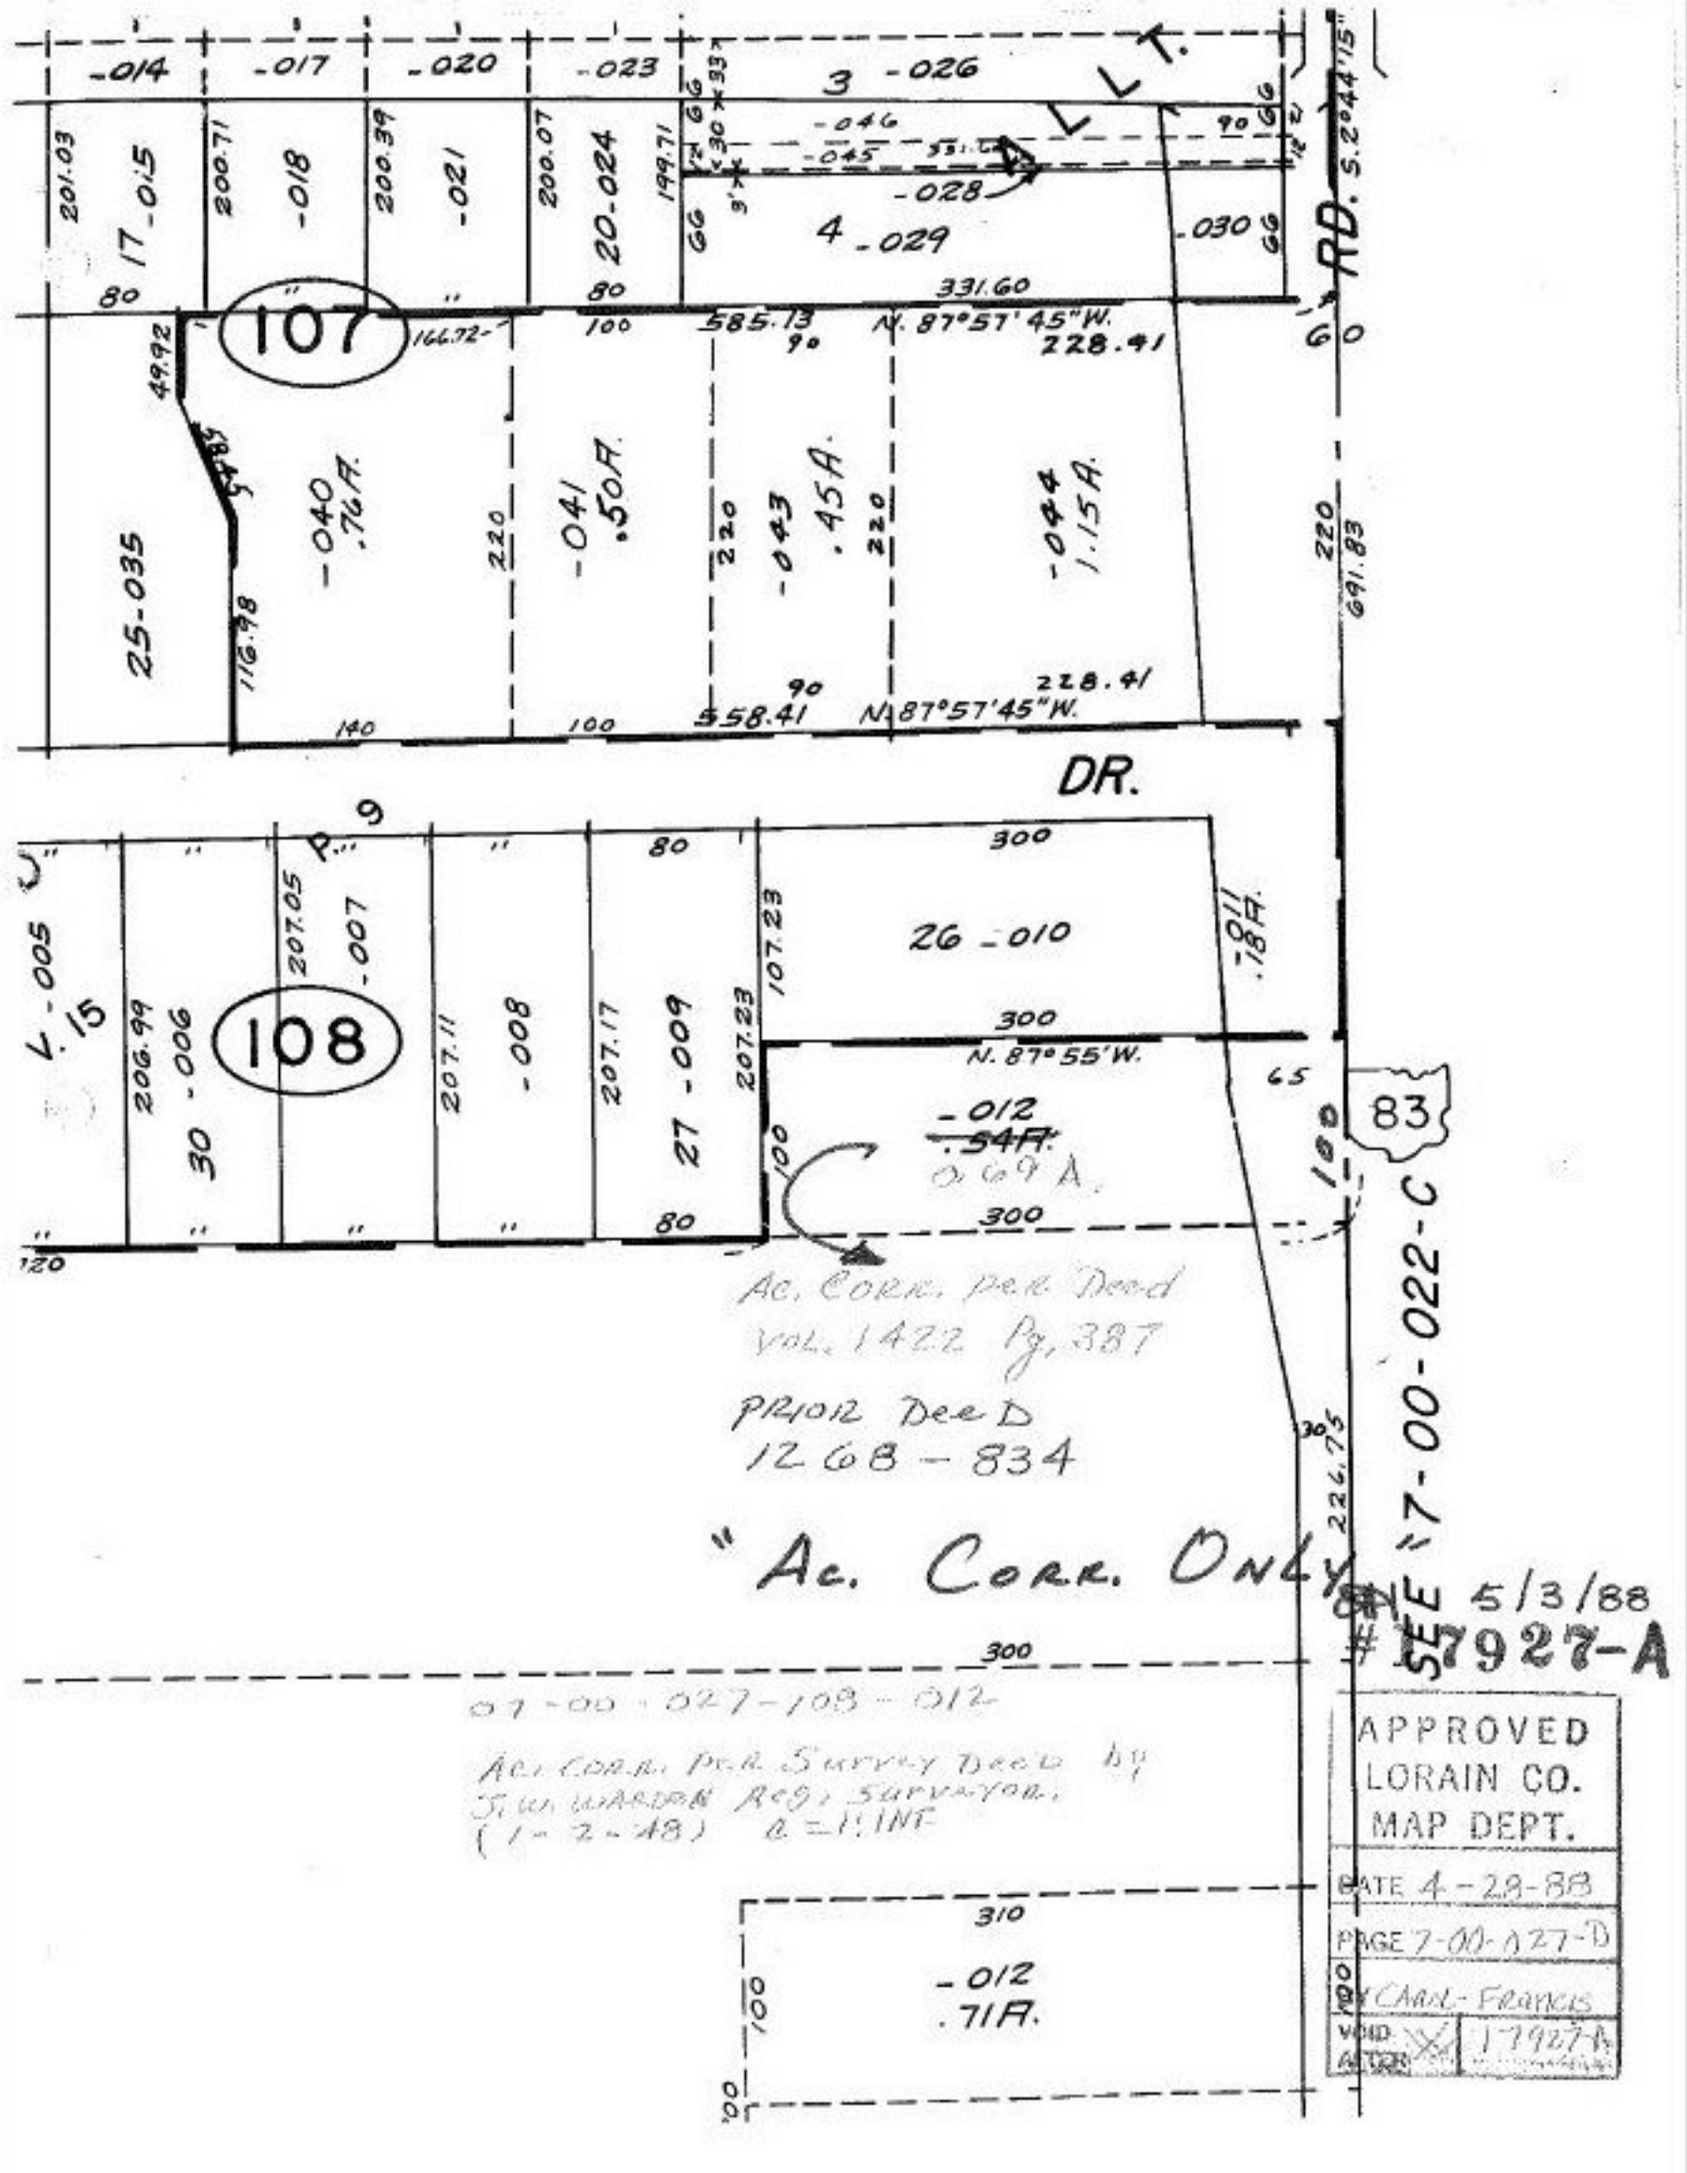
-014
-017
-020
-023
3 -026
L.L.
-046
-045
-028
4 -029
-030
RD.
S.2°44'15"
331.60
585.13
N. 87°57'45"W.
228.41
107
17 -015
-018
-021
20-024
25-035
-040 .76A.
-041 .50A.
-043 .45A.
-044 1.15A.
691.83
DR.
558.41
N.87°57'45"W.
108
-005
-007
-006
30
-008
27 -009
26 -010
-011 .18A.
N. 87°55'W.
-012 .54A. 0.69 A.
83
Ac. Corr. per Deed
Vol. 1422 Pg. 337
Prior Deed
1268 - 834
"Ac. Corr. Only"
SEE 7-00-022-C
5/3/88
#17927-A
07-00-027-108-012
Ac. Corr. per Survey Deed by
S. W. Warden Reg. Surveyor.
(1-2-48) @ = 11 INT.
-012
.71A.
APPROVED
LORAIN CO.
MAP DEPT.
DATE 4-28-88
PAGE 7-00-027-D
BY CHAR-FRANCIS
VOID
ACTIVE
17927-A