8.88
-0.82
8.06

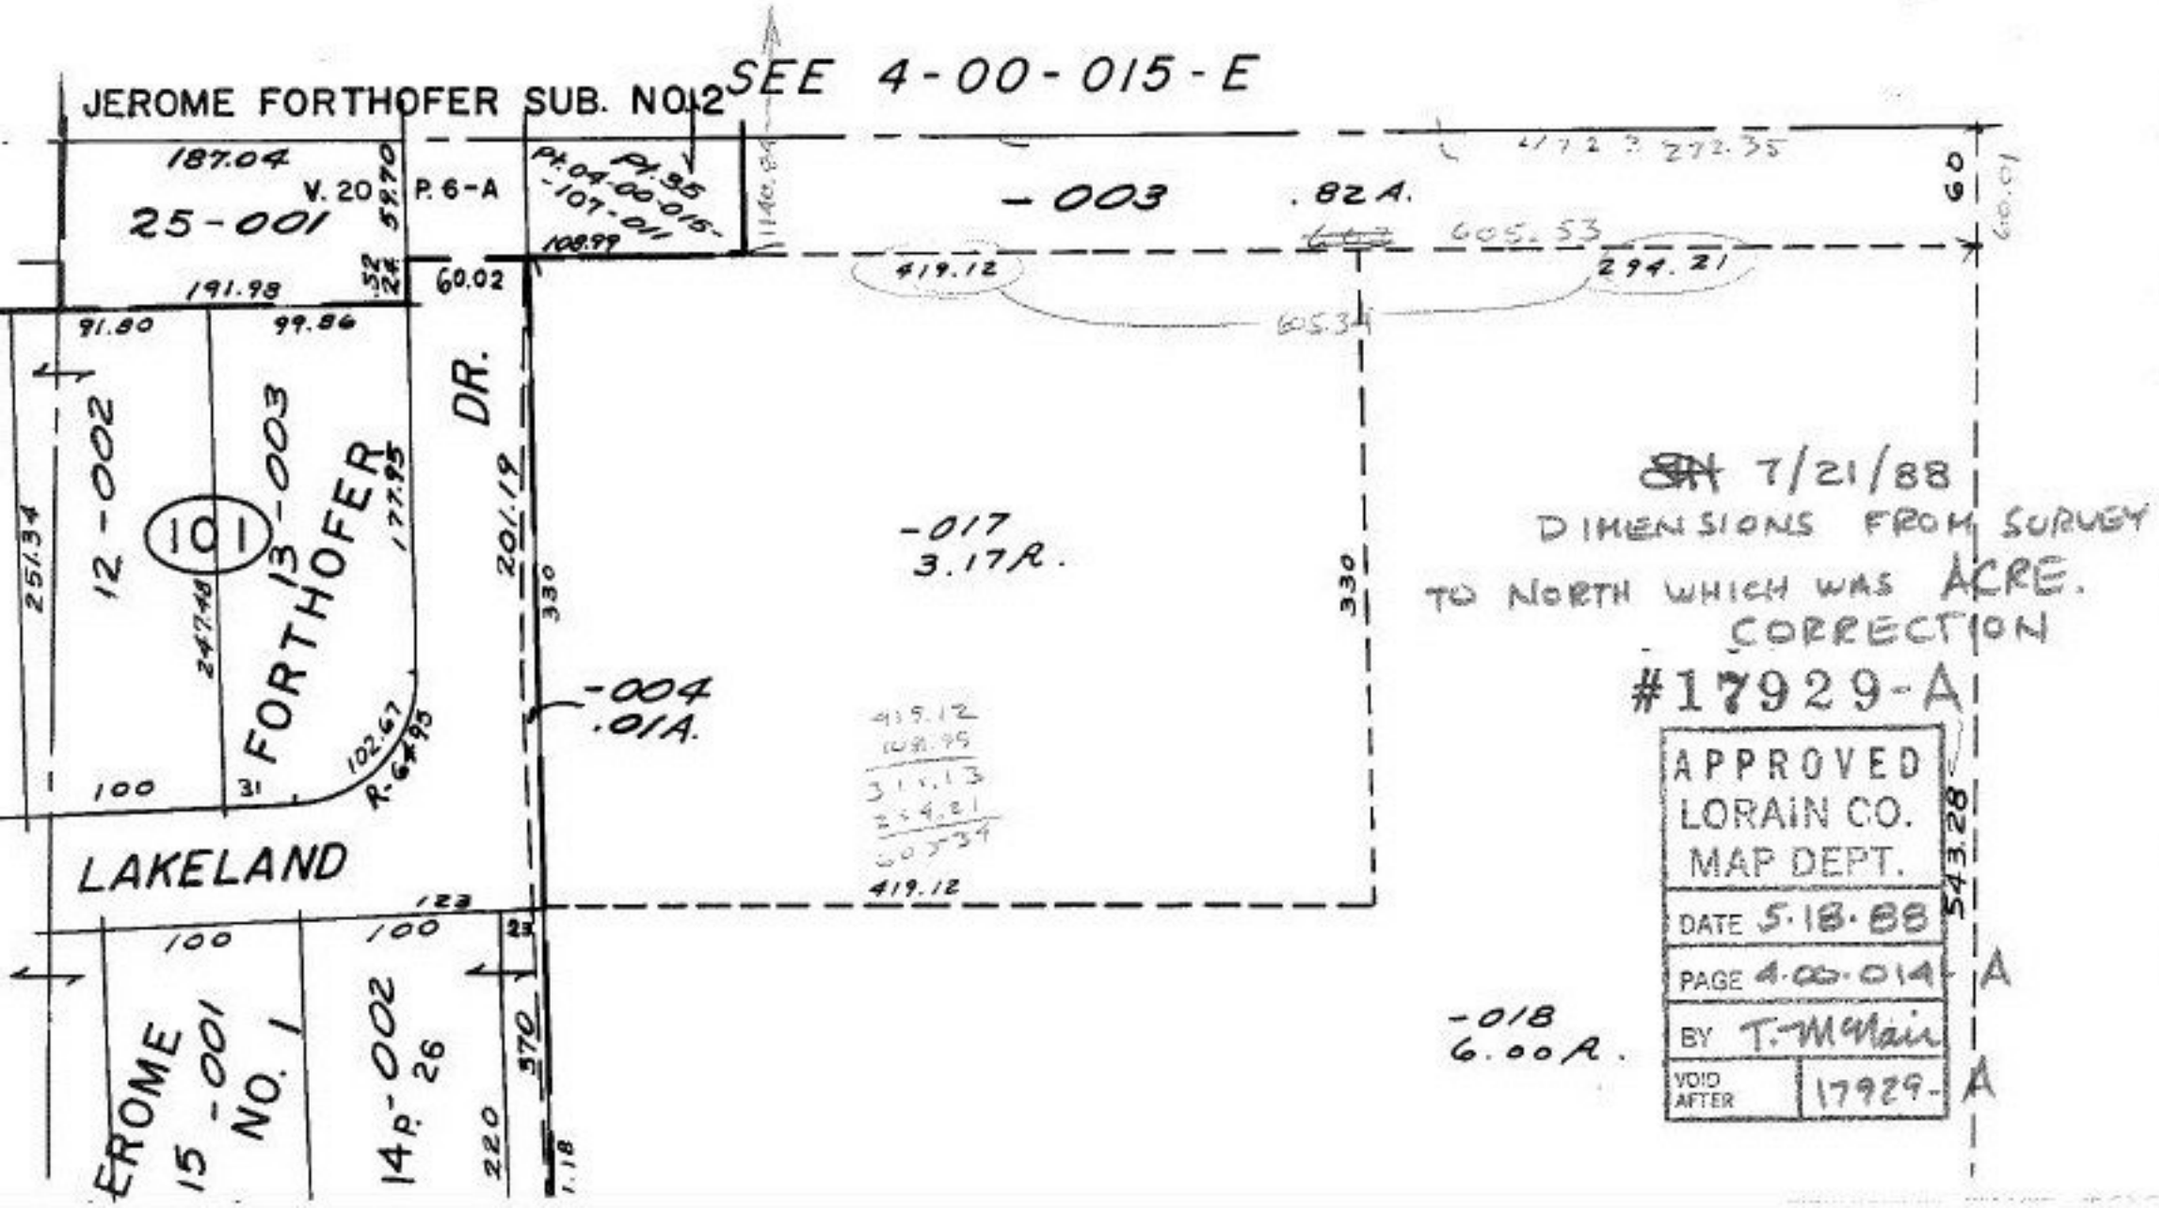

SH 7/21/88
DIMENSIONS FROM SURVEY TO NORTH WHICH WAS ACRE.
CORRECTION
#17929-A

APPROVED
LORAIN CO.
MAP DEPT.
DATE 5-18-88
PAGE 4-00-014
BY T. McMain
VOID AFTER 17929-