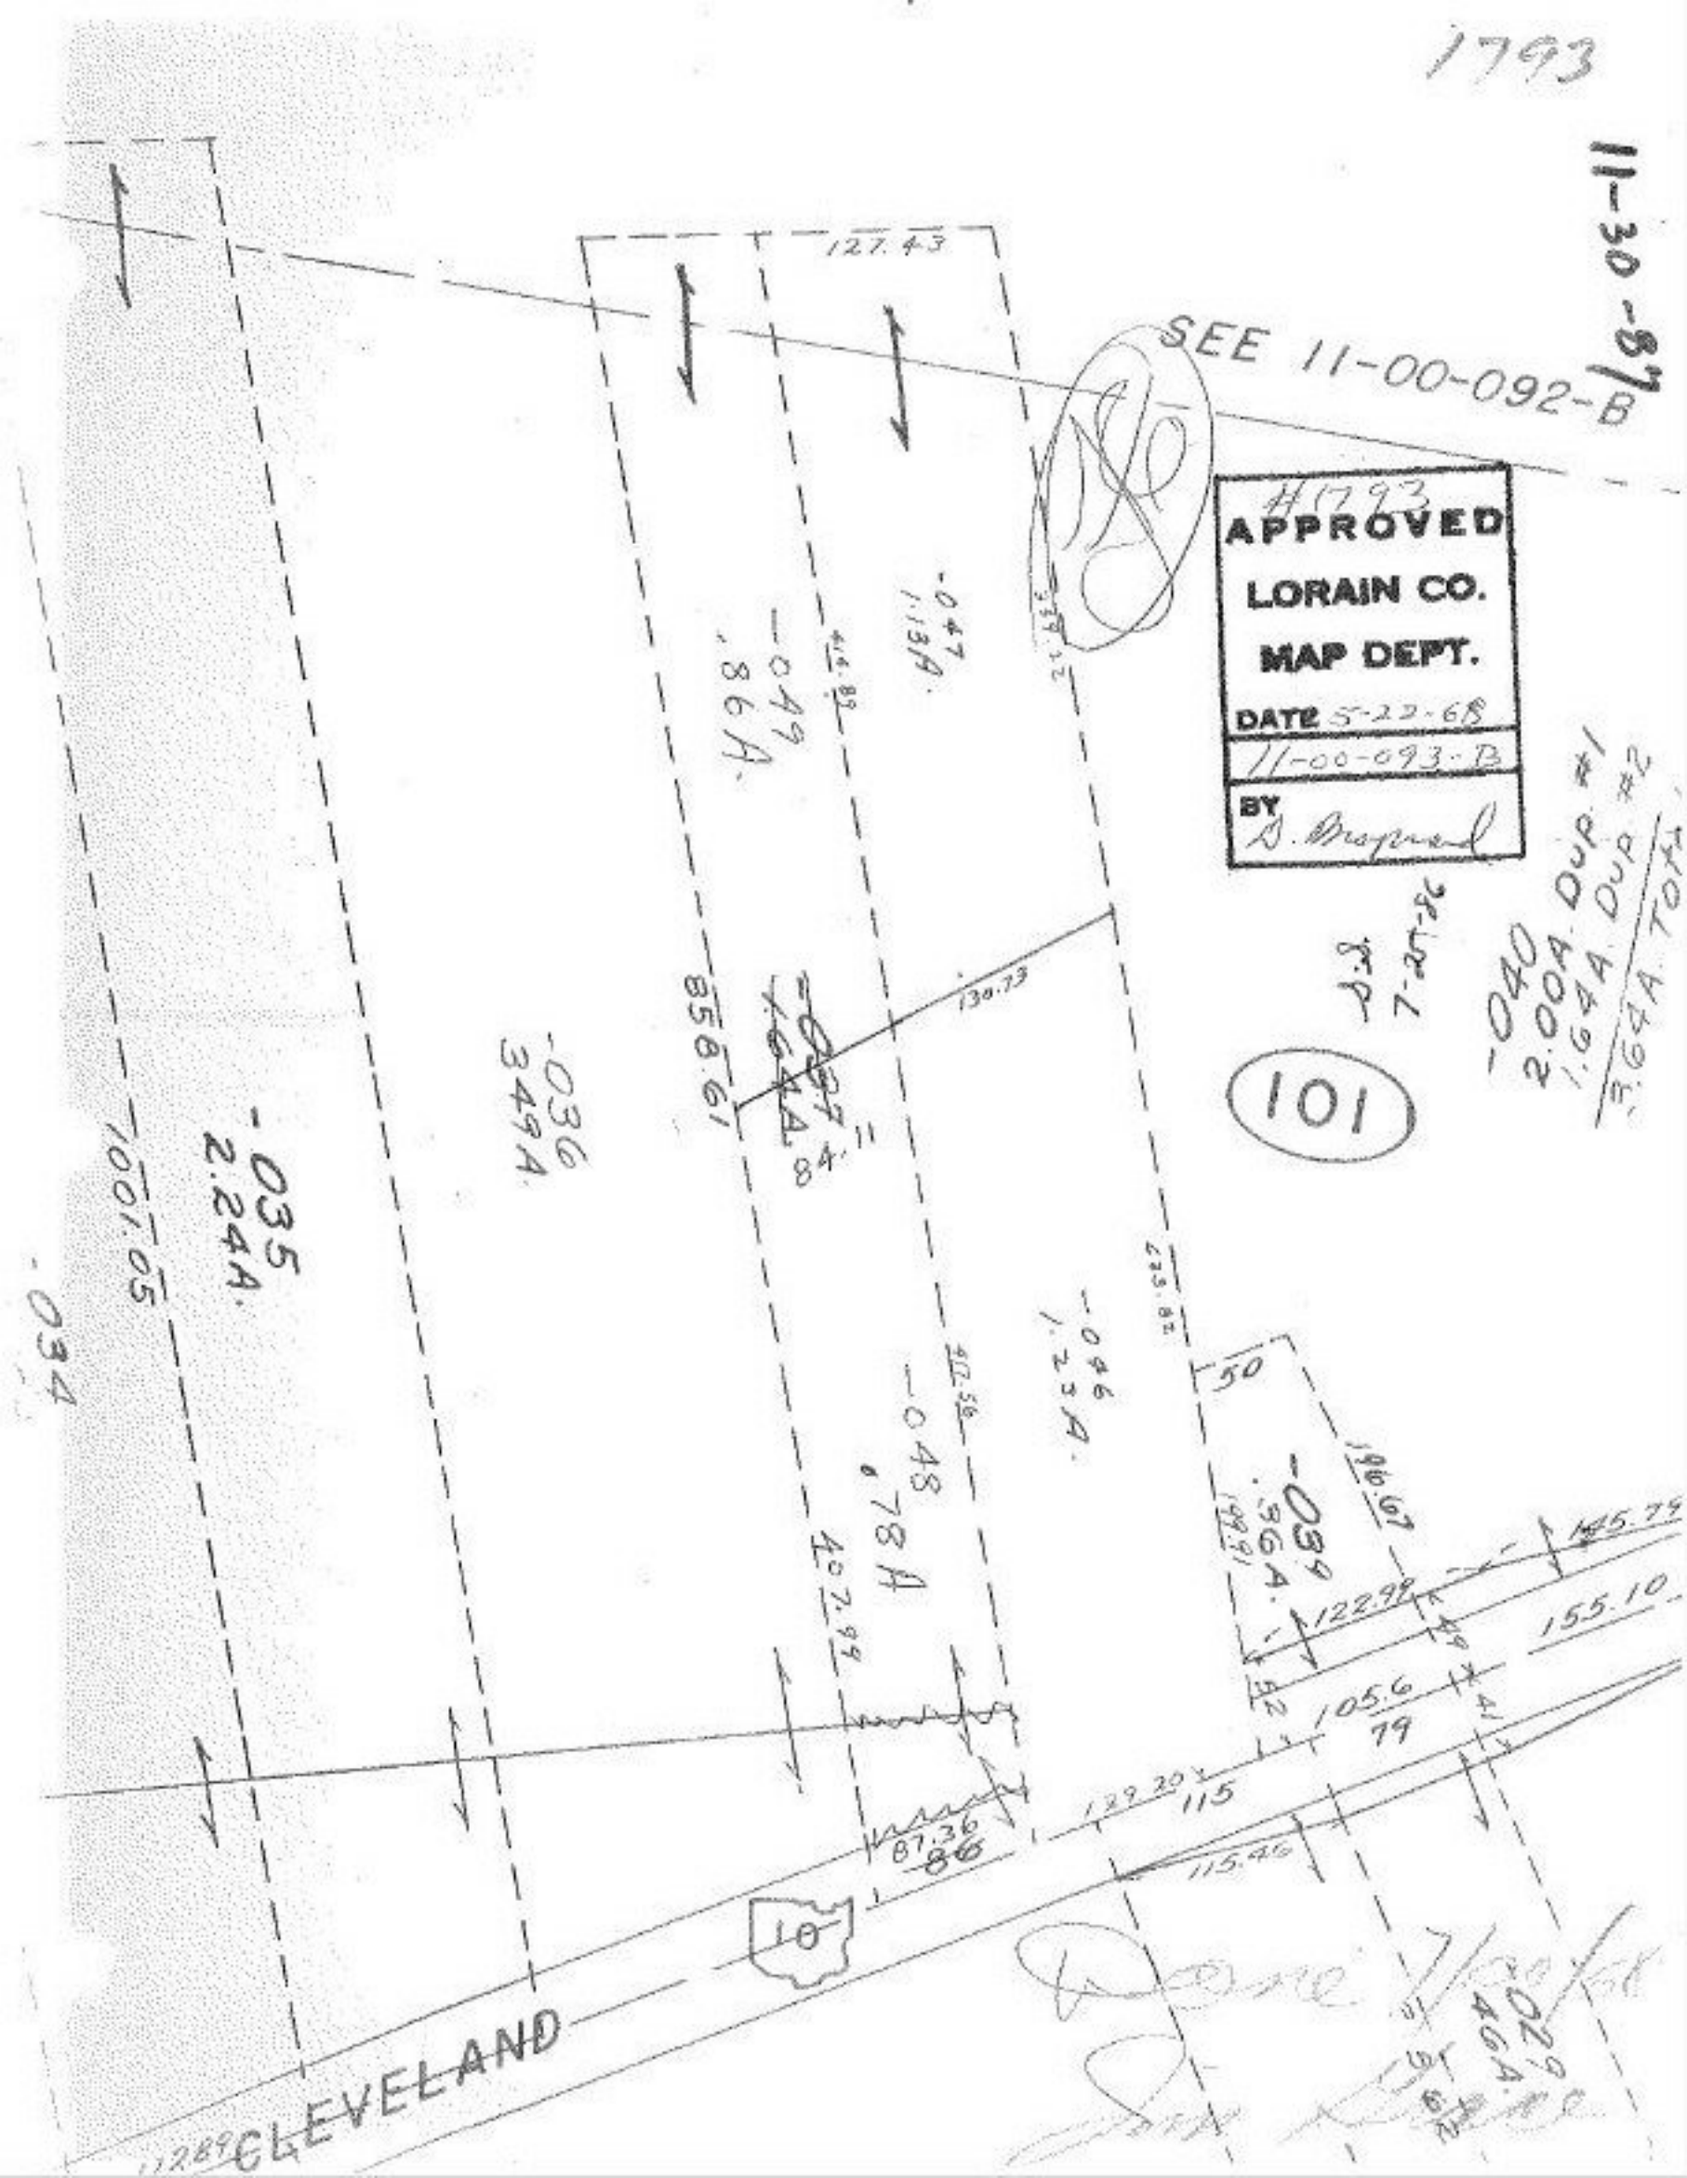
1793
11-30-87
SEE 11-00-092-B
#1793
APPROVED
LORAIN CO.
MAP DEPT.
DATE 5-22-68
11-00-093-B
BY D. Bogner
-040
2.004 DUP #1
1.644 DUP #2
3.644 TOTAL
7.32-7
T.P.
101
-047
1.138 A.
-049
.86 A.
-036
3.494 A.
-035
2.244 A.
-034
-046
1.238 A.
-048
.784 A.
-039
.364 A.
127.43
130.73
858.61
1001.05
402.99
402.59
223.82
146.67
122.98
155.10
105.6
79
129.20
115
87.36
86
115.46
10
CLEVELAND
1289