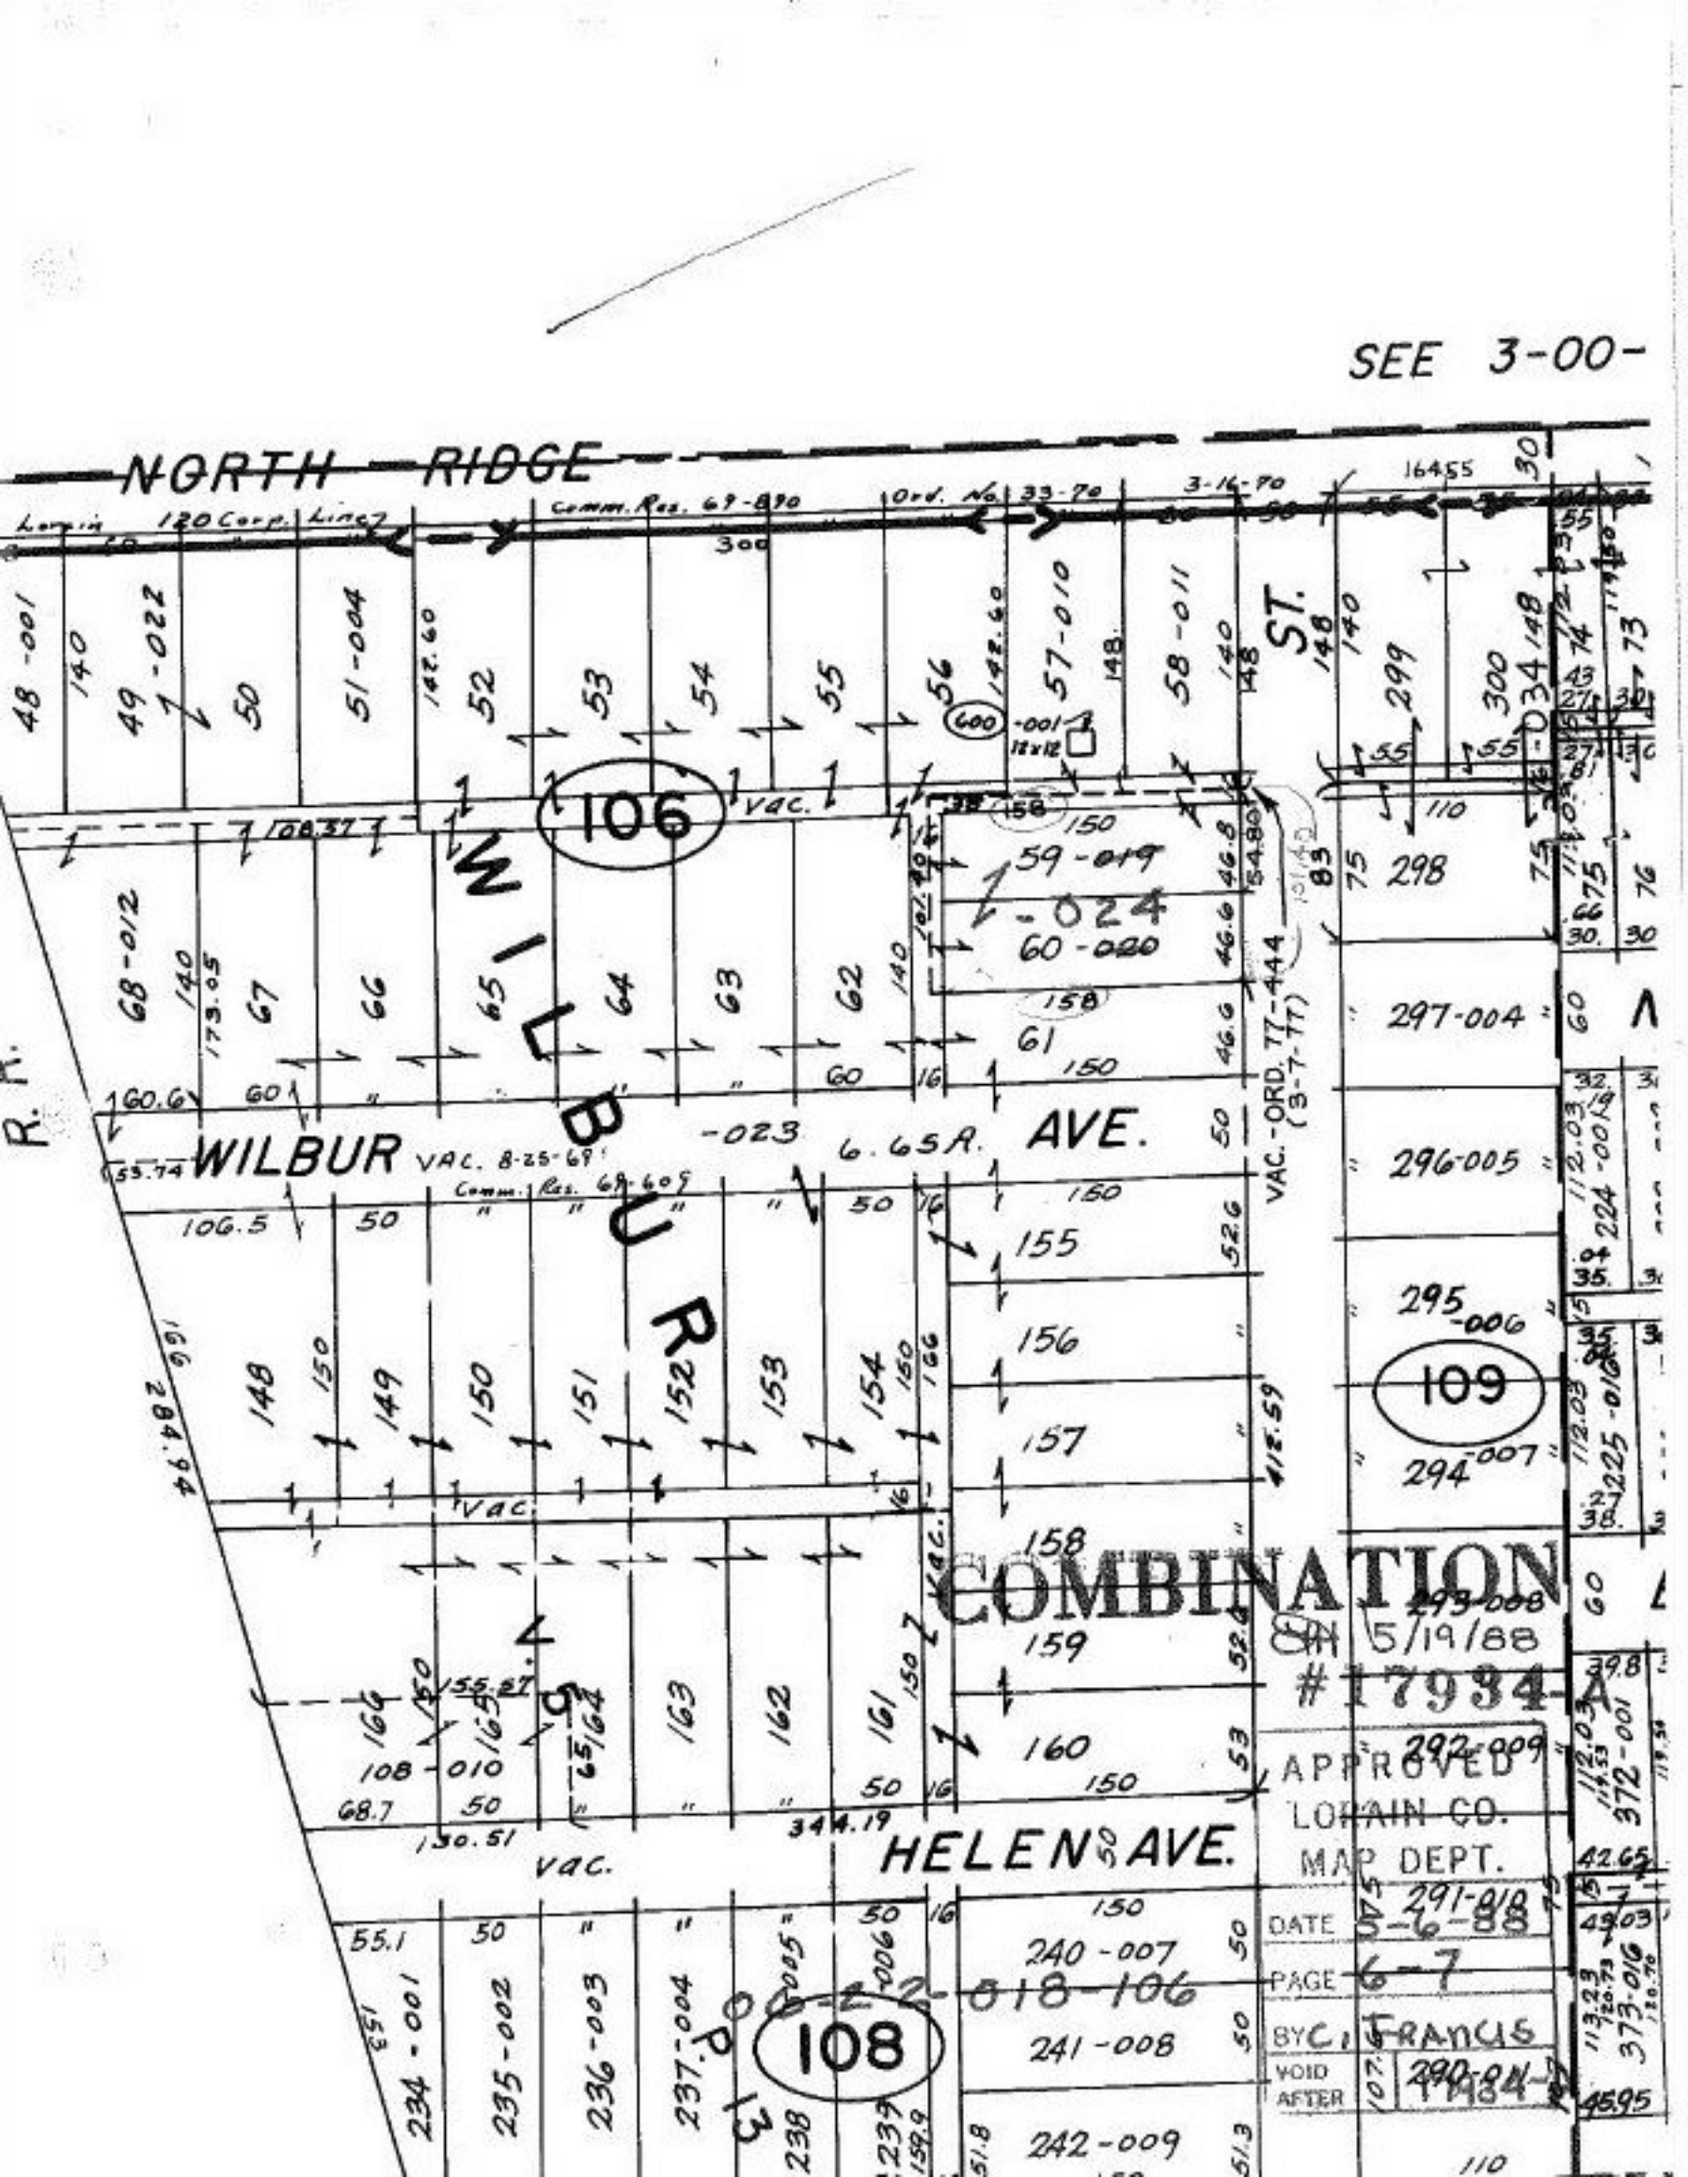
SEE 3-00-
NORTH RIDGE
Lorain 120 Corp. Line
Comm. Res. 69-890
Ord. No. 33-70
3-16-70
WILBUR
WILBUR AVE.
VAC. 8-25-69
Comm. Res. 69-609
6.65A.
VAC.-ORD. 77-444 (3-7-77)
HELEN AVE.
106
108
109
COMBINATION
5/19/88
#17934-A
APPROVED
LORAIN CO.
MAP DEPT.
DATE 5-6-88
PAGE 6-7
BY C. FRANCIS
VOID AFTER
06-22-018-106
P. 13