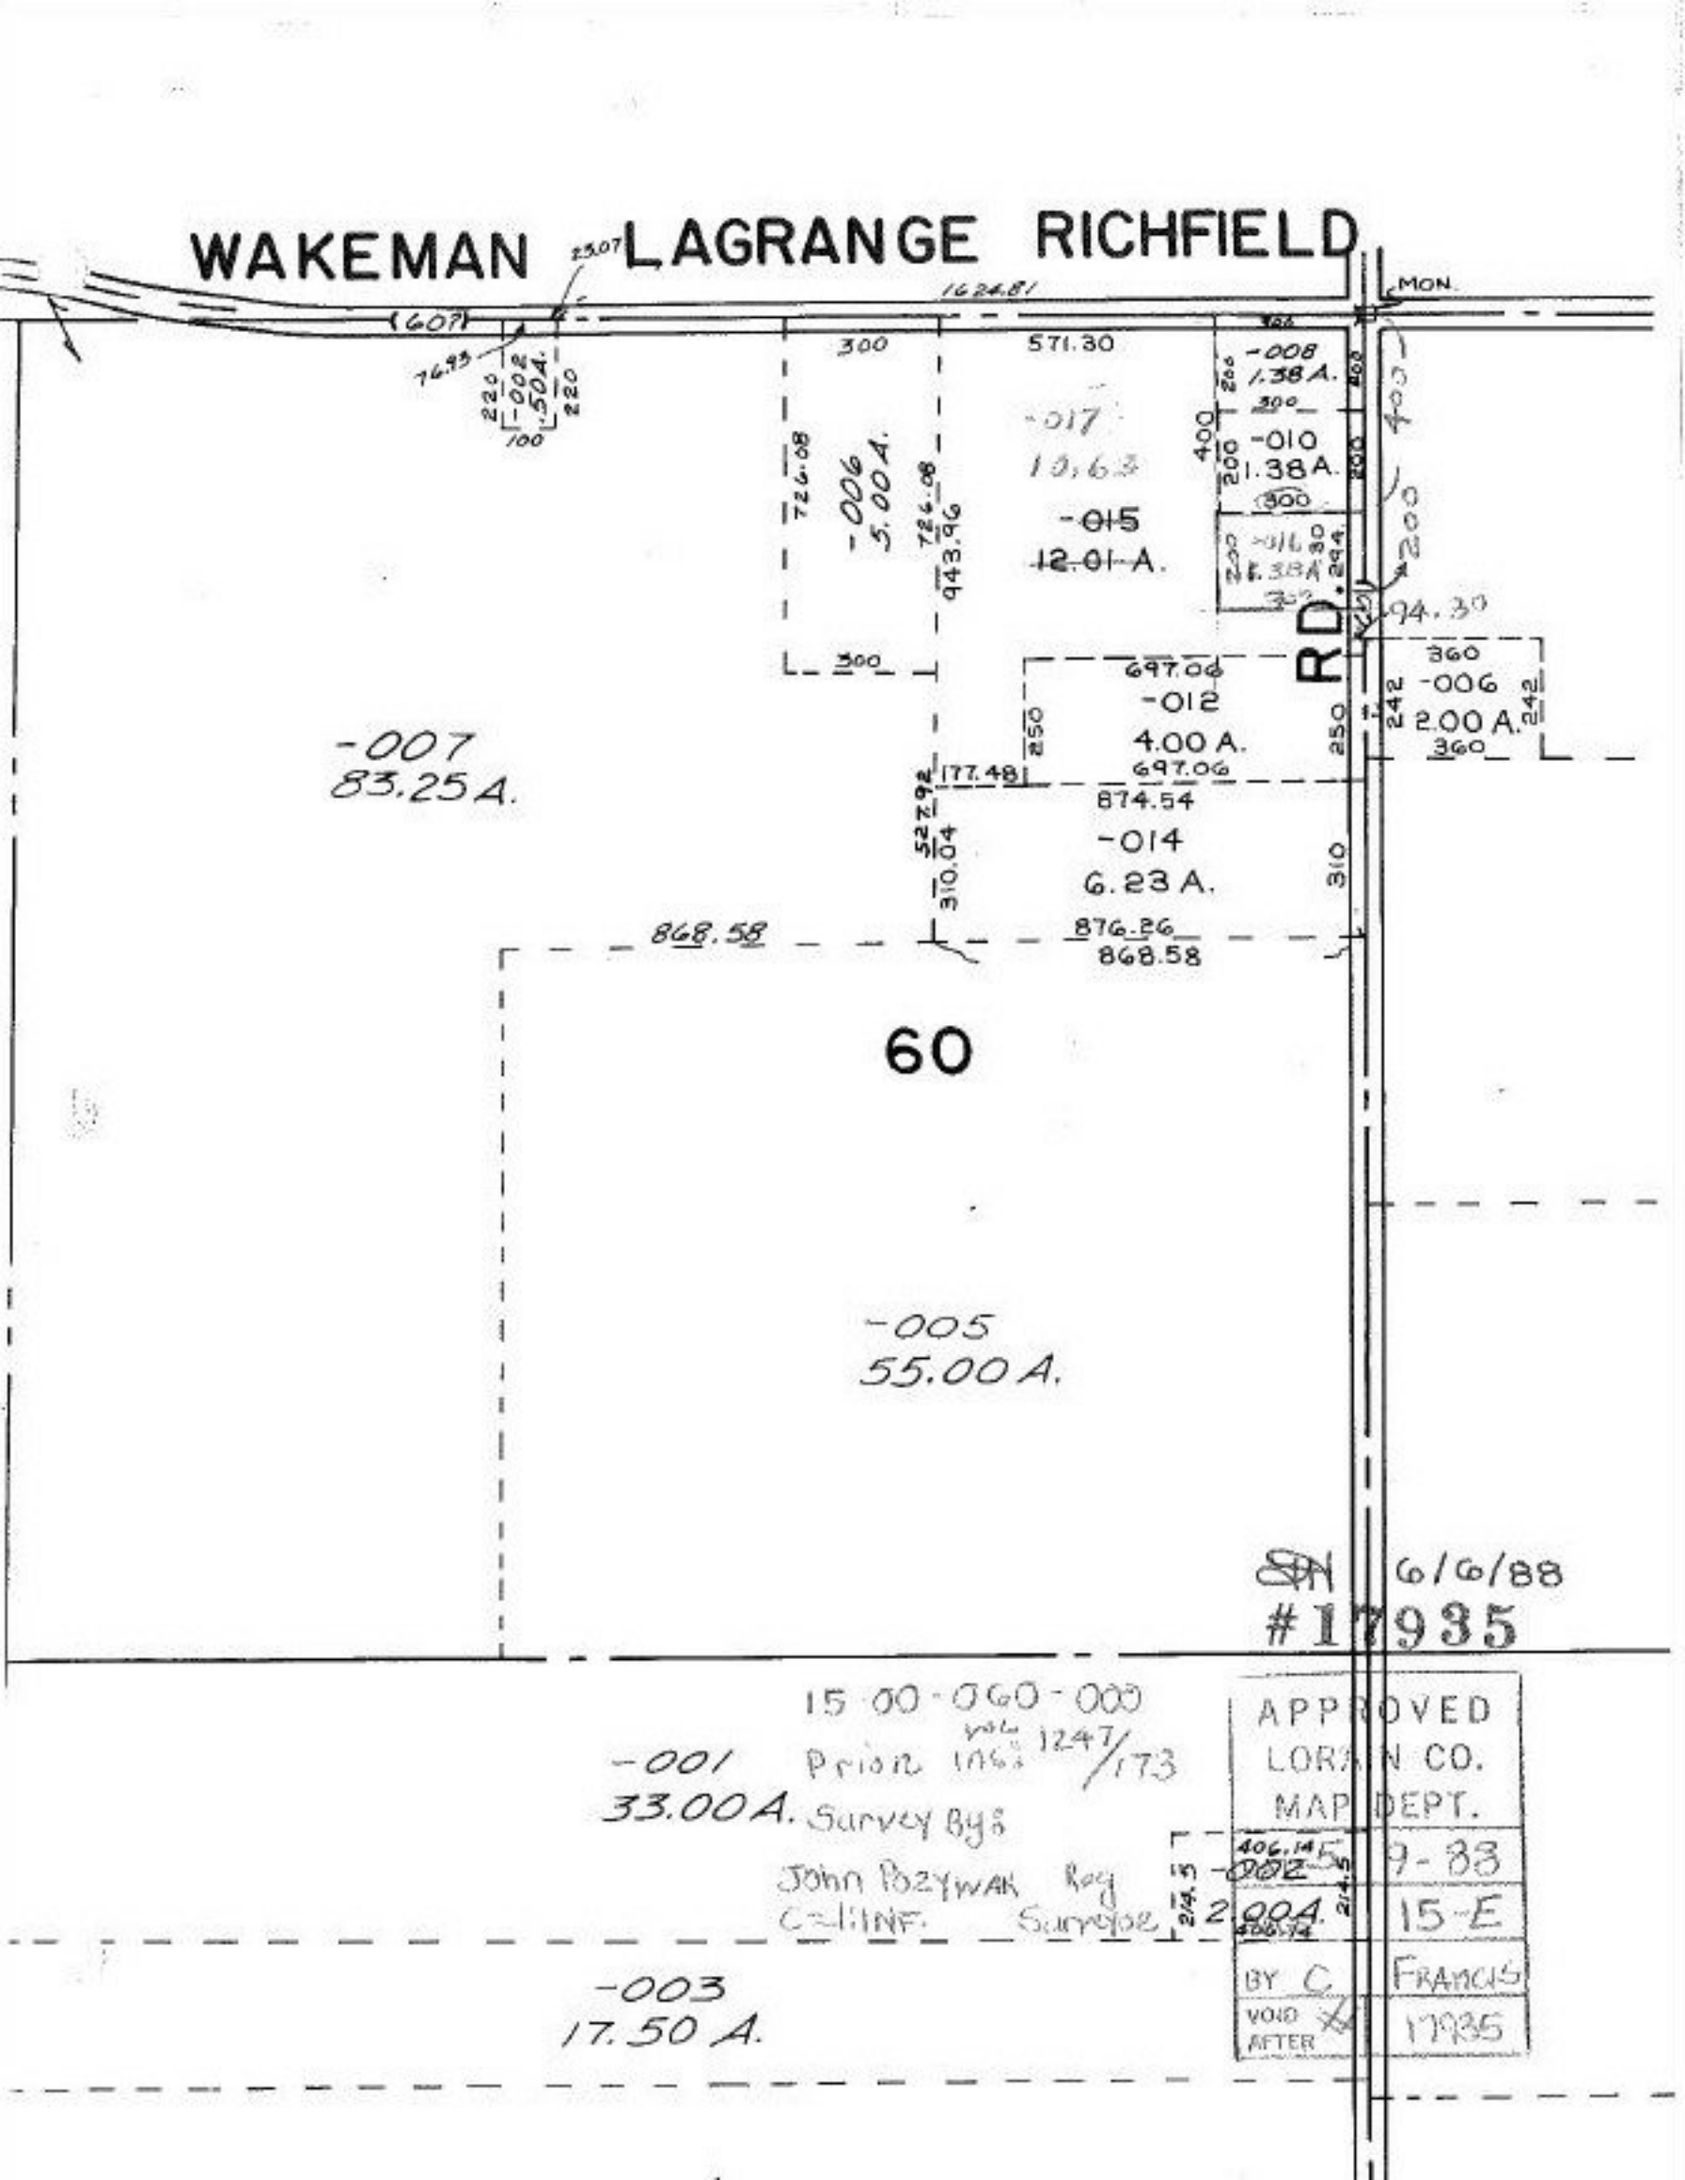
WAKEMAN LAGRANGE RICHFIELD
MON.
1624.81
(607)
76.93
-002
.50A.
-006
5.00A.
726.08
943.96
571.30
-008
1.38A.
-010
1.38A.
-017
10.63
-015
12.01 A.
-016
1.38A
94.30
RD.
697.06
-012
4.00 A.
-006
2.00 A.
-007
83.25A.
177.48
874.54
-014
6.23 A.
310.04
868.58
876.26
868.58
60
-005
55.00 A.
6/6/88
#17935
15-00-060-000
Prior Ins: vol 1247/173
-001
33.00A.
Survey By:
John Pozywak Reg
C=LINF. Surveyor
-002
2.00A.
-003
17.50 A.
APPROVED
LORAIN CO.
MAP DEPT.
9-88
15-E
BY C. FRANCIS
VOID AFTER
17935