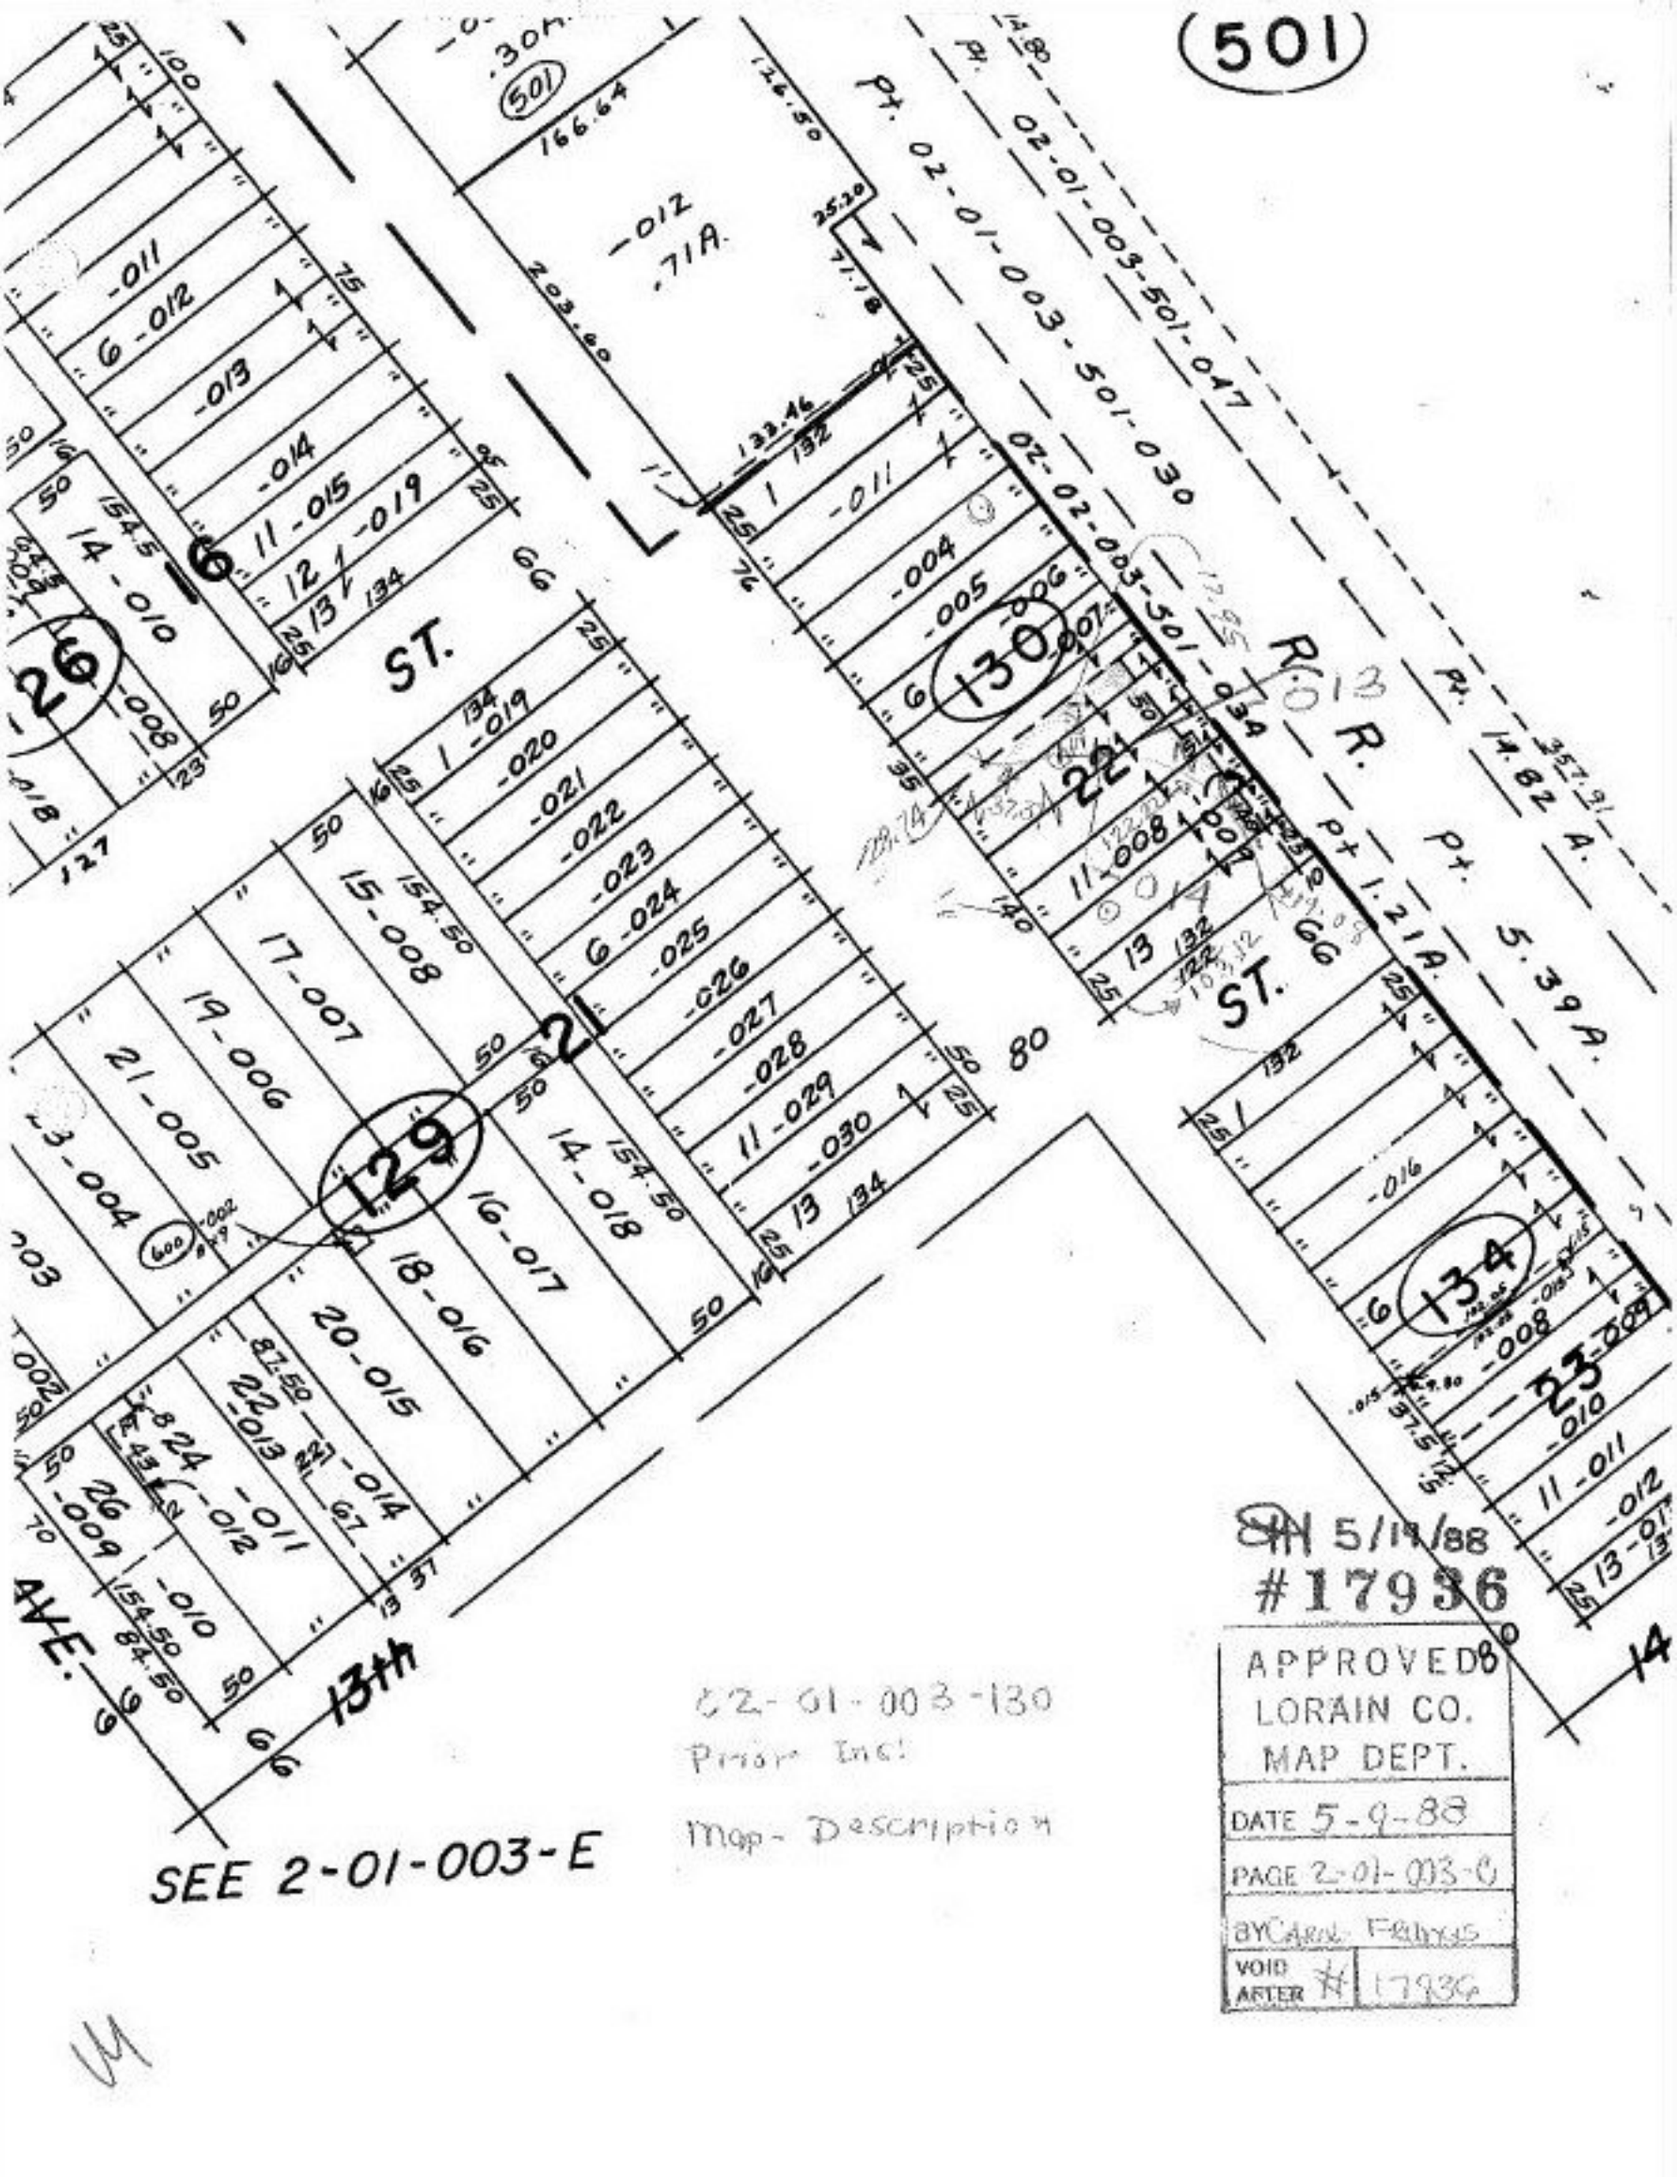
501
Pt. 02-01-003-501-047
Pt. 02-01-003-501-030
-012
.71A.
166.64
203.90
132.46
02-02-003-501-034
R.O.W.
Pt. 1.21A.
Pt. 14.82 A.
Pt. 5.39 A.
ST.
GG
ST.
13th
AVE.
SEE 2-01-003-E
02-01-003-130
Prior Inc!
Map-Description
5/19/88
#17936
APPROVED
LORAIN CO.
MAP DEPT.
DATE 5-9-88
PAGE 2-01-003-0
BY CARL FRANKS
VOID AFTER # 17936