SEE 4-00-026-E

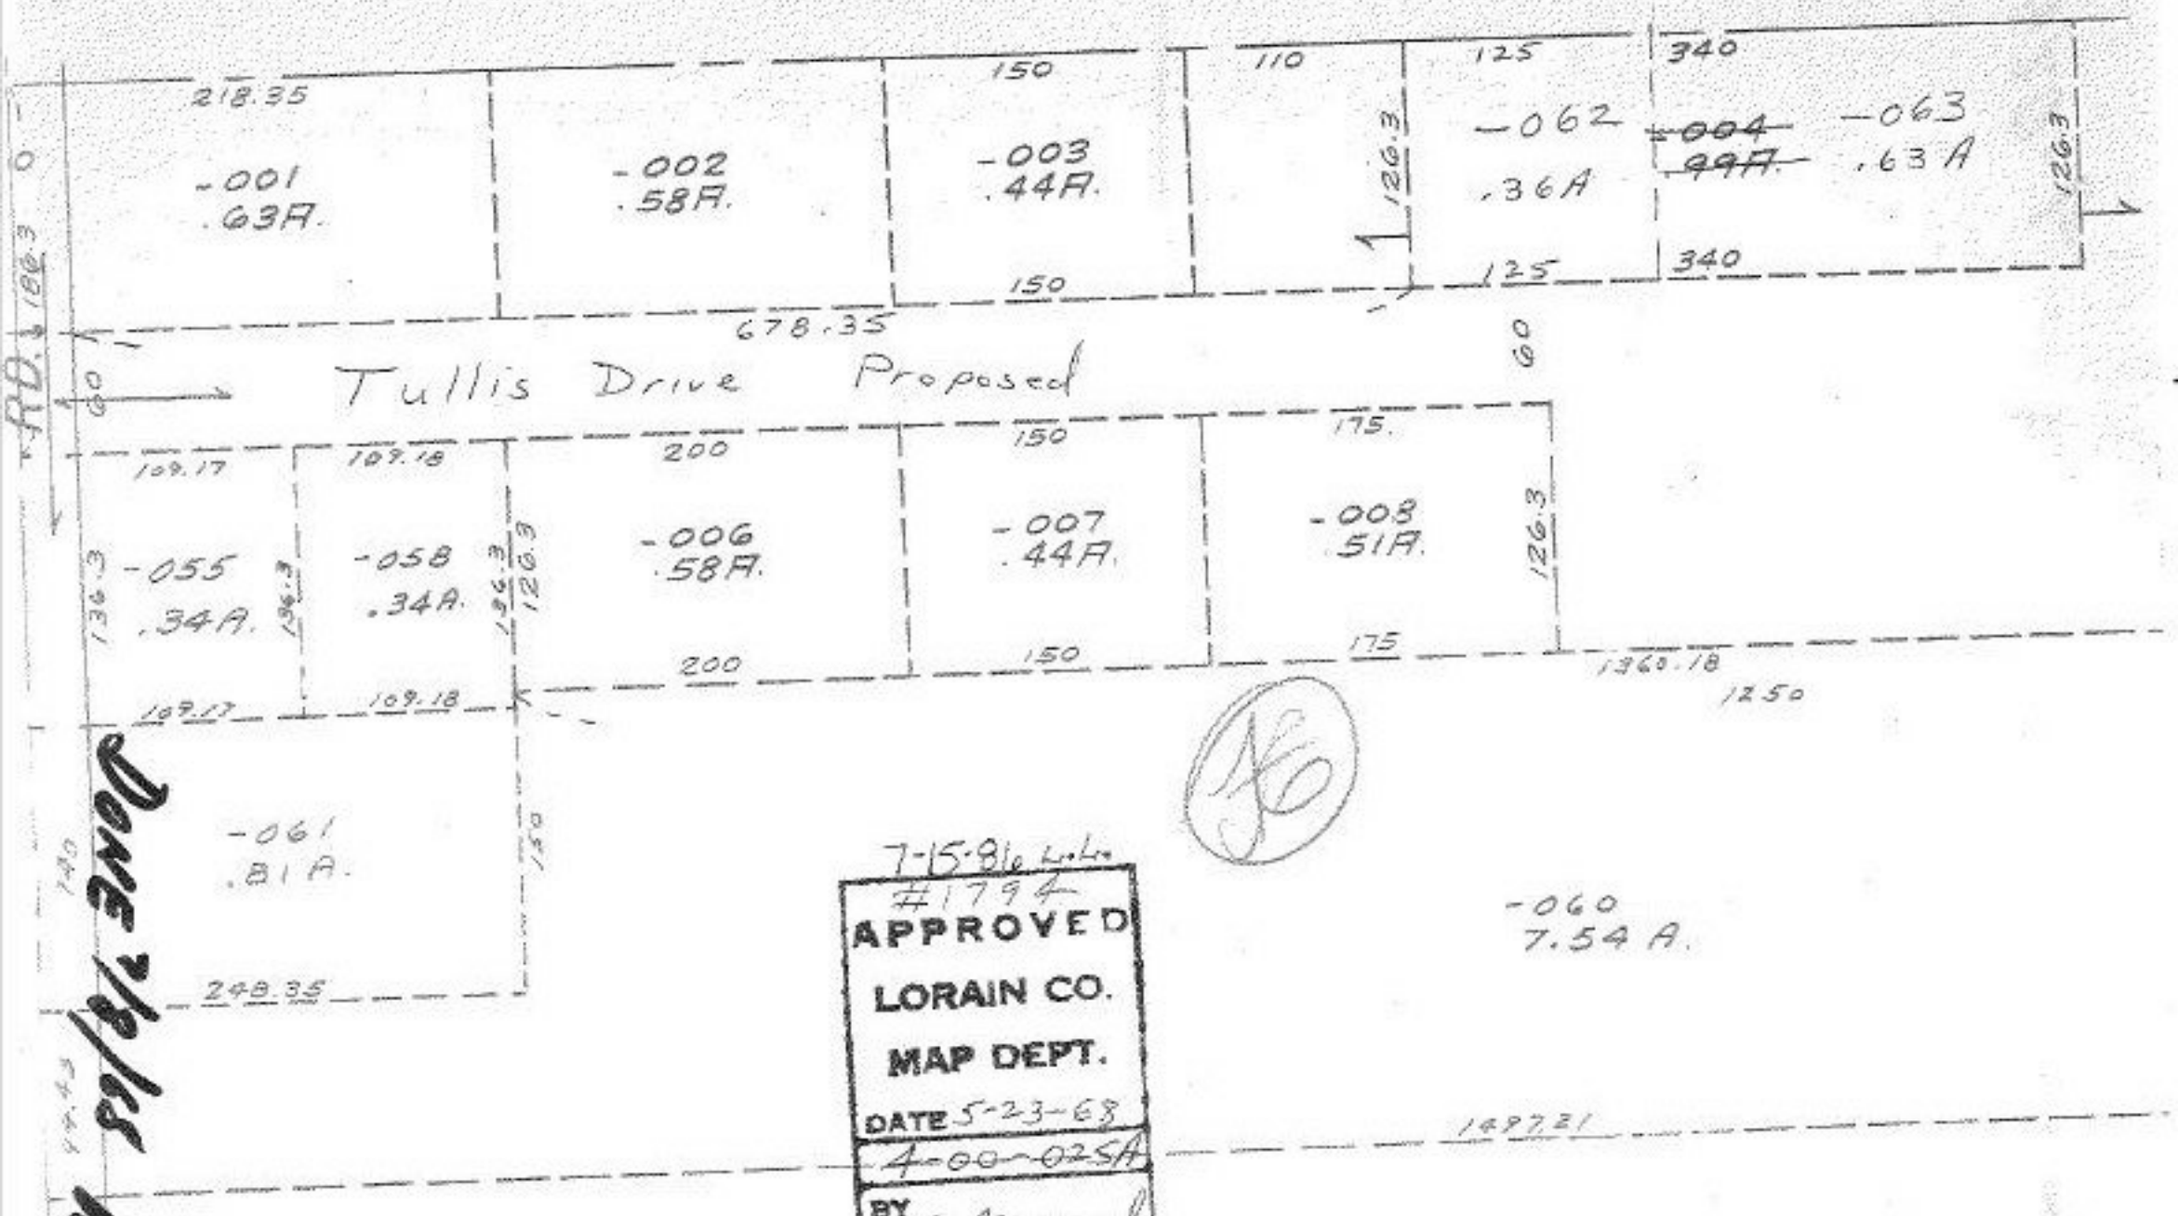

7-15-86 L.L.
#1794
APPROVED
LORAIN CO.
MAP DEPT.
DATE 5-23-68
4-00-025A
BY D. Maynard

DONE 7/8/68 M. Kaufis

9018-1-9