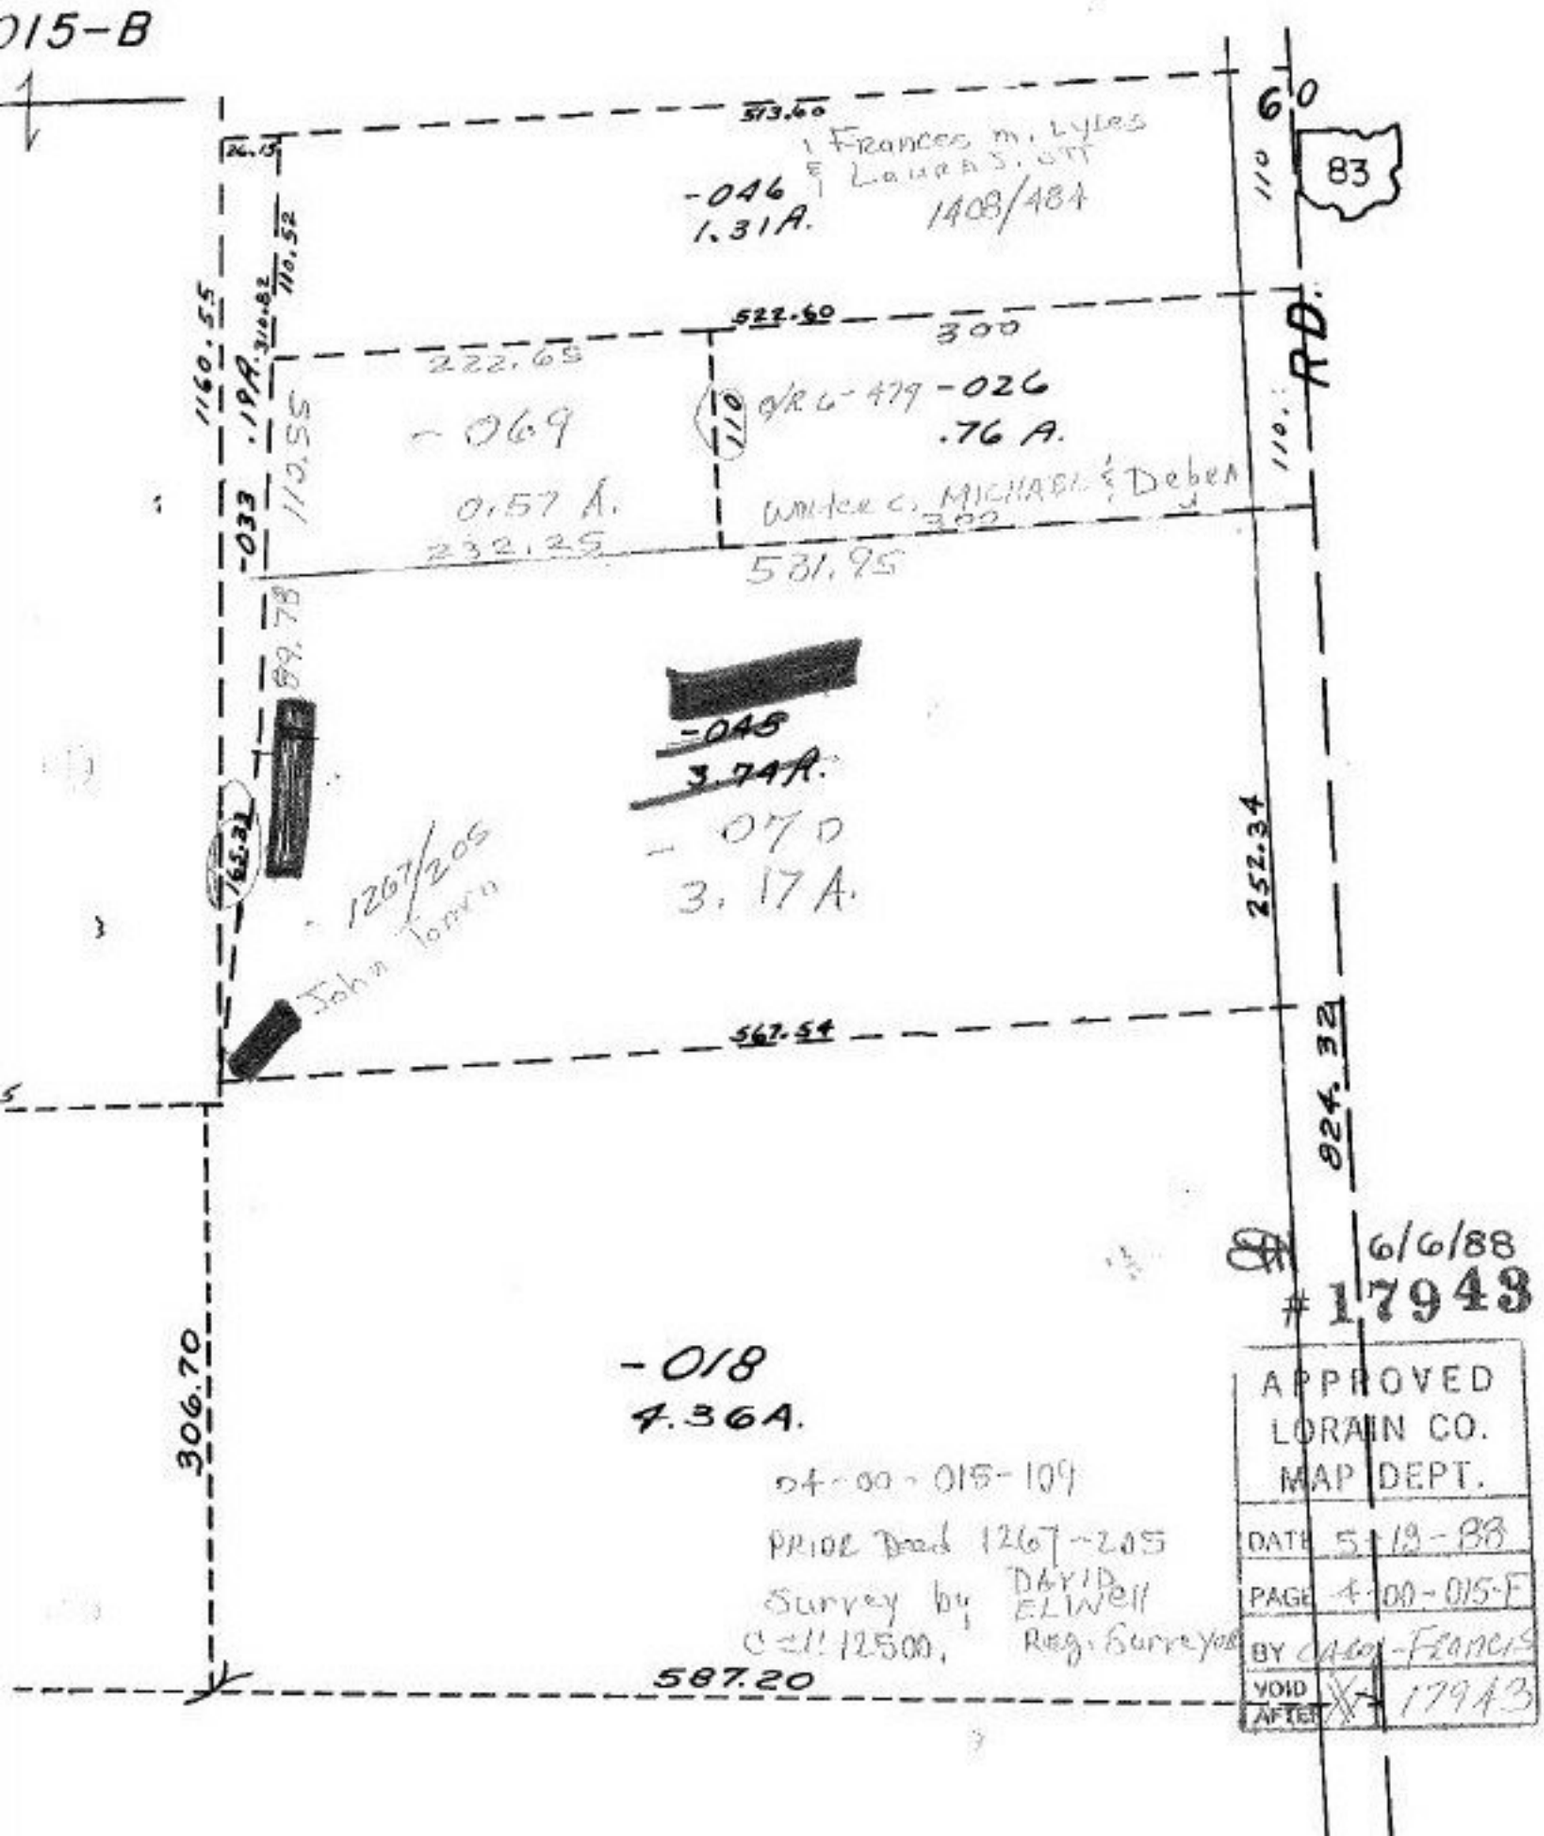
015-B
513.60
Frances M. Lyles
& Laura S. Ott
-046
1.31A.
1408/484
60
83
110
RD.
522.60
300
222.65
-069
0.57 A.
232.25
110
O/R 6-479 -026
.76 A.
Walter C. Michael & Debra
300
531.95
1160.55
.19A.
310.82
110.52
110.55
-033
89.78
165.32
1267/205
John Tomm
-048
3.74A.
-070
3.17A.
252.34
567.54
824.32
306.70
-018
4.36A.
04-00-015-109
PRIOR Deed 1267-205
Survey by David Elwell
C=1:12500. Reg. Surveyor
587.20
6/6/88
#17943
APPROVED
LORAIN CO.
MAP DEPT.
DATE 5-19-88
PAGE 4-00-015-F
BY Carol Francis
VOID AFTER 17943