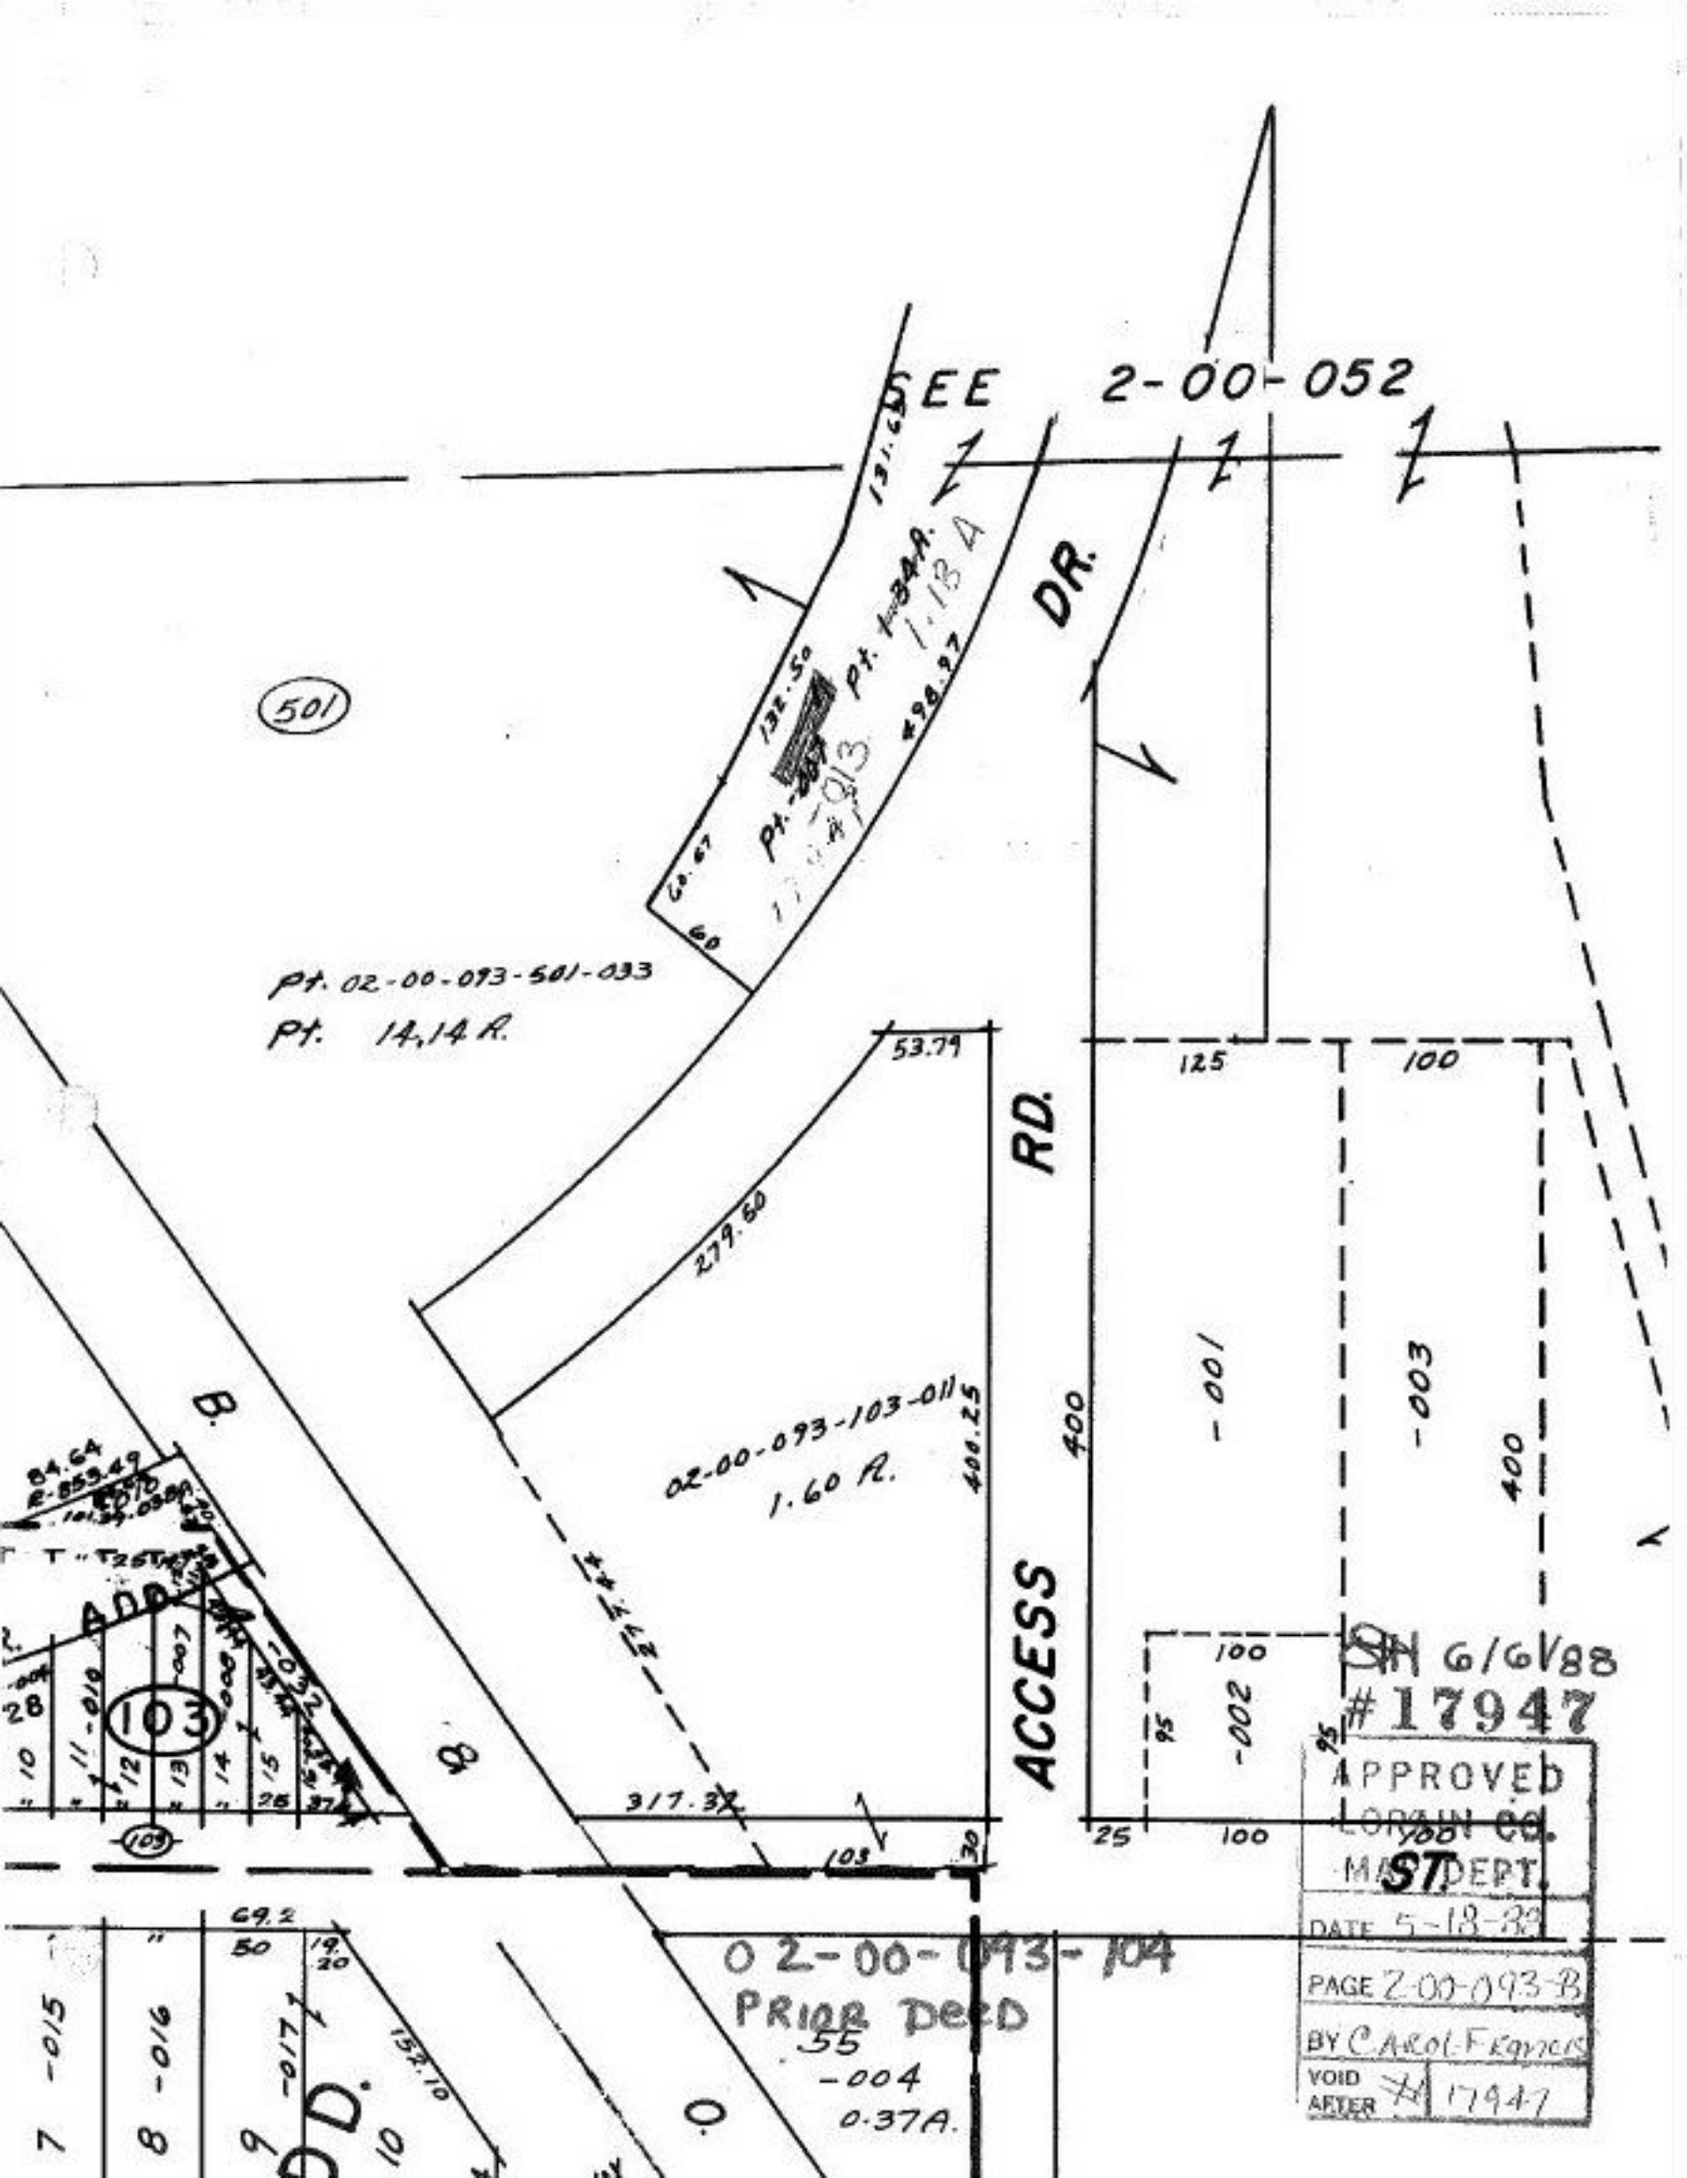
SEE 2-00-052
DR.
501
Pt. 02-00-093-501-033
Pt. 14,14 R.
53.79
279.60
RD.
ACCESS
02-00-093-103-011
1.60 R.
400.25
317.32
125
100
400
-001
-003
-002
25
100
B.
B
103
30
69.2
50
19.20
157.10
02-00-093-104
PRIOR DEED
55
-004
0.37A.
7 -015
8 -016
9 -017
10
11 -010
12
13
14
15
26
27
-007
-032
-033
APPROVED
LORAIN CO.
MAP DEPT.
DATE 5-18-88
PAGE 2-00-093-B
BY CAROL F KAYSER
VOID AFTER 17947
SH 6/6/88
#17947