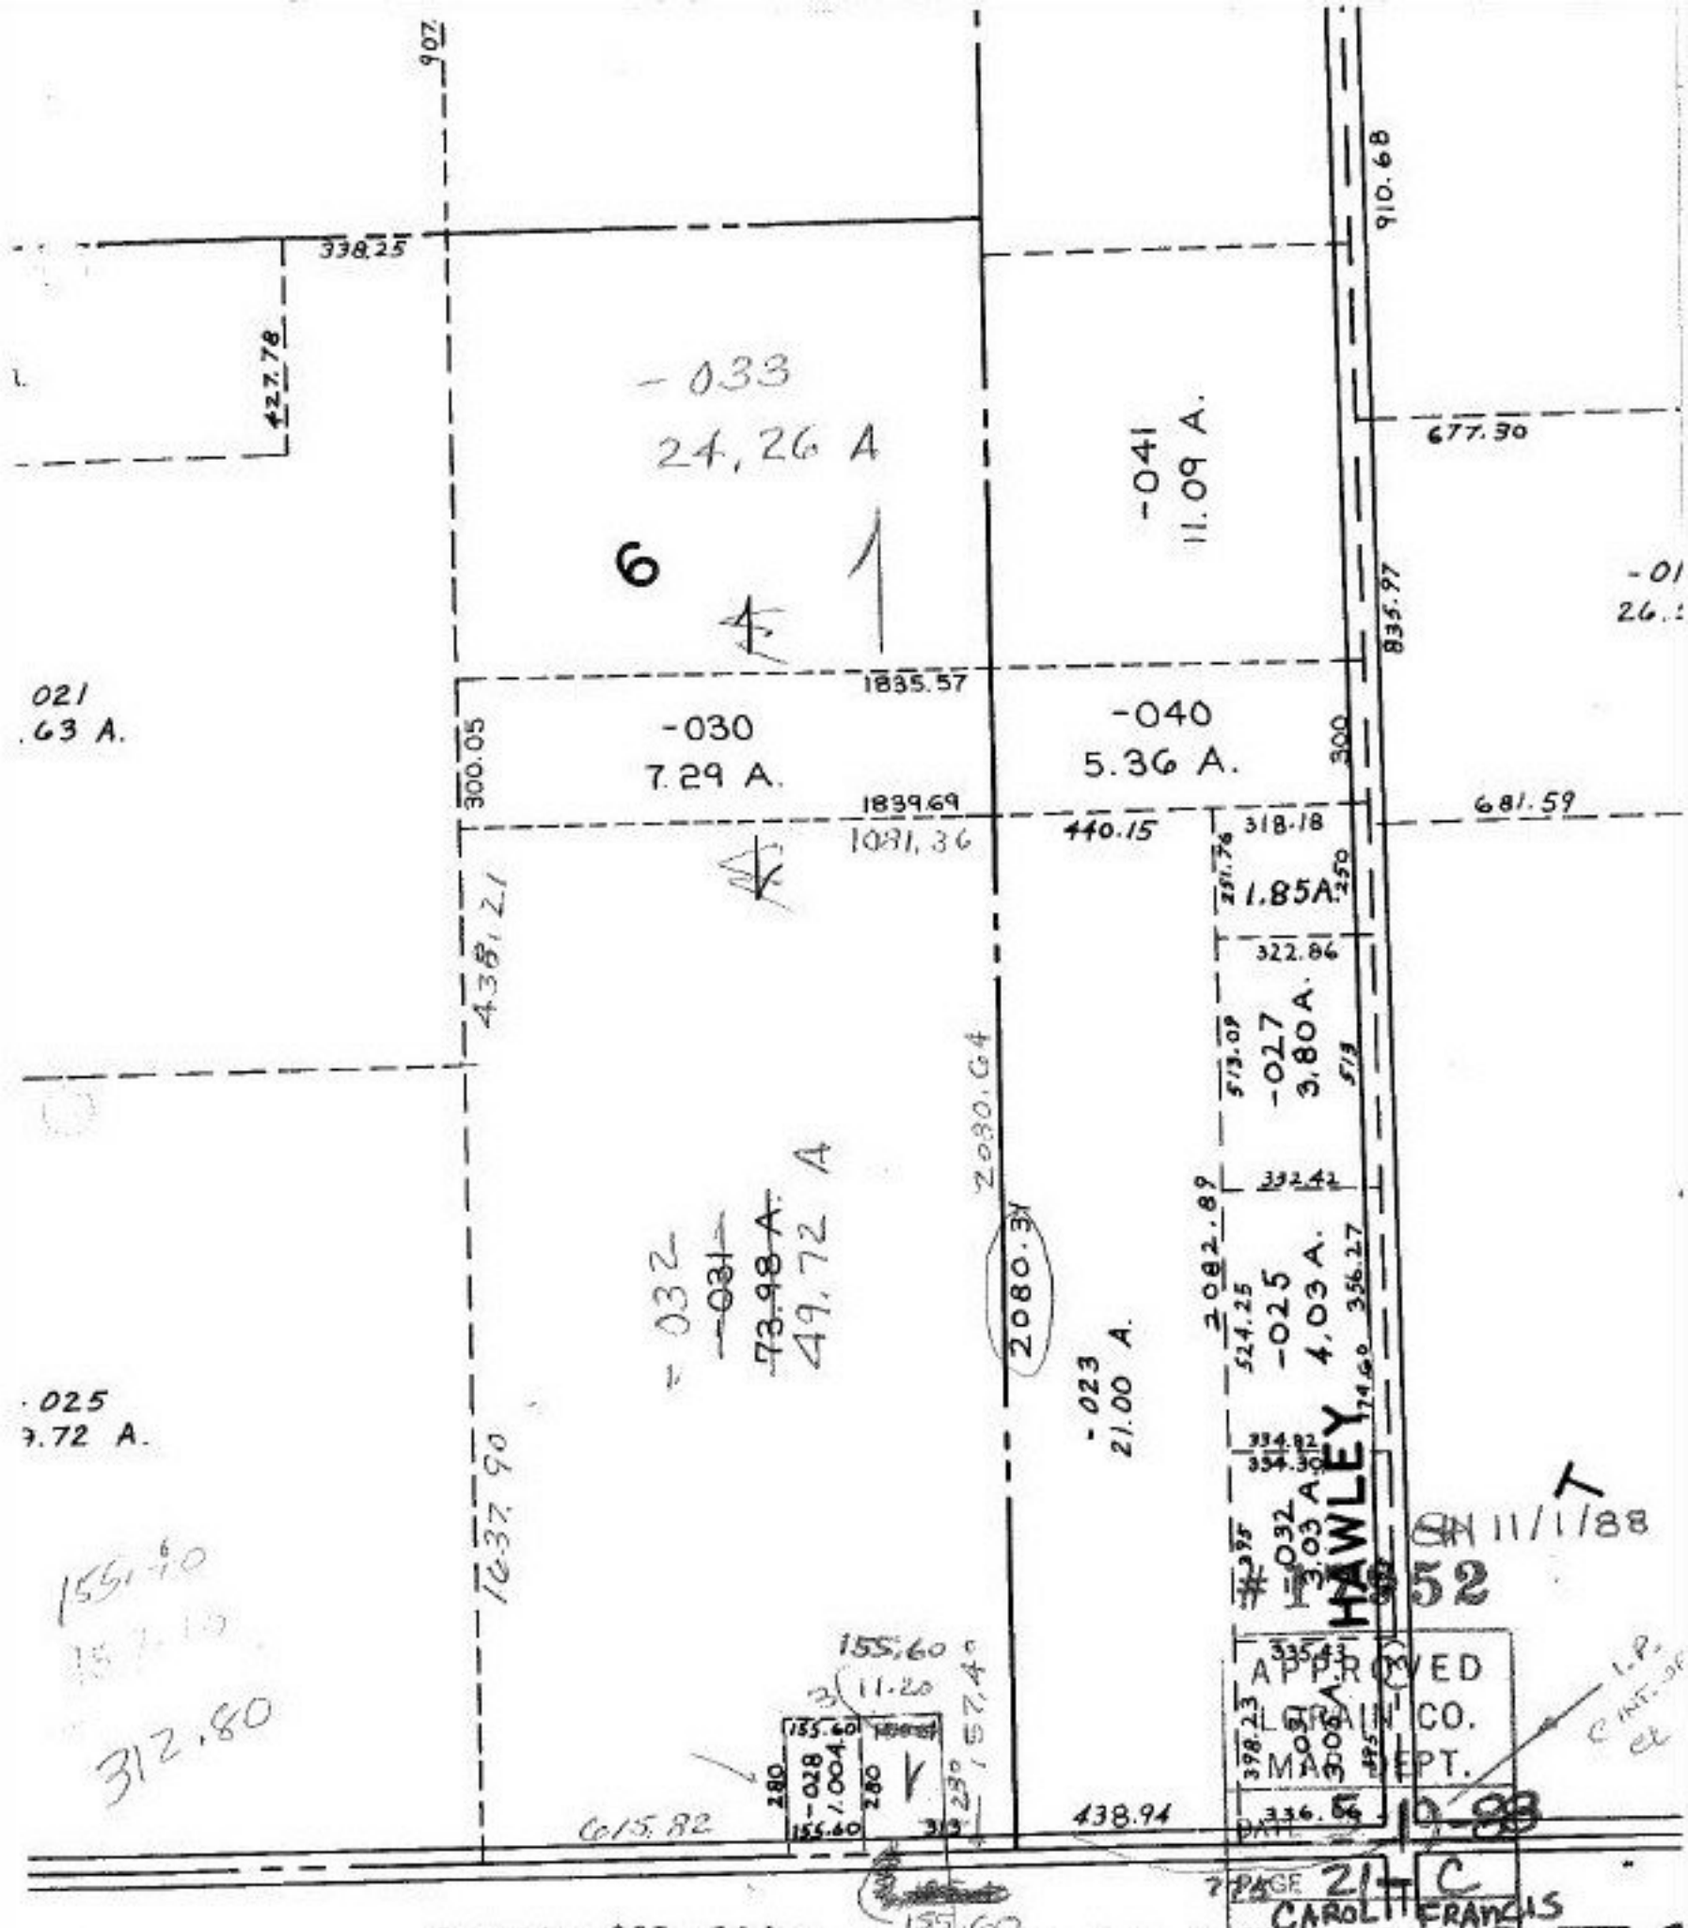

21-06-000-000-
PRIOR Deed 1077 702
1420 895
Survey By-WILLIAM B. BARTON
Reg. Surveyor C=1:10,0000.

HUNTINGTO

SCALE 1" = 400'

PT. 12
4. & 9

#17952