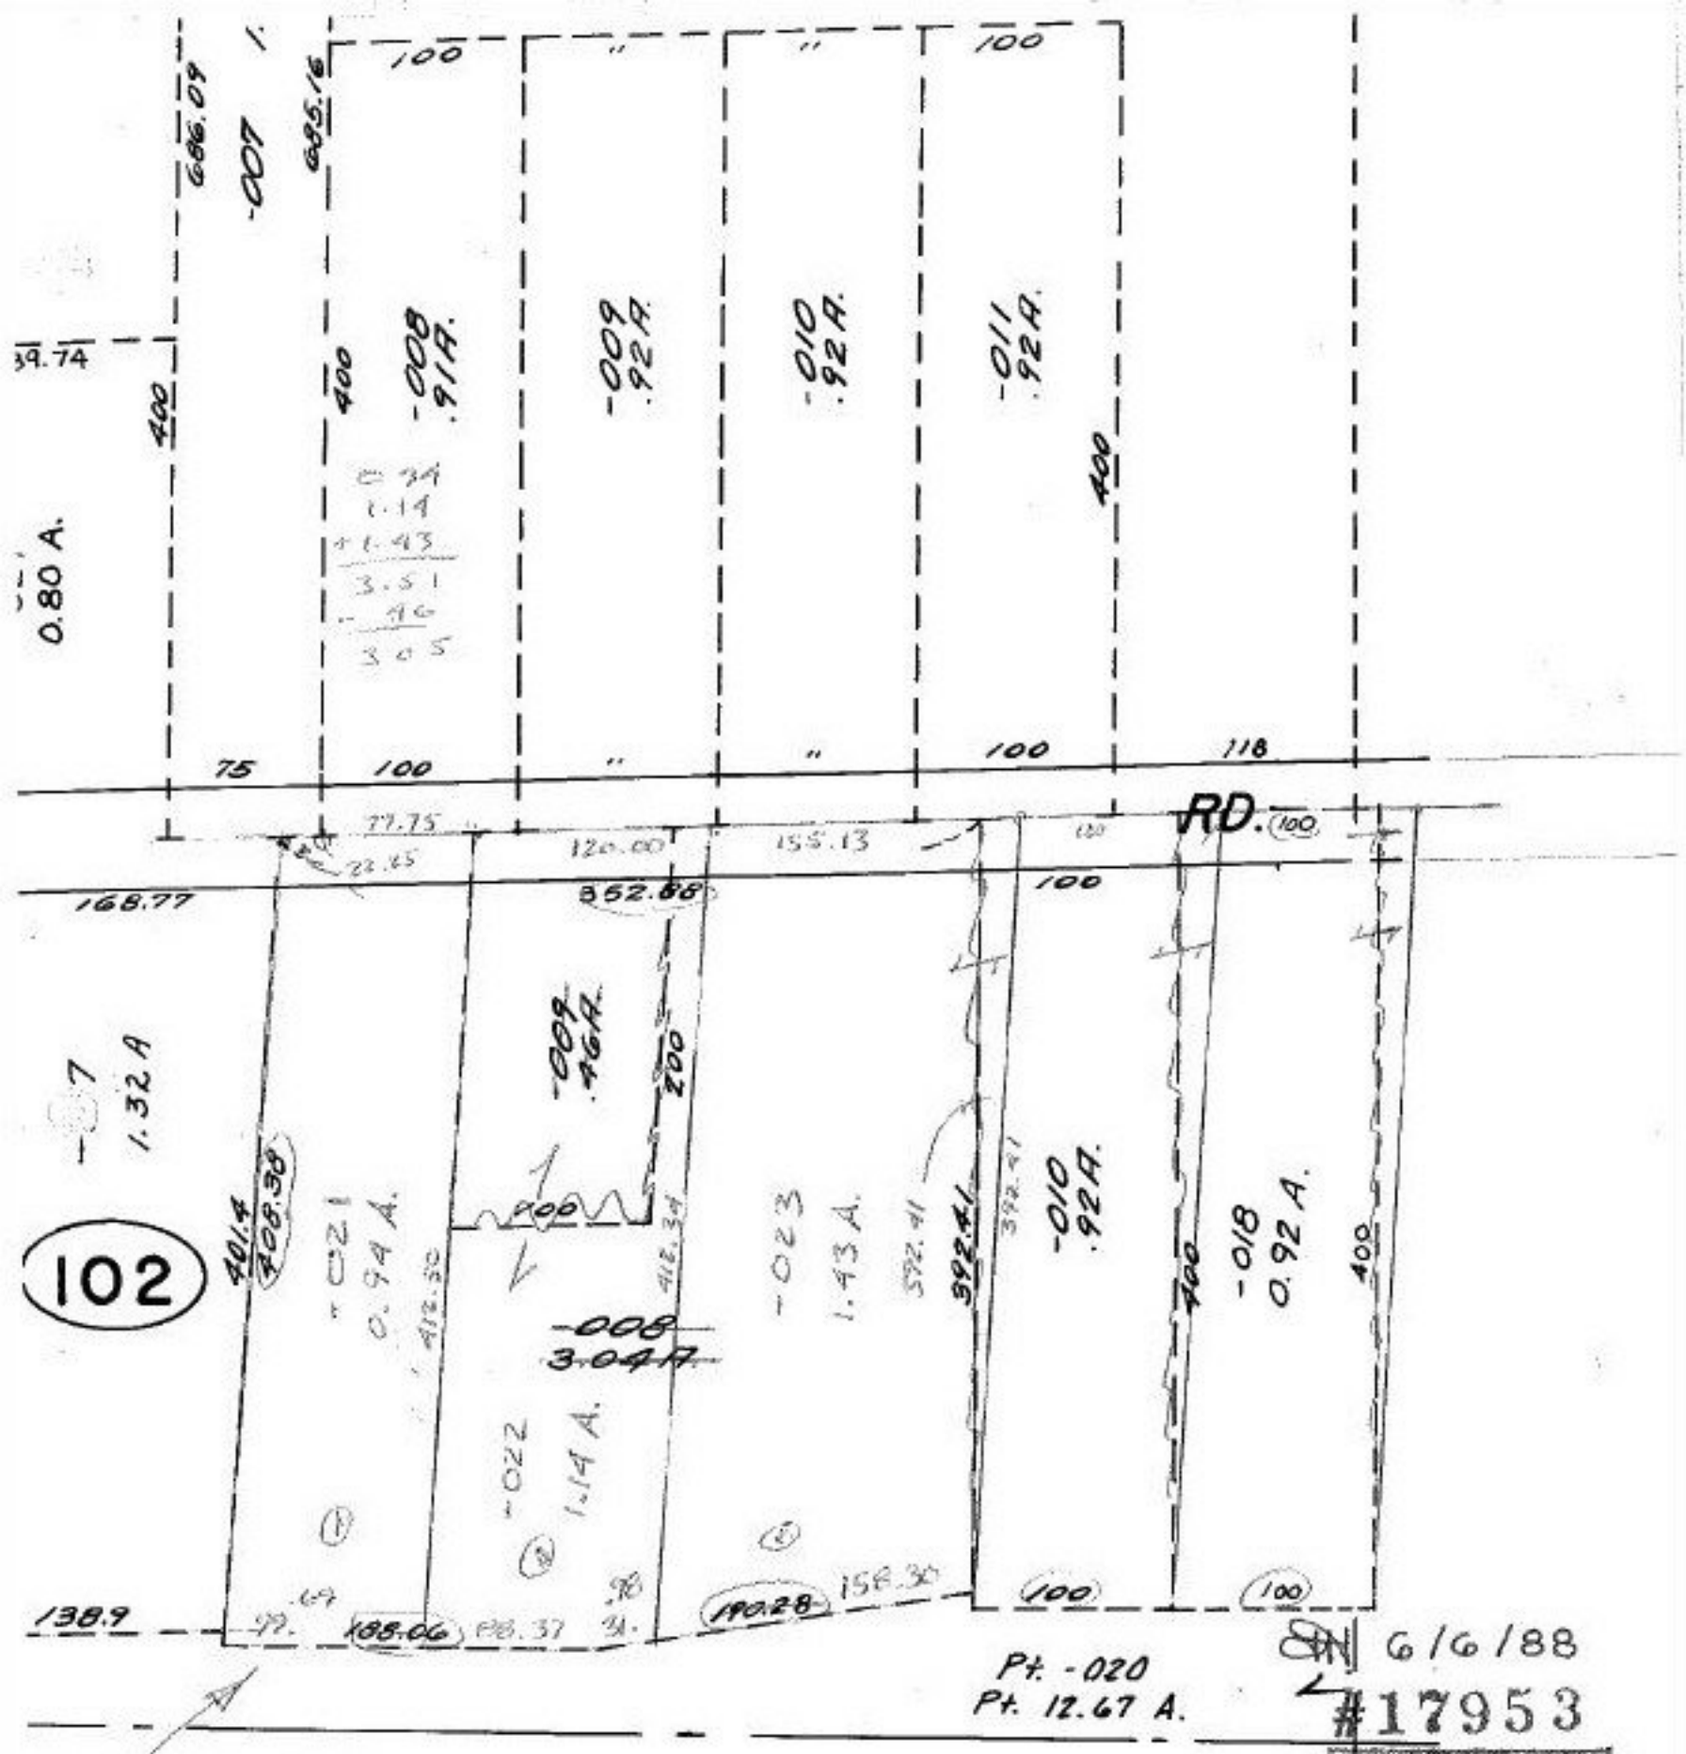

6/6/88

#17953

2-02-002-A

SEE SURVEY MAP K.S. ASSOC.

A. 1: 40,000

B. 1: 177,780

C. 1: INF

APPROVED
LORAIN CO.
MAP DEPT.

DATE 5-23-88

PAGE 2-02-002- A

BY T. Malain

VOID AFTER 17953