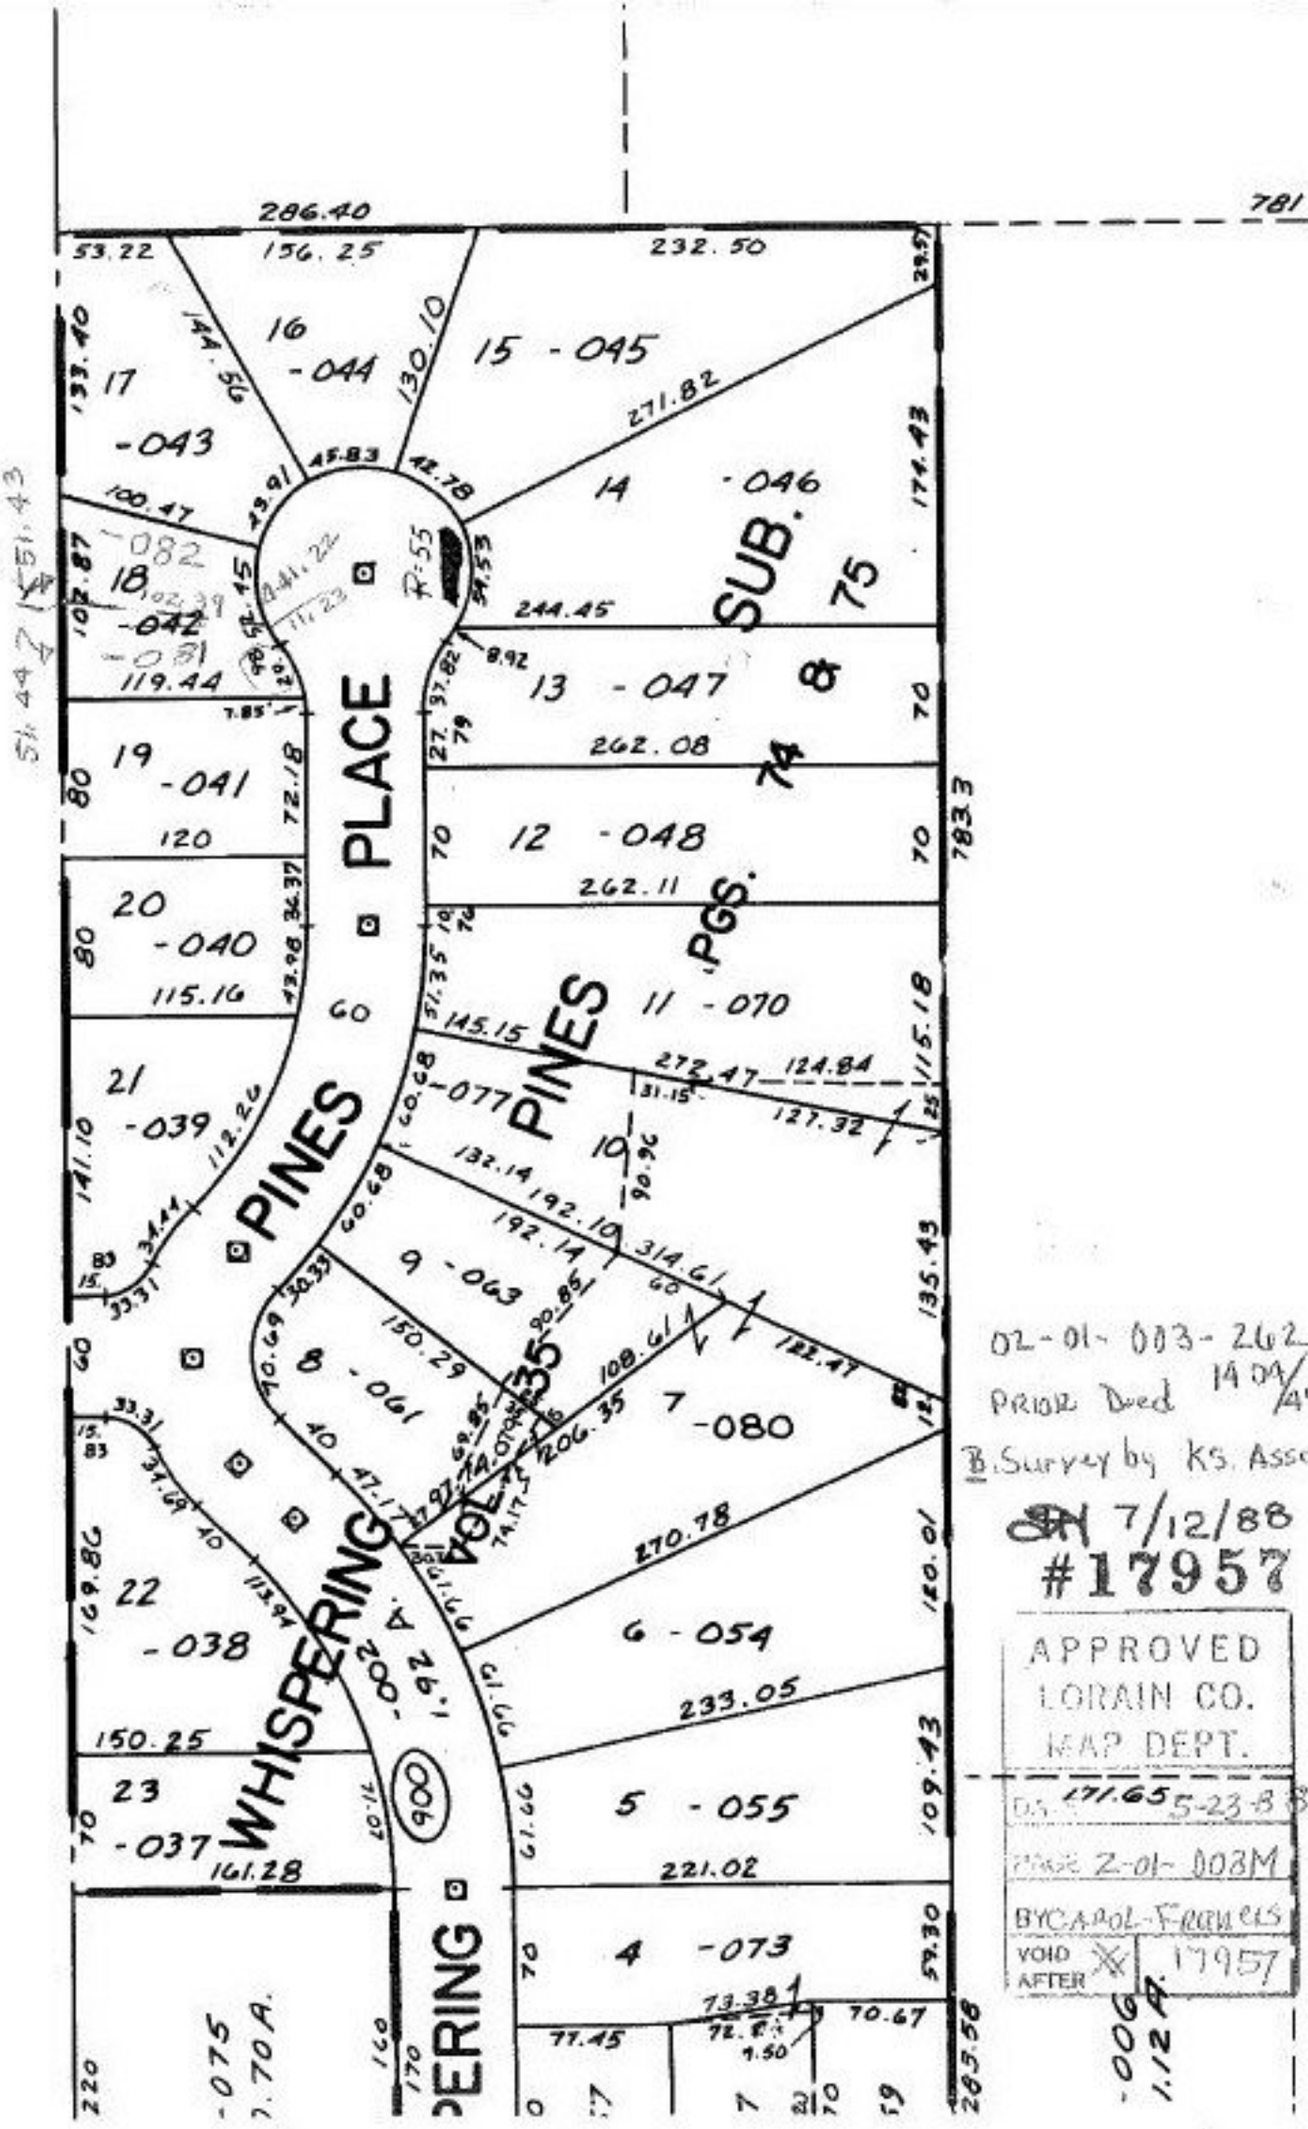
286.40
781
53.22
156.25
232.50
16
-044
15 -045
17
-043
14 -046
18
-042
-082
-081
19
-041
13 -047
20
-040
12 -048
21
-039
11 -070
10
-077
9 -063
8 -061
7 -080
22
-038
6 -054
23
-037
5 -055
4 -073
-075
-006
1.124 A.
PLACE
PINES
WHISPERING
VOL. 35 PGS. 900
SUB. 75
74 & 783.3
02-01-003-262
PRIOR Ded 1409/458
B. Survey by KS. Assoc.
7/12/88
#17957
APPROVED
LORAIN CO.
MAP DEPT.
D.S. 171.65 5-23-88
PAGE 2-01-003M
BY CAROL-Farmers
VOID AFTER X 17957