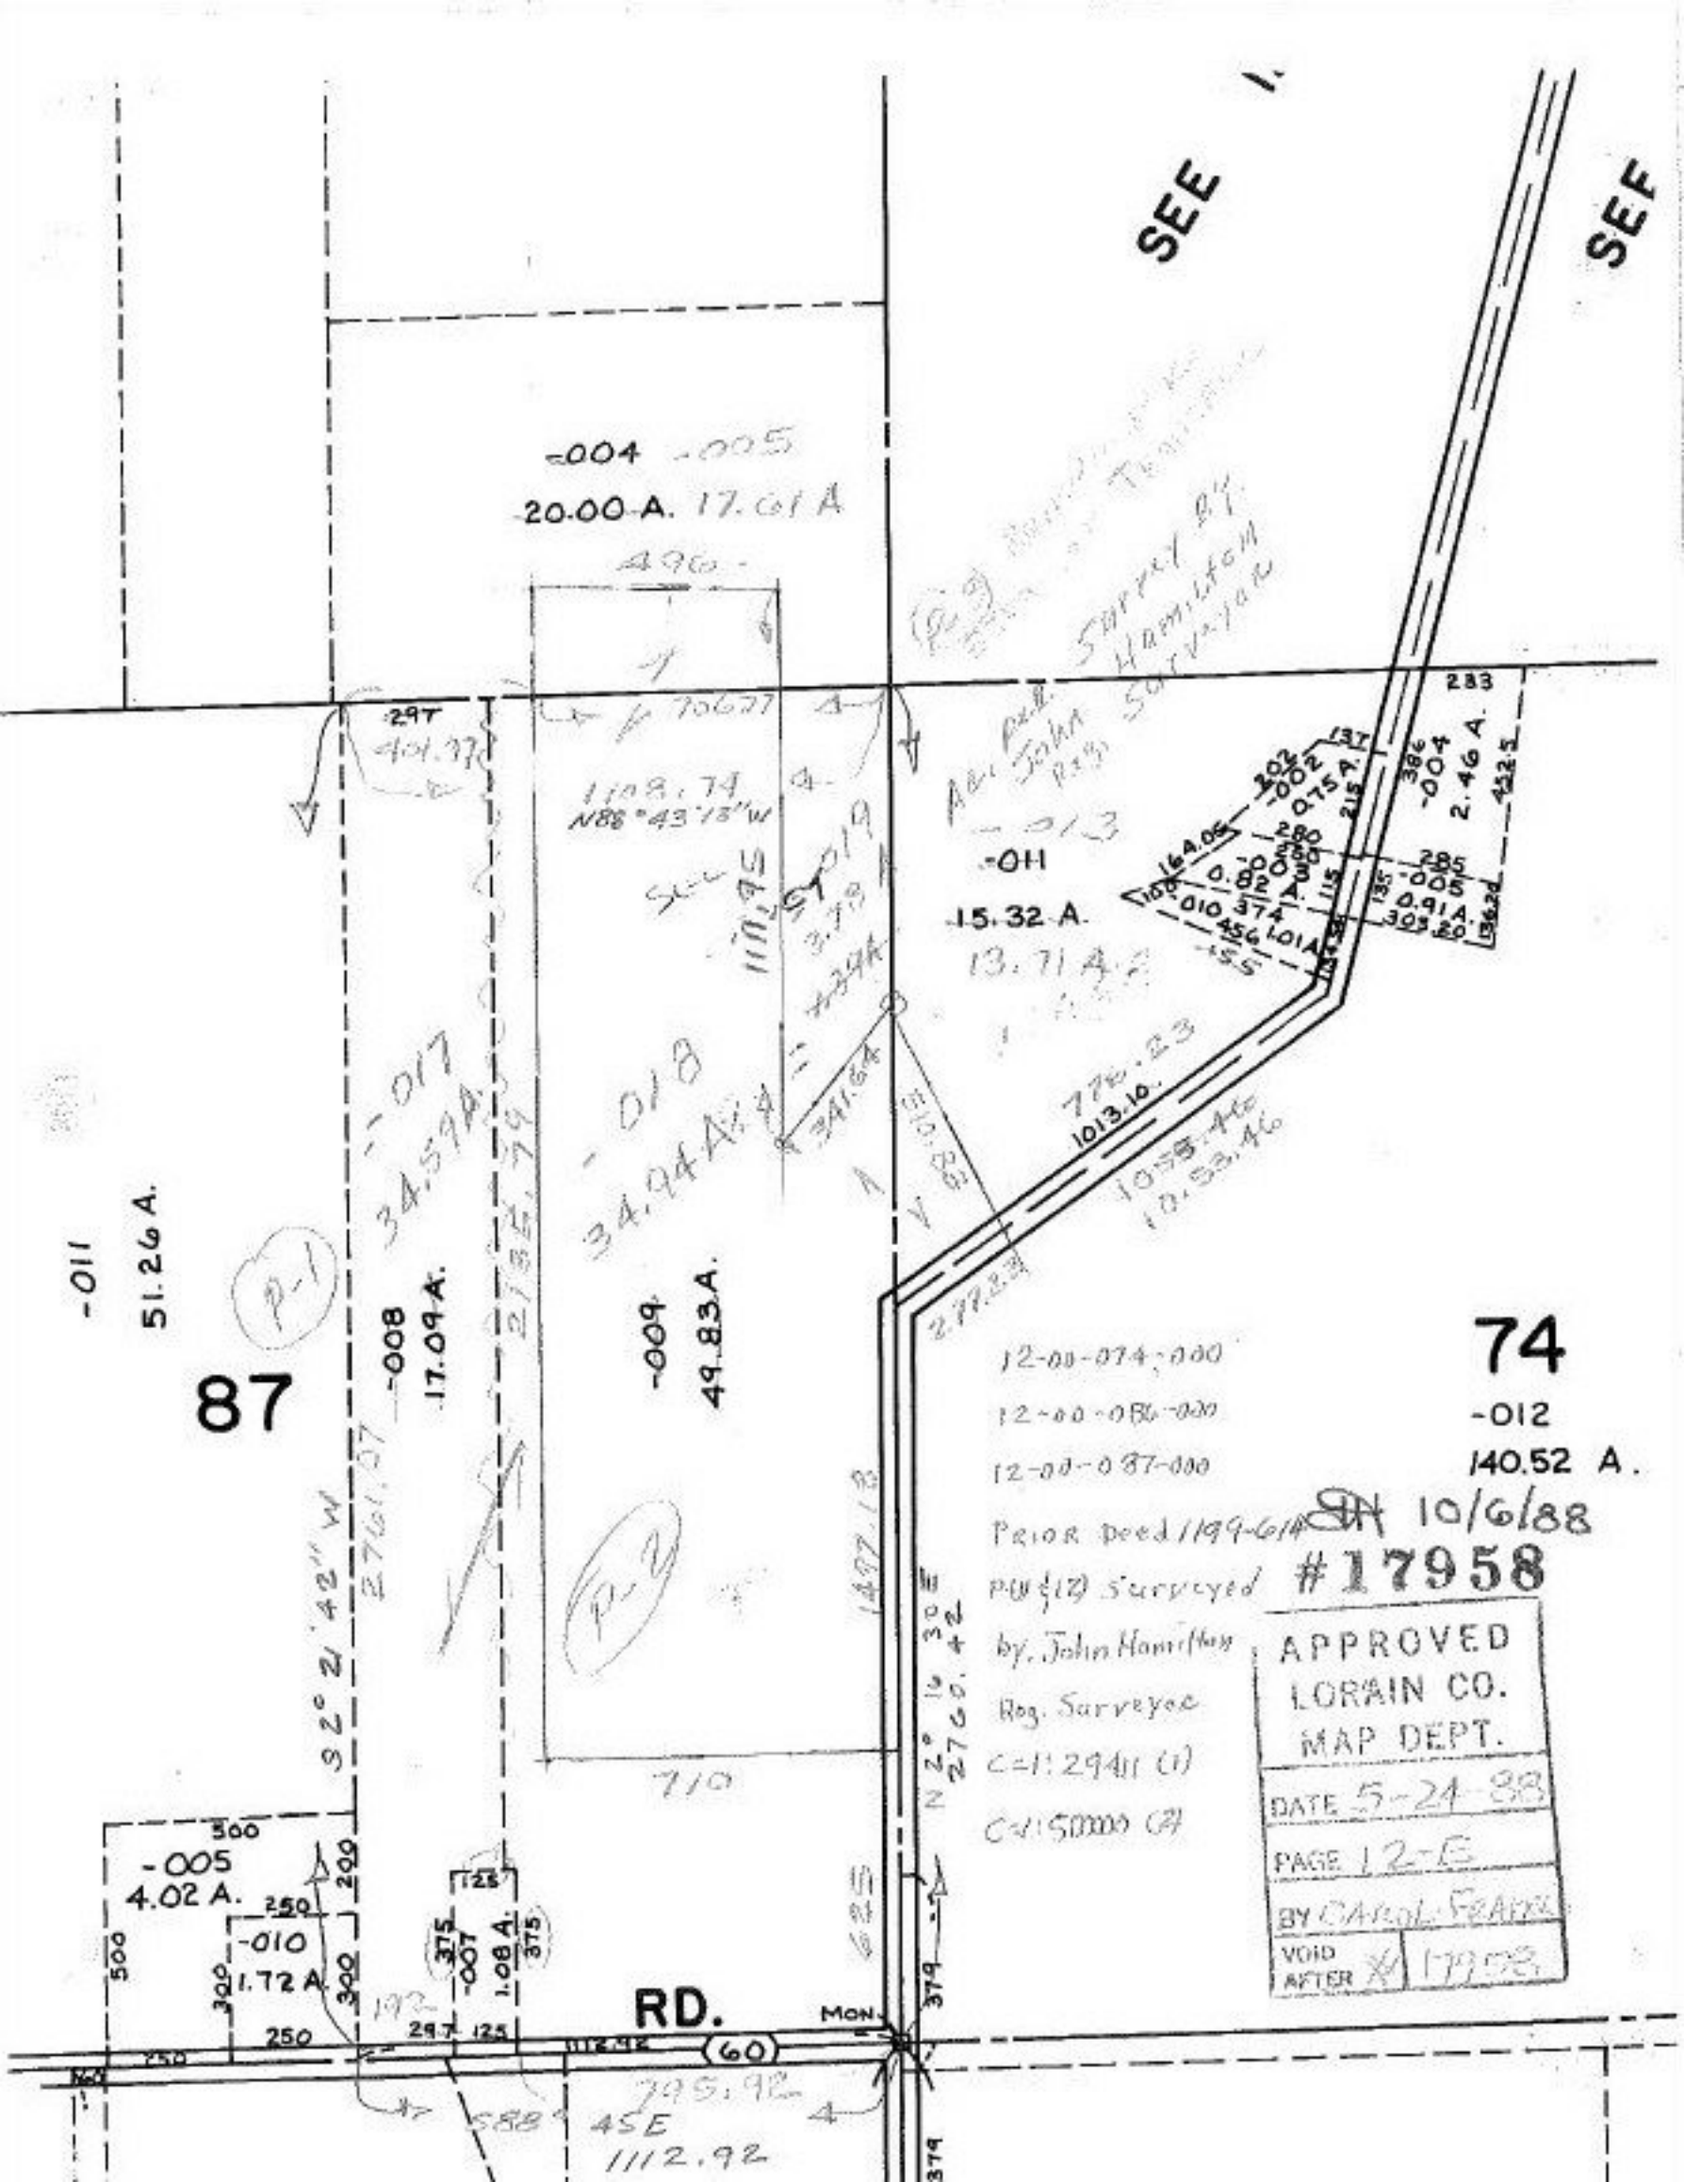
SEE
SEE
-004
20.00 A.
17.61 A
496
-005
-011
51.26 A.
87
-008
17.09 A.
-017
34.59 A.
-018
34.94 A.
-009
49.83 A.
-OH
15.32 A.
13.71 A.
-012
140.52 A.
74
12-00-074-000
12-00-086-000
12-00-087-000
Prior Deed 1199-614
P.U.(12) Surveyed
by John Hamilton
Reg. Surveyor
C=1:2941 (1)
C=1:5000 (2)
10/6/88
#17958
APPROVED
LORAIN CO.
MAP DEPT.
DATE 5-24-88
PAGE 12-E
BY CAROL FRANK
-005
4.02 A.
-010
1.72 A.
-007
1.08 A.
RD.
60
MON
710
1112.92
N 2° 16' 30" E
2760.42
S 2° 21' 42" W
2701.57
1109.74
N88°43'15"W
111.95
341.64
1013.10
1055.46
10.53.46
1112.92
S88°45E
295.92