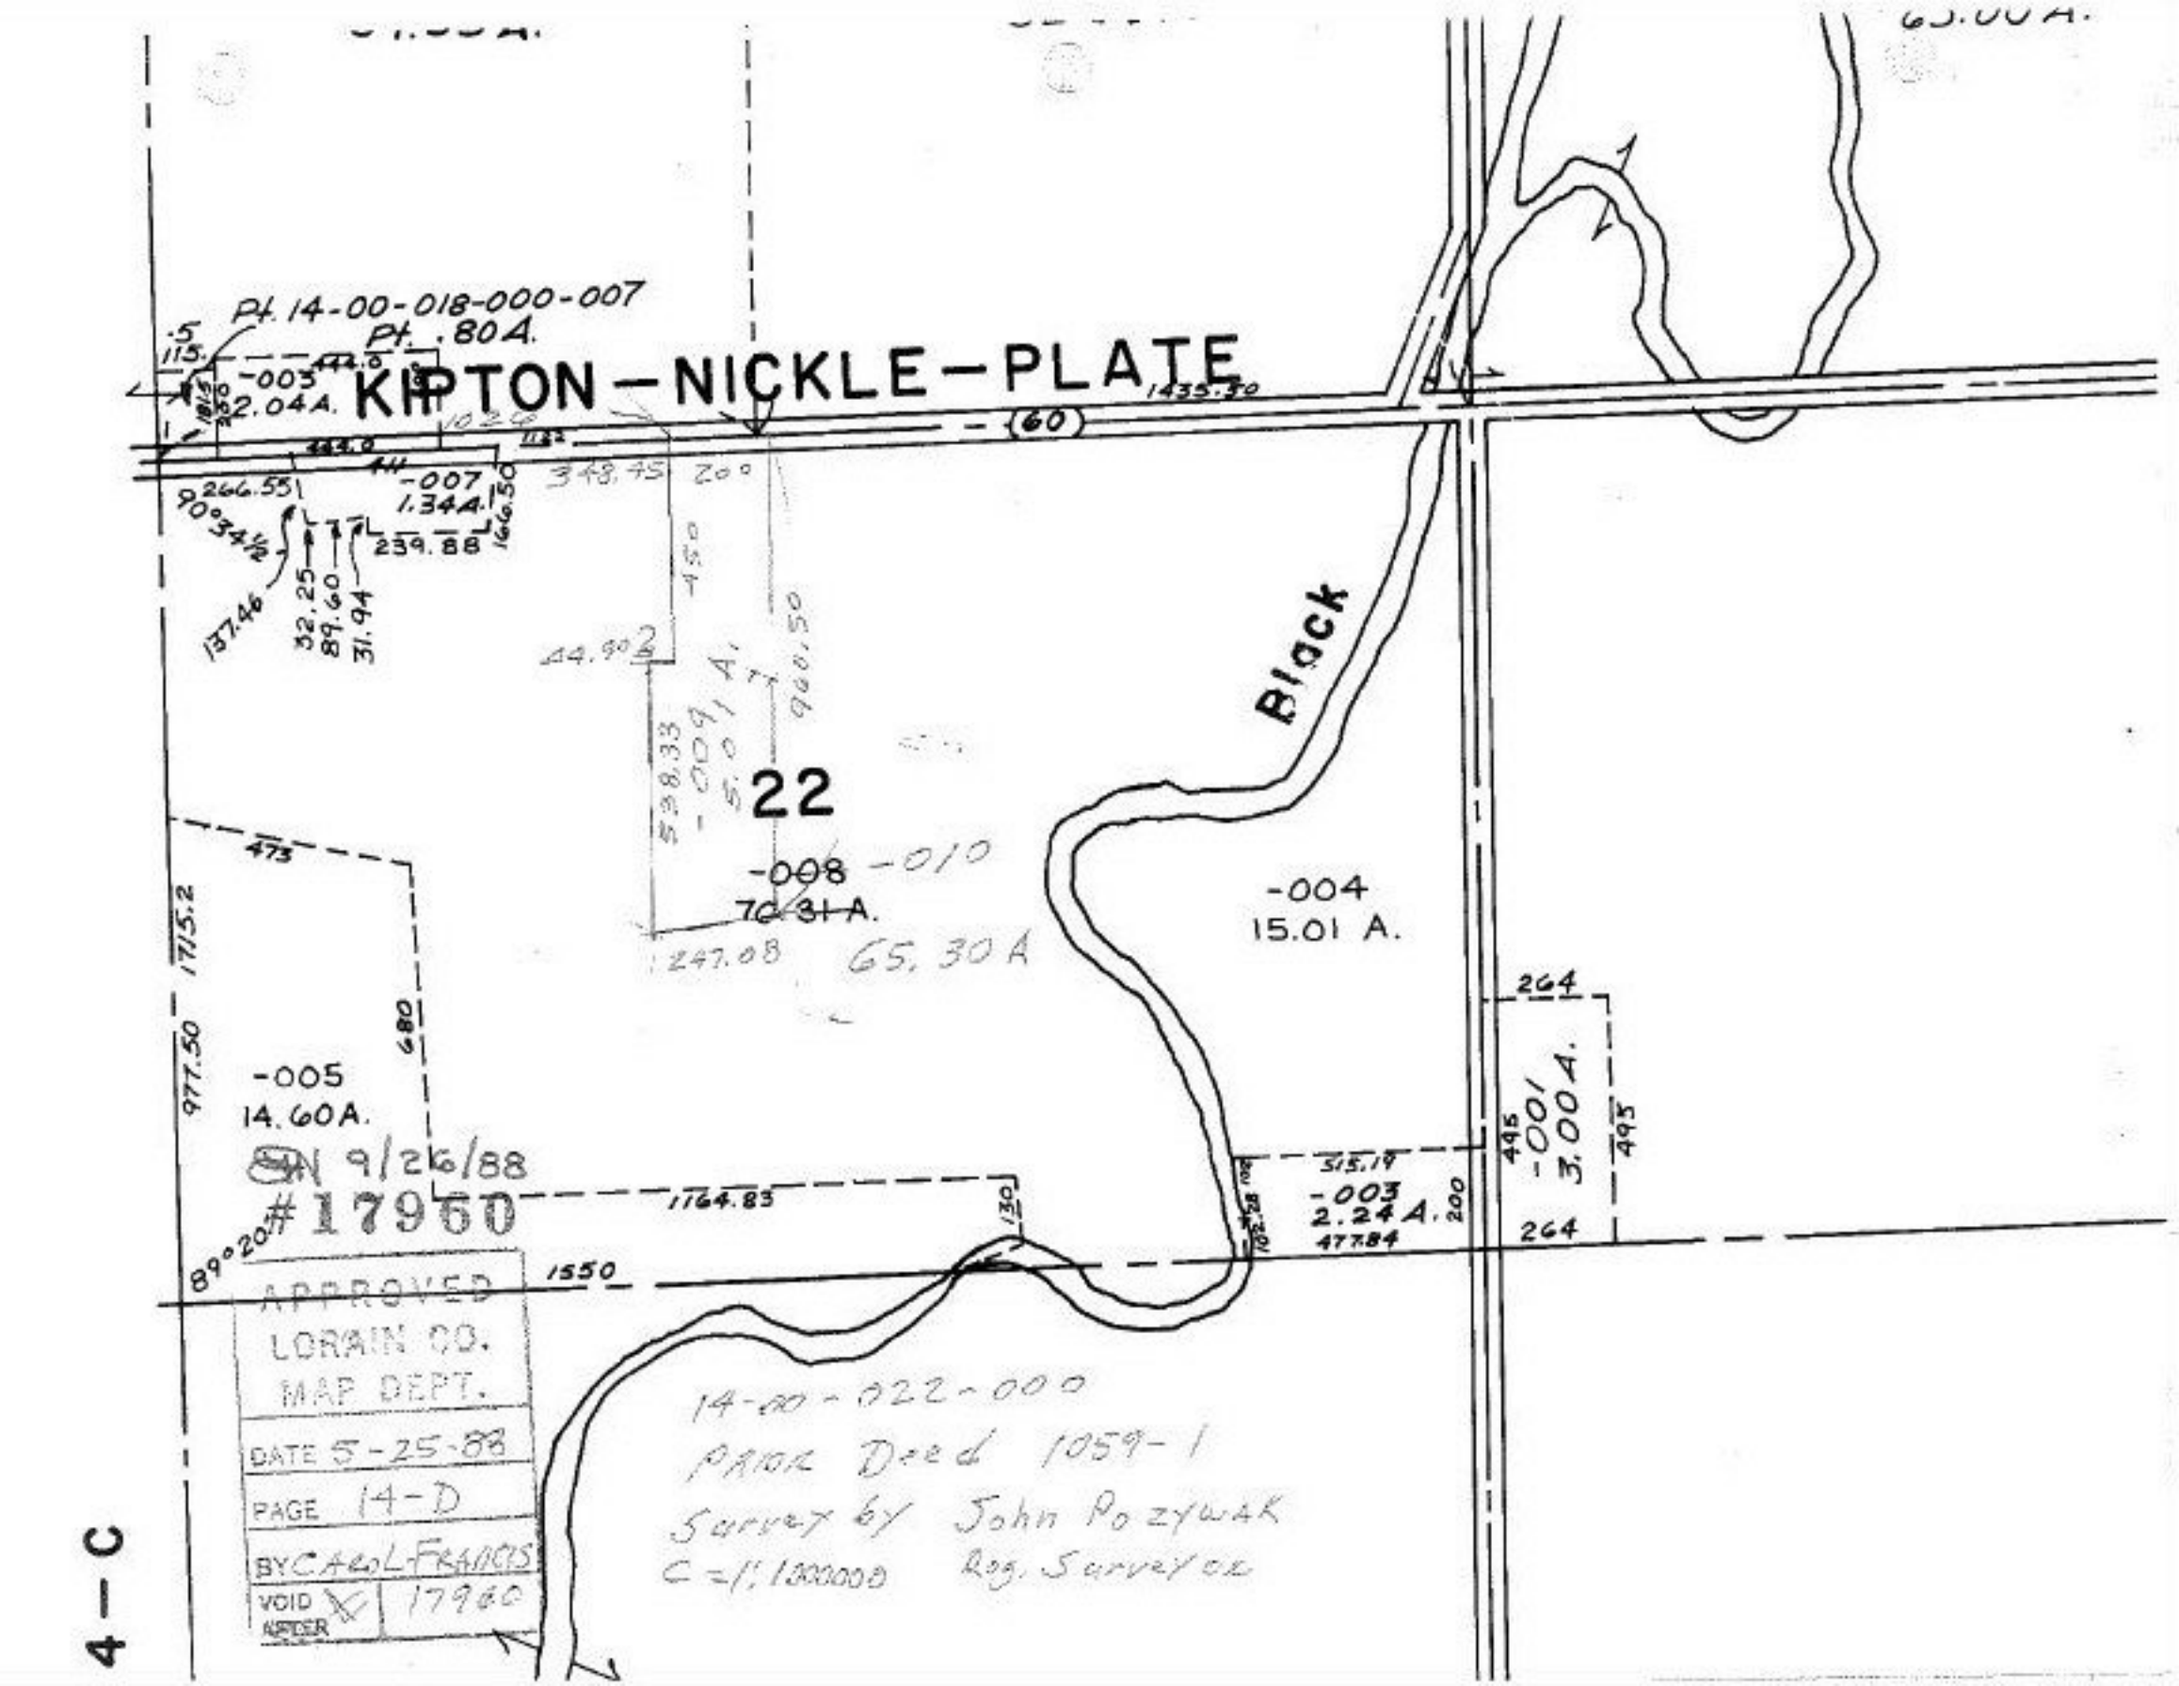

KIPTON-NICKLE-PLATE
Pt. 14-00-018-000-007
Pt. .80A.
-003
2.04A.
-007
1.34A.
-008
70.31 A.
-010
65.30 A
22
-004
15.01 A.
-005
14.60A.
-003
2.24 A.
-001
3.00 A.
Black
(60)
1435.50
348.45
266.55
239.88
137.46
32.25
89.60
31.94
538.33
247.08
1164.83
1550
1715.2
977.50
680
473
264
495
515.19
477.84
200
130
14-00-022-000
PRIOR Deed 1059-1
Survey by John Pozywak
C=1:1000000 Reg. Surveyor
APPROVED
LORAIN CO.
MAP DEPT.
DATE 5-25-88
PAGE 14-D
BY CAROL FRANCIS
VOID AFTER 17960

4-C