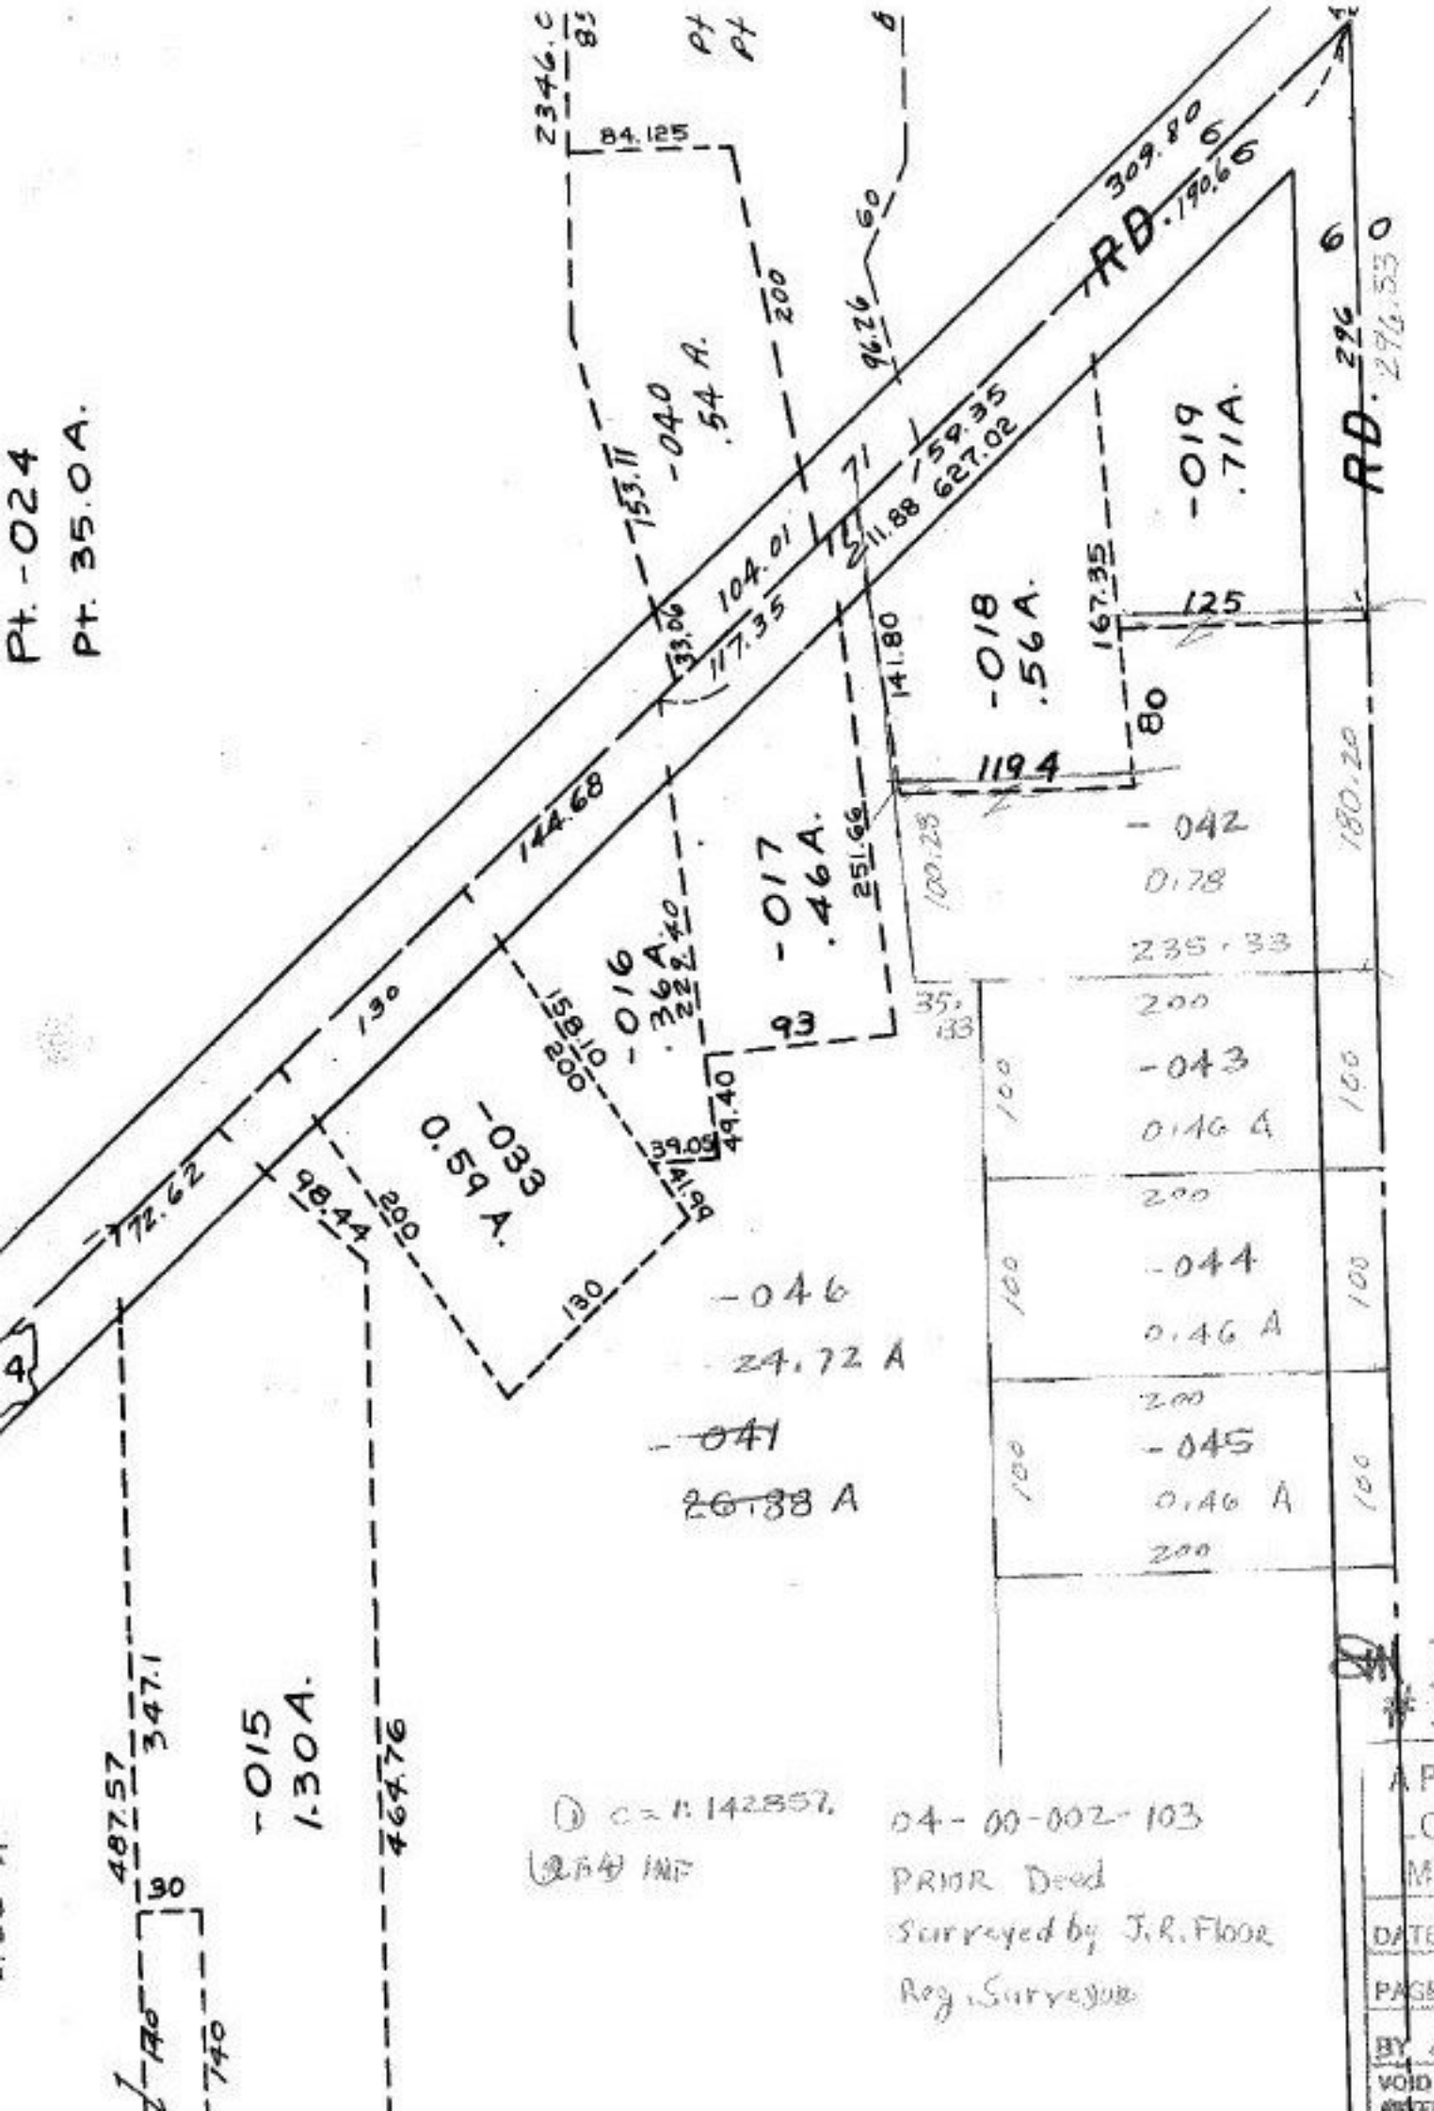

7/21/88
#17961

APPROVED
LORAIN CO.
MAP DEPT.

DATE 5-25-88
PAGE 4-00-002-H
BY CAROL FRANKS
VOID AFTER X 17961