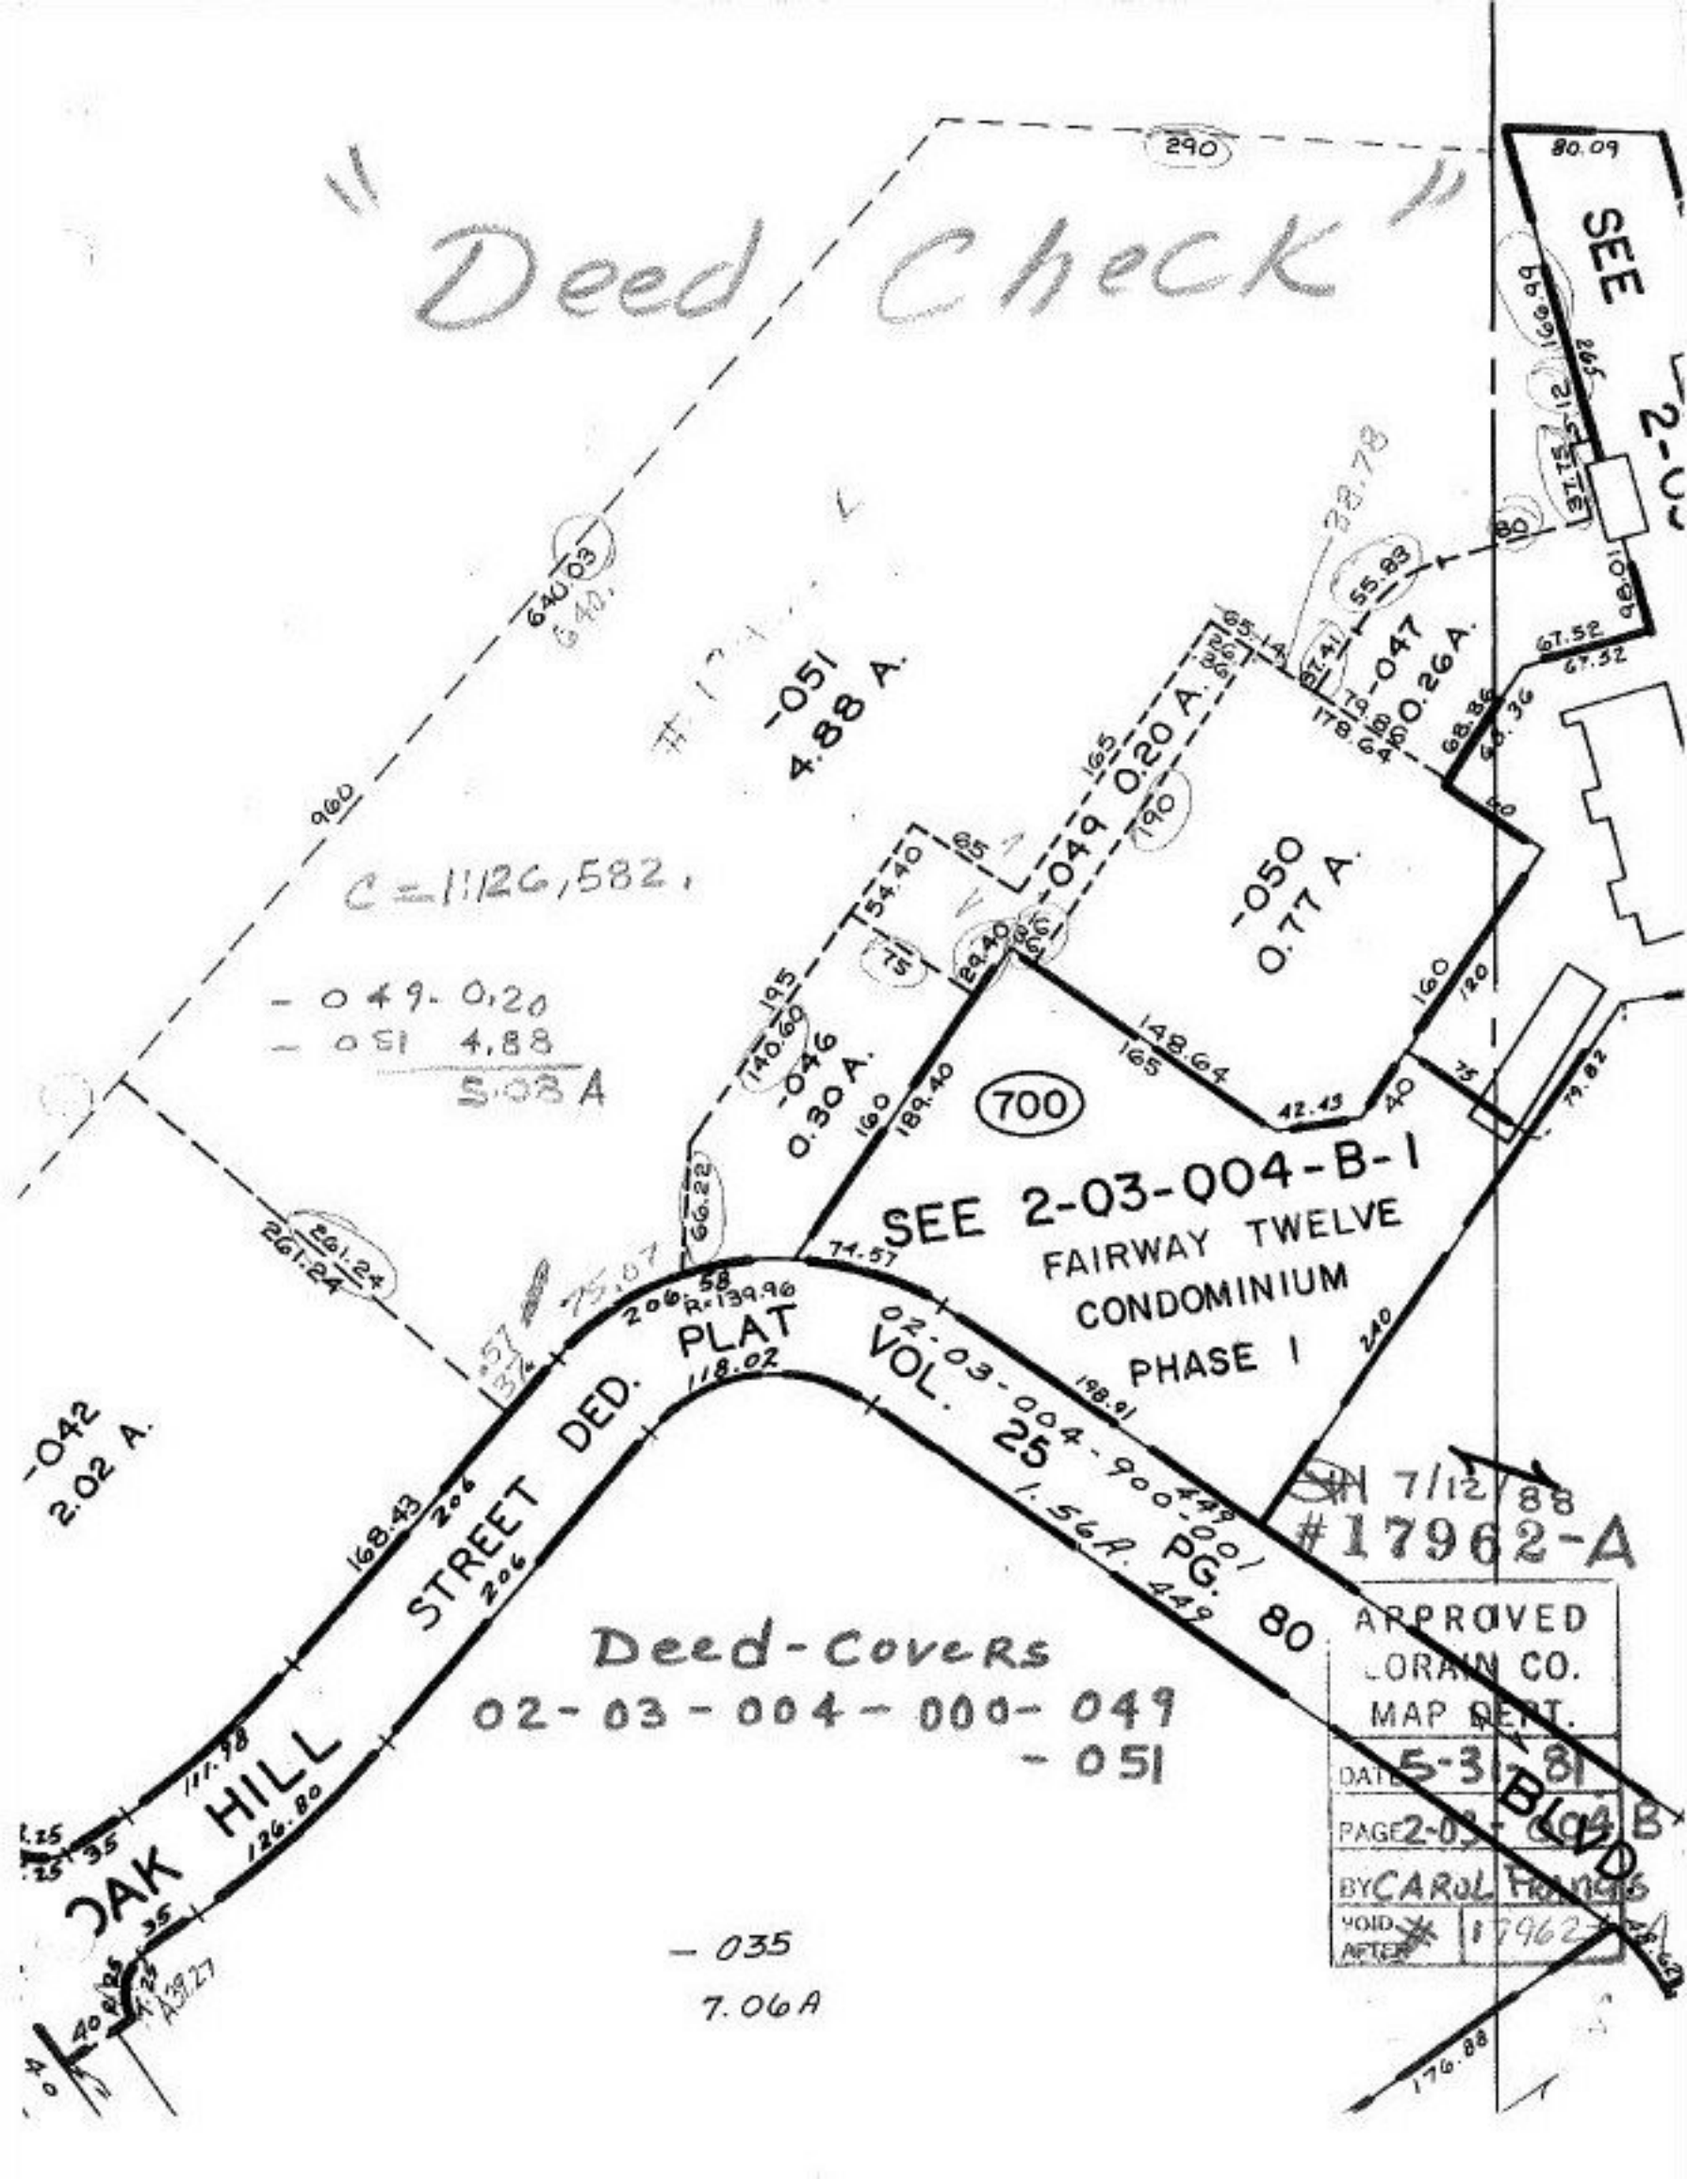
"Deed Check"
SEE 2-03-004-B-1
FAIRWAY TWELVE
CONDOMINIUM
PHASE 1
700
-051
4.88 A.
-049 0.20 A.
-050
0.77 A.
-047
0.26 A.
-046
0.30 A.
-042
2.02 A.
C=1126,582.
-049-0,20
-051 4,88
5.08 A
OAK HILL
STREET DED.
PLAT
VOL. 25
PG. 80
02-03-004-900-001
1.56 A.
449
Deed-Covers
02-03-004-000-049
-051
-035
7.06 A
7/12/88
#17962-A
APPROVED
LORAIN CO.
MAP DEPT.
DATE 5-3-81
PAGE 2-03-004 B
BY CAROL Francis
VOID AFTER 17962-A