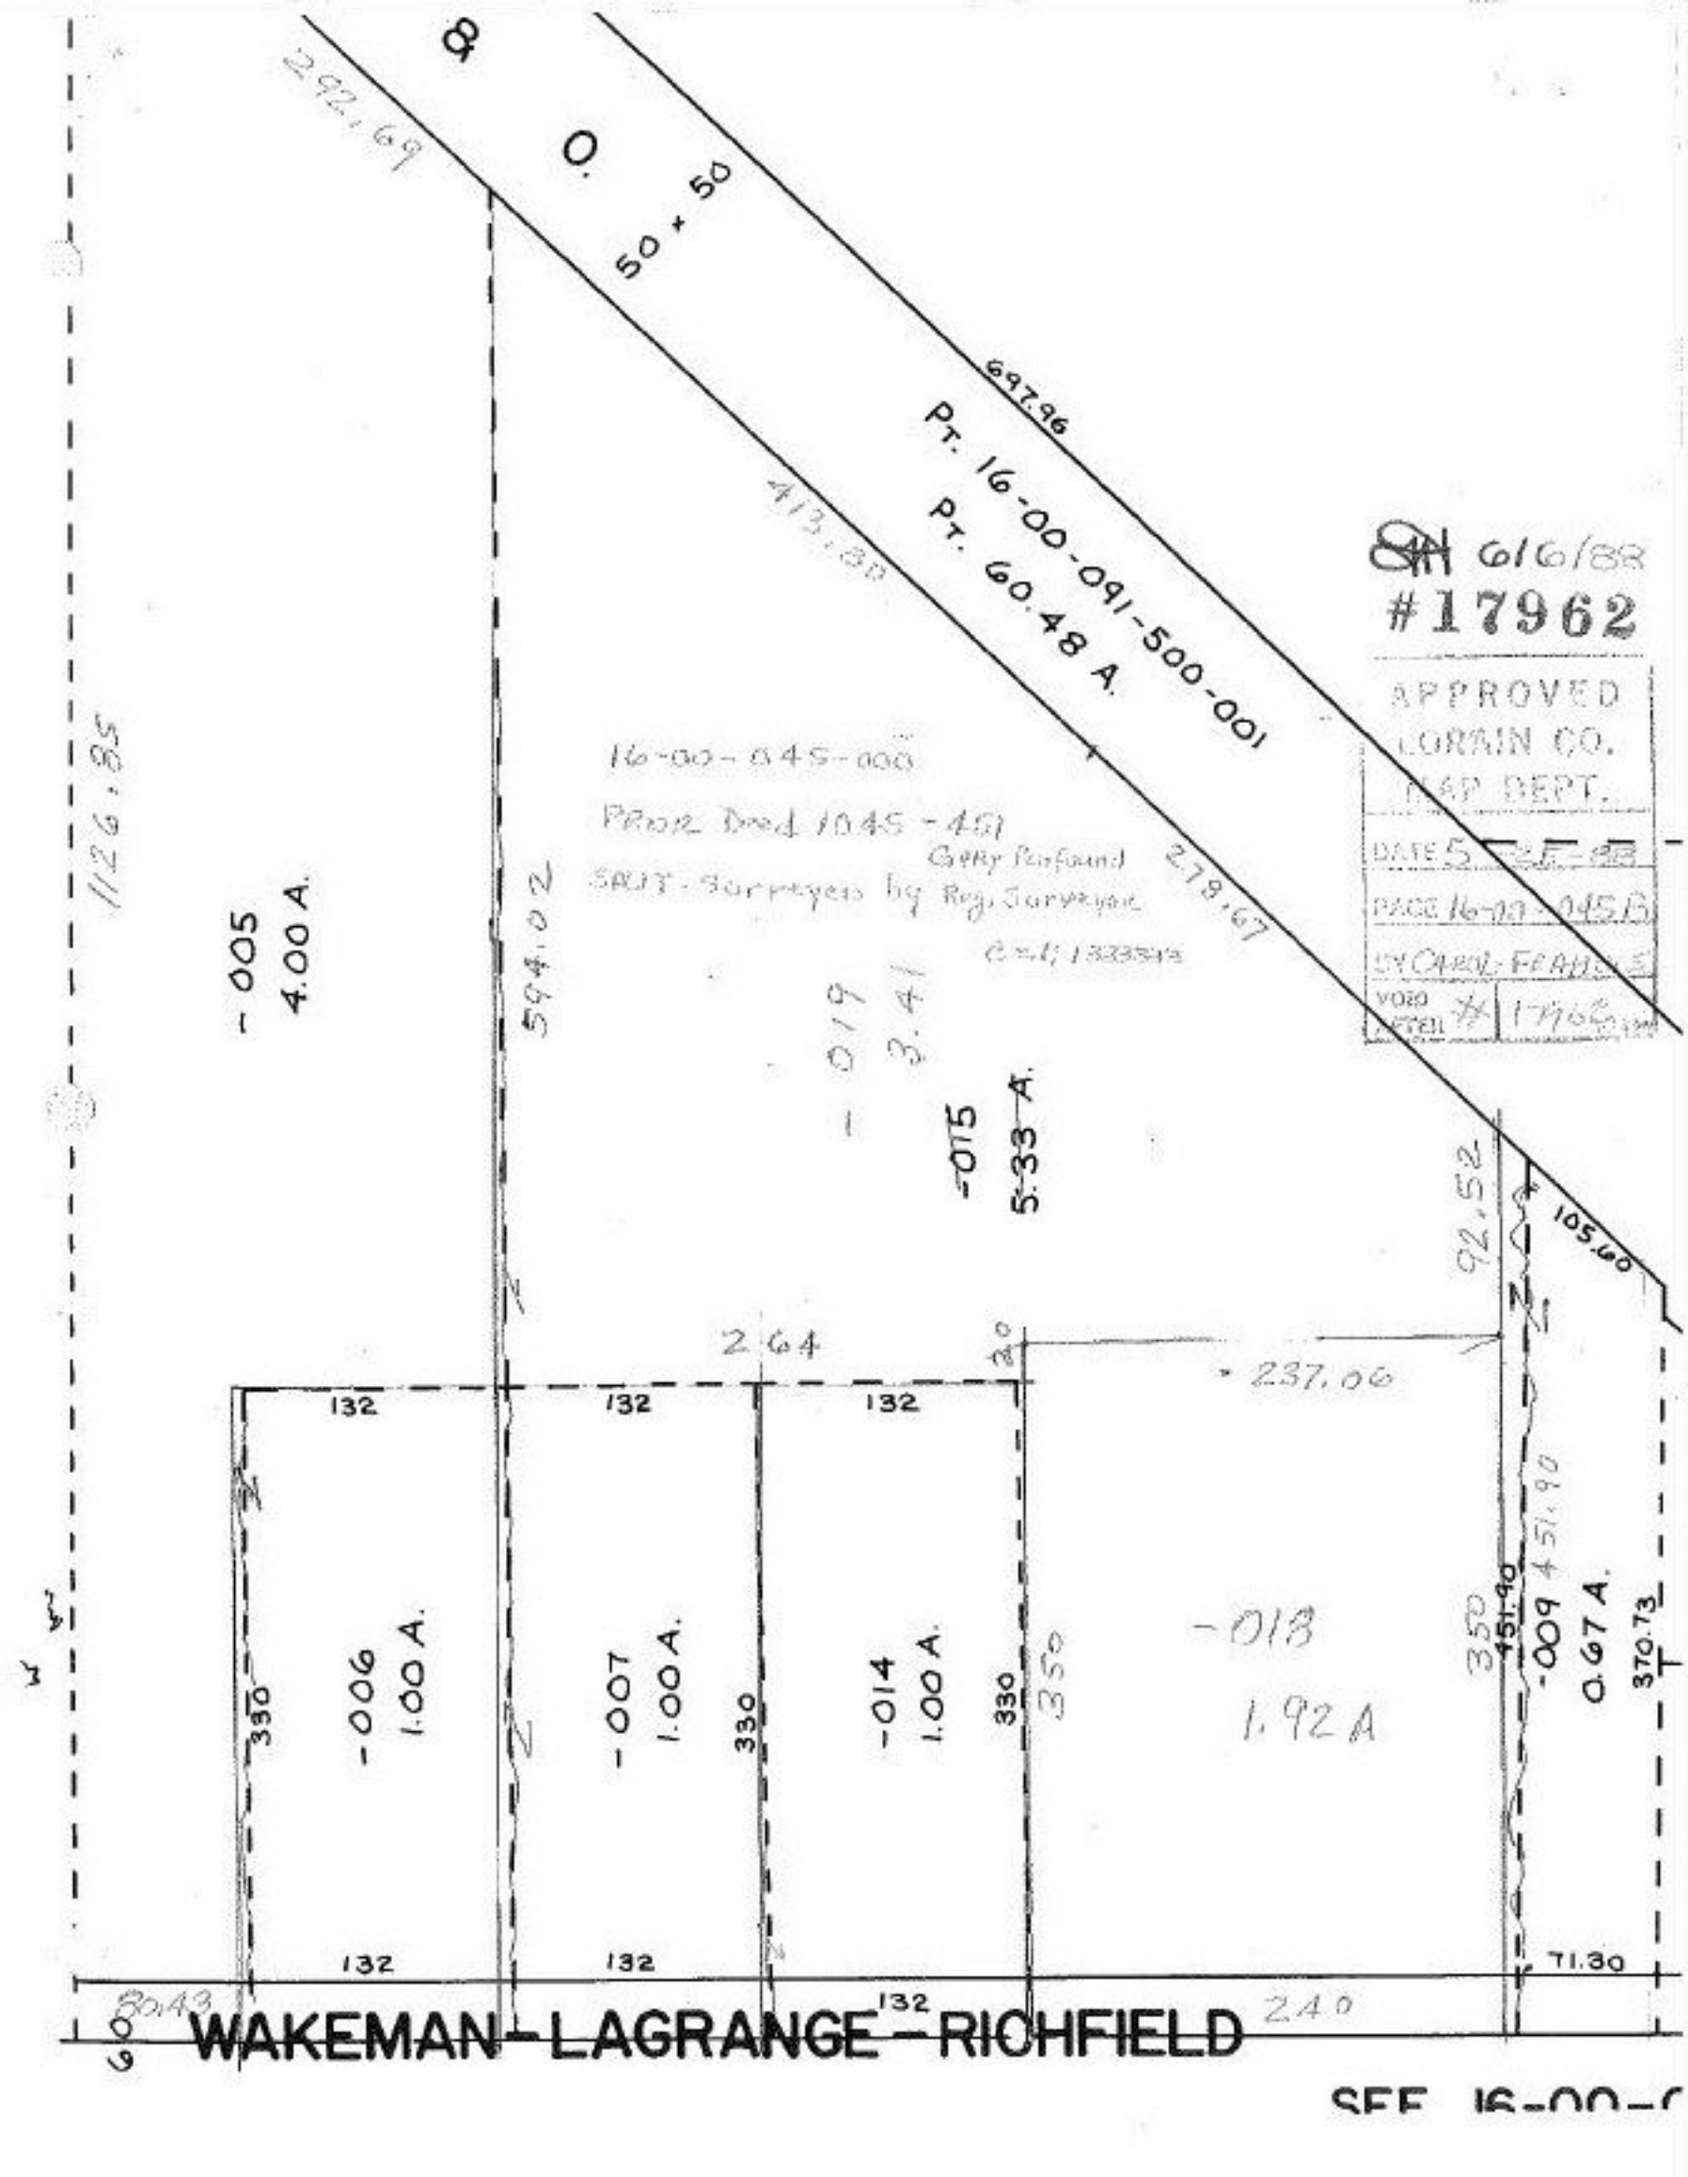
50 + 50
697.96
Pt. 16-00-091-500-001
Pt. 60.48 A.
413.30
279.67
292.69
1126.85
16-00-045-000
Prior Ded 1045-451
Gary Rayfound
SBJT - Surveyed by Reg. Surveyor
C.S.# 1323343
-005
4.00 A.
594.02
-019
3.41
-015
5.33 A.
6/6/88
#17962
APPROVED
LORAIN CO.
MAP DEPT.
DATE 5-27-88
PAGE 16-00-045B
BY CAROL FRANCIS
VOID PARCEL # 17966
92.52
105.60
264
20
237.06
132
132
132
132
132
132
-006
1.00 A.
-007
1.00 A.
-014
1.00 A.
-018
1.92 A
-009
0.67 A.
451.90
370.73
350
330
330
350
71.30
240
WAKEMAN - LAGRANGE - RICHFIELD
SEE 16-00-