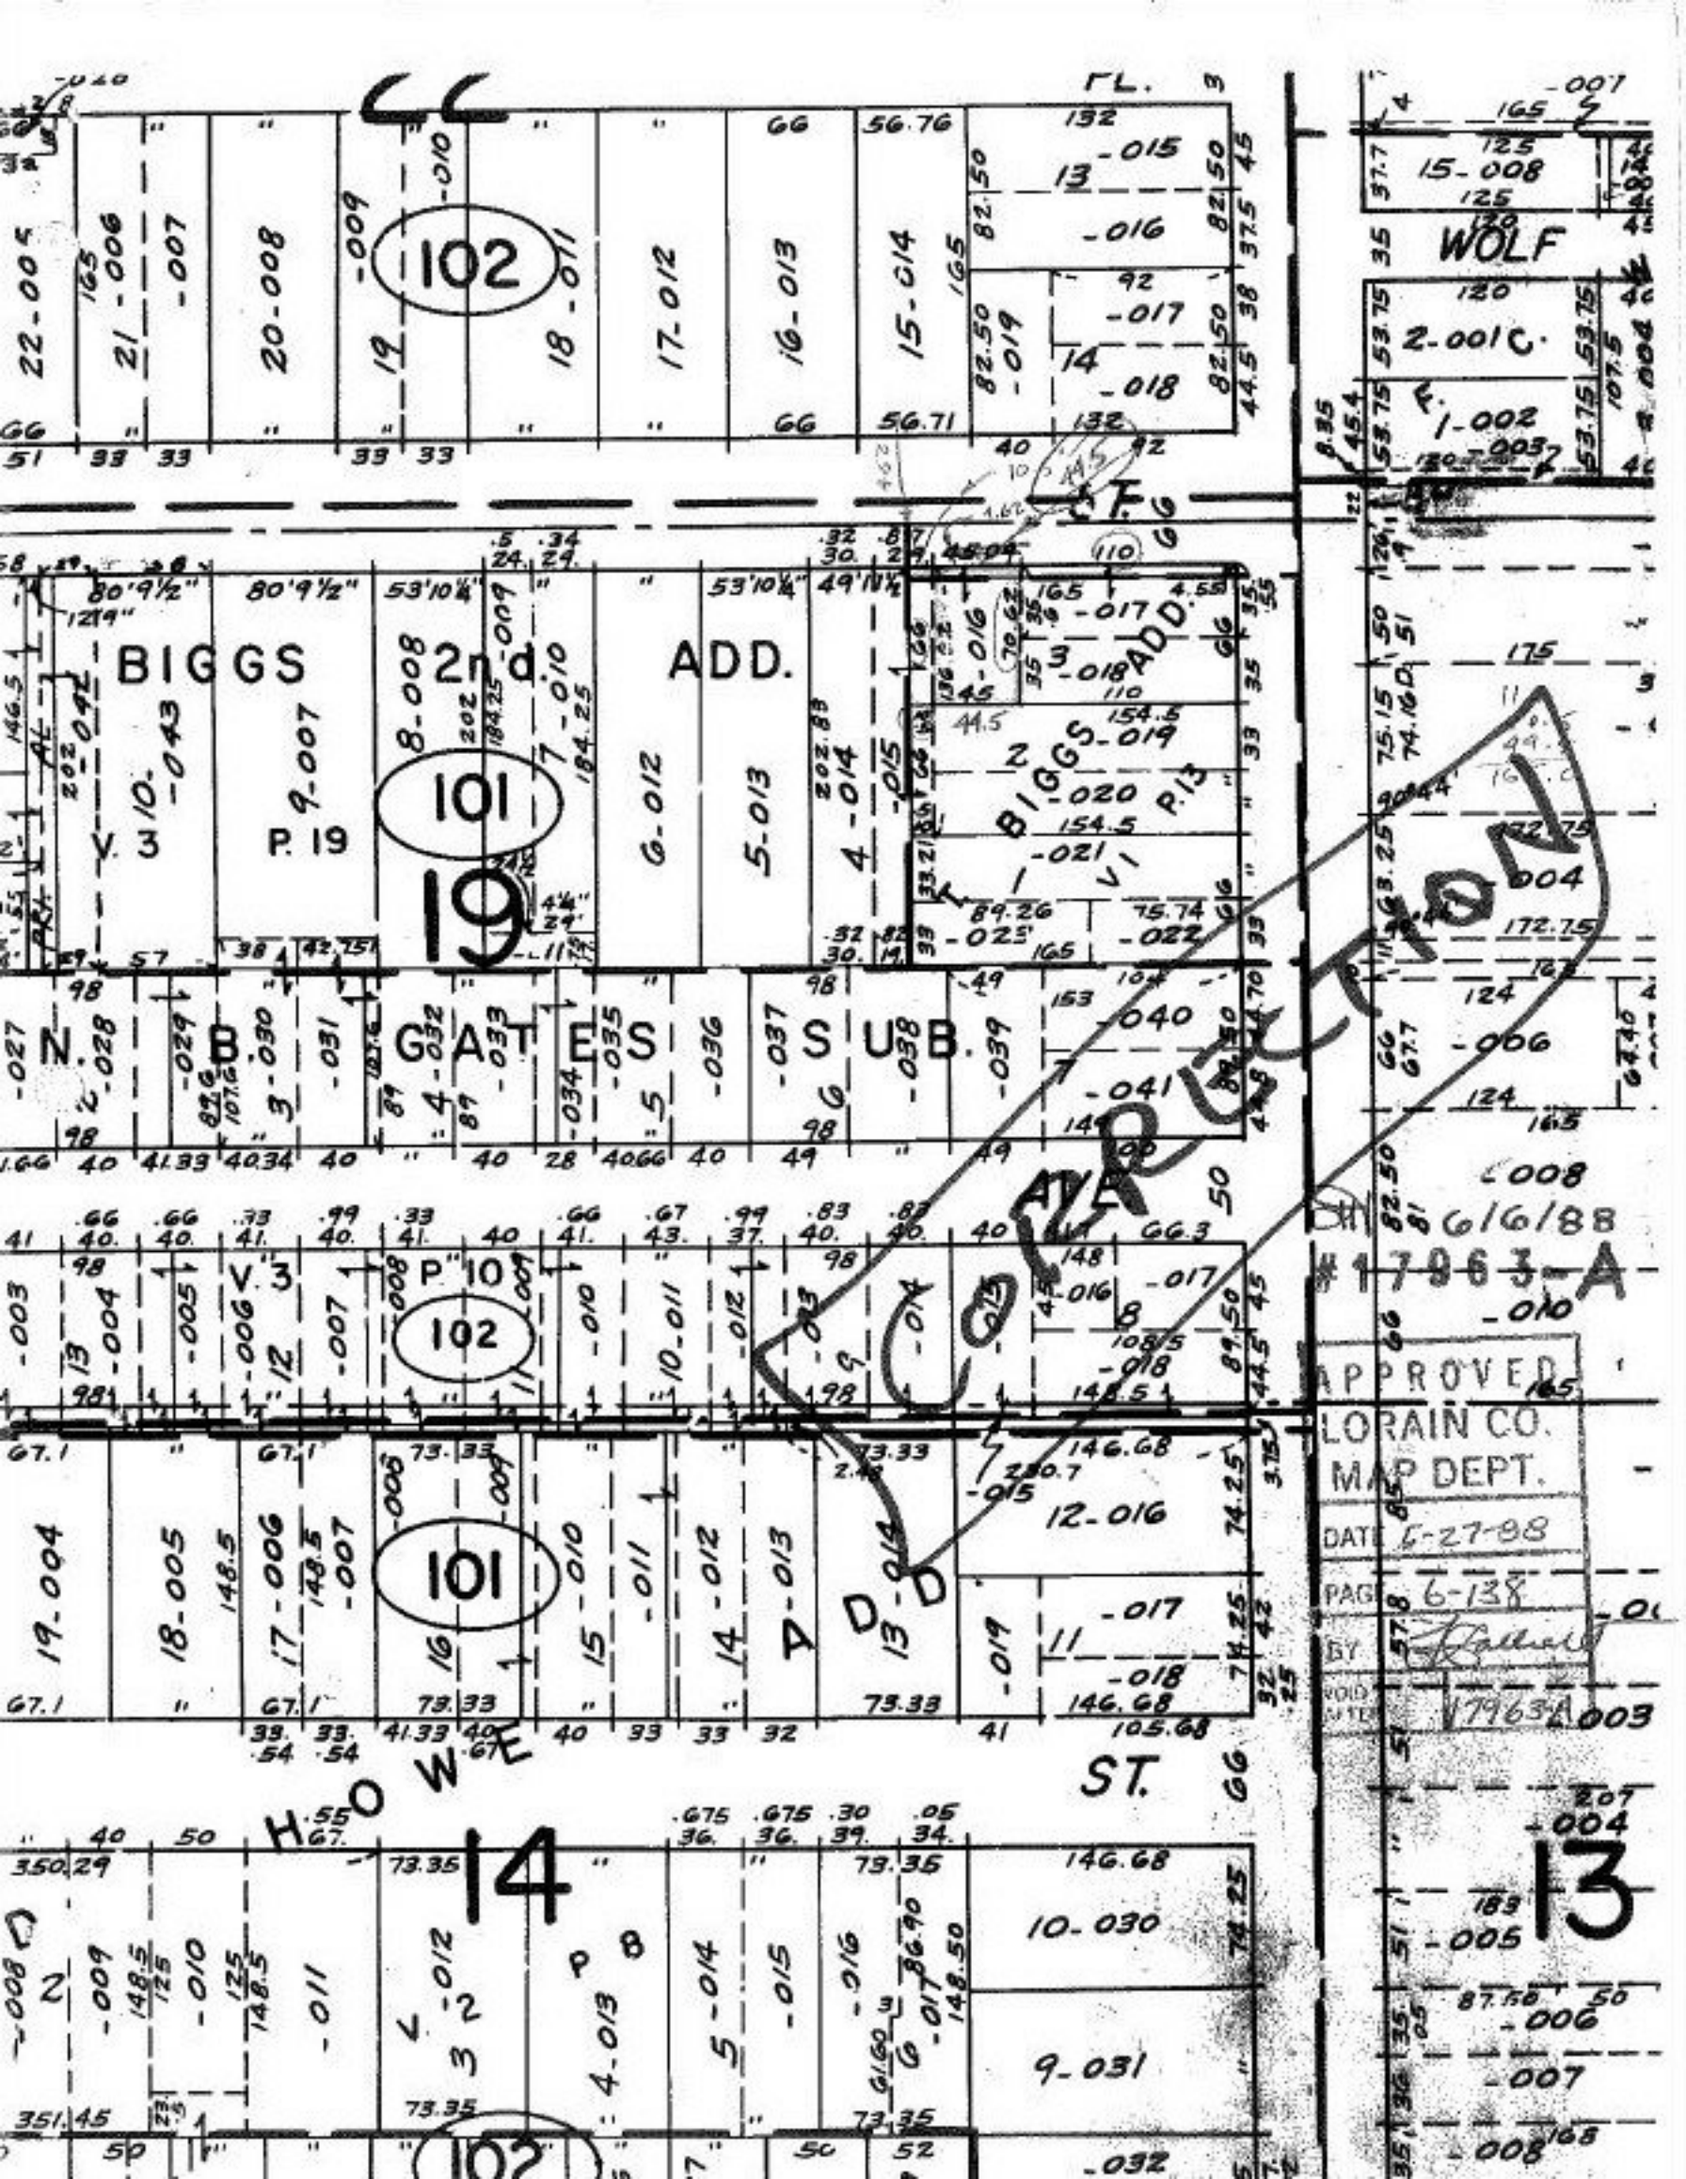

CC
102
WOLF
BIGGS 2nd ADD.
101
19
N. B. GATES SUB.
AVE
CORRECTION
6/6/88
#17963-A
APPROVED
LORAIN CO.
MAP DEPT.
DATE 6-27-88
PAGE 6-138
BY
VOID AFTER 17963-A
HOWE ST.
14
13