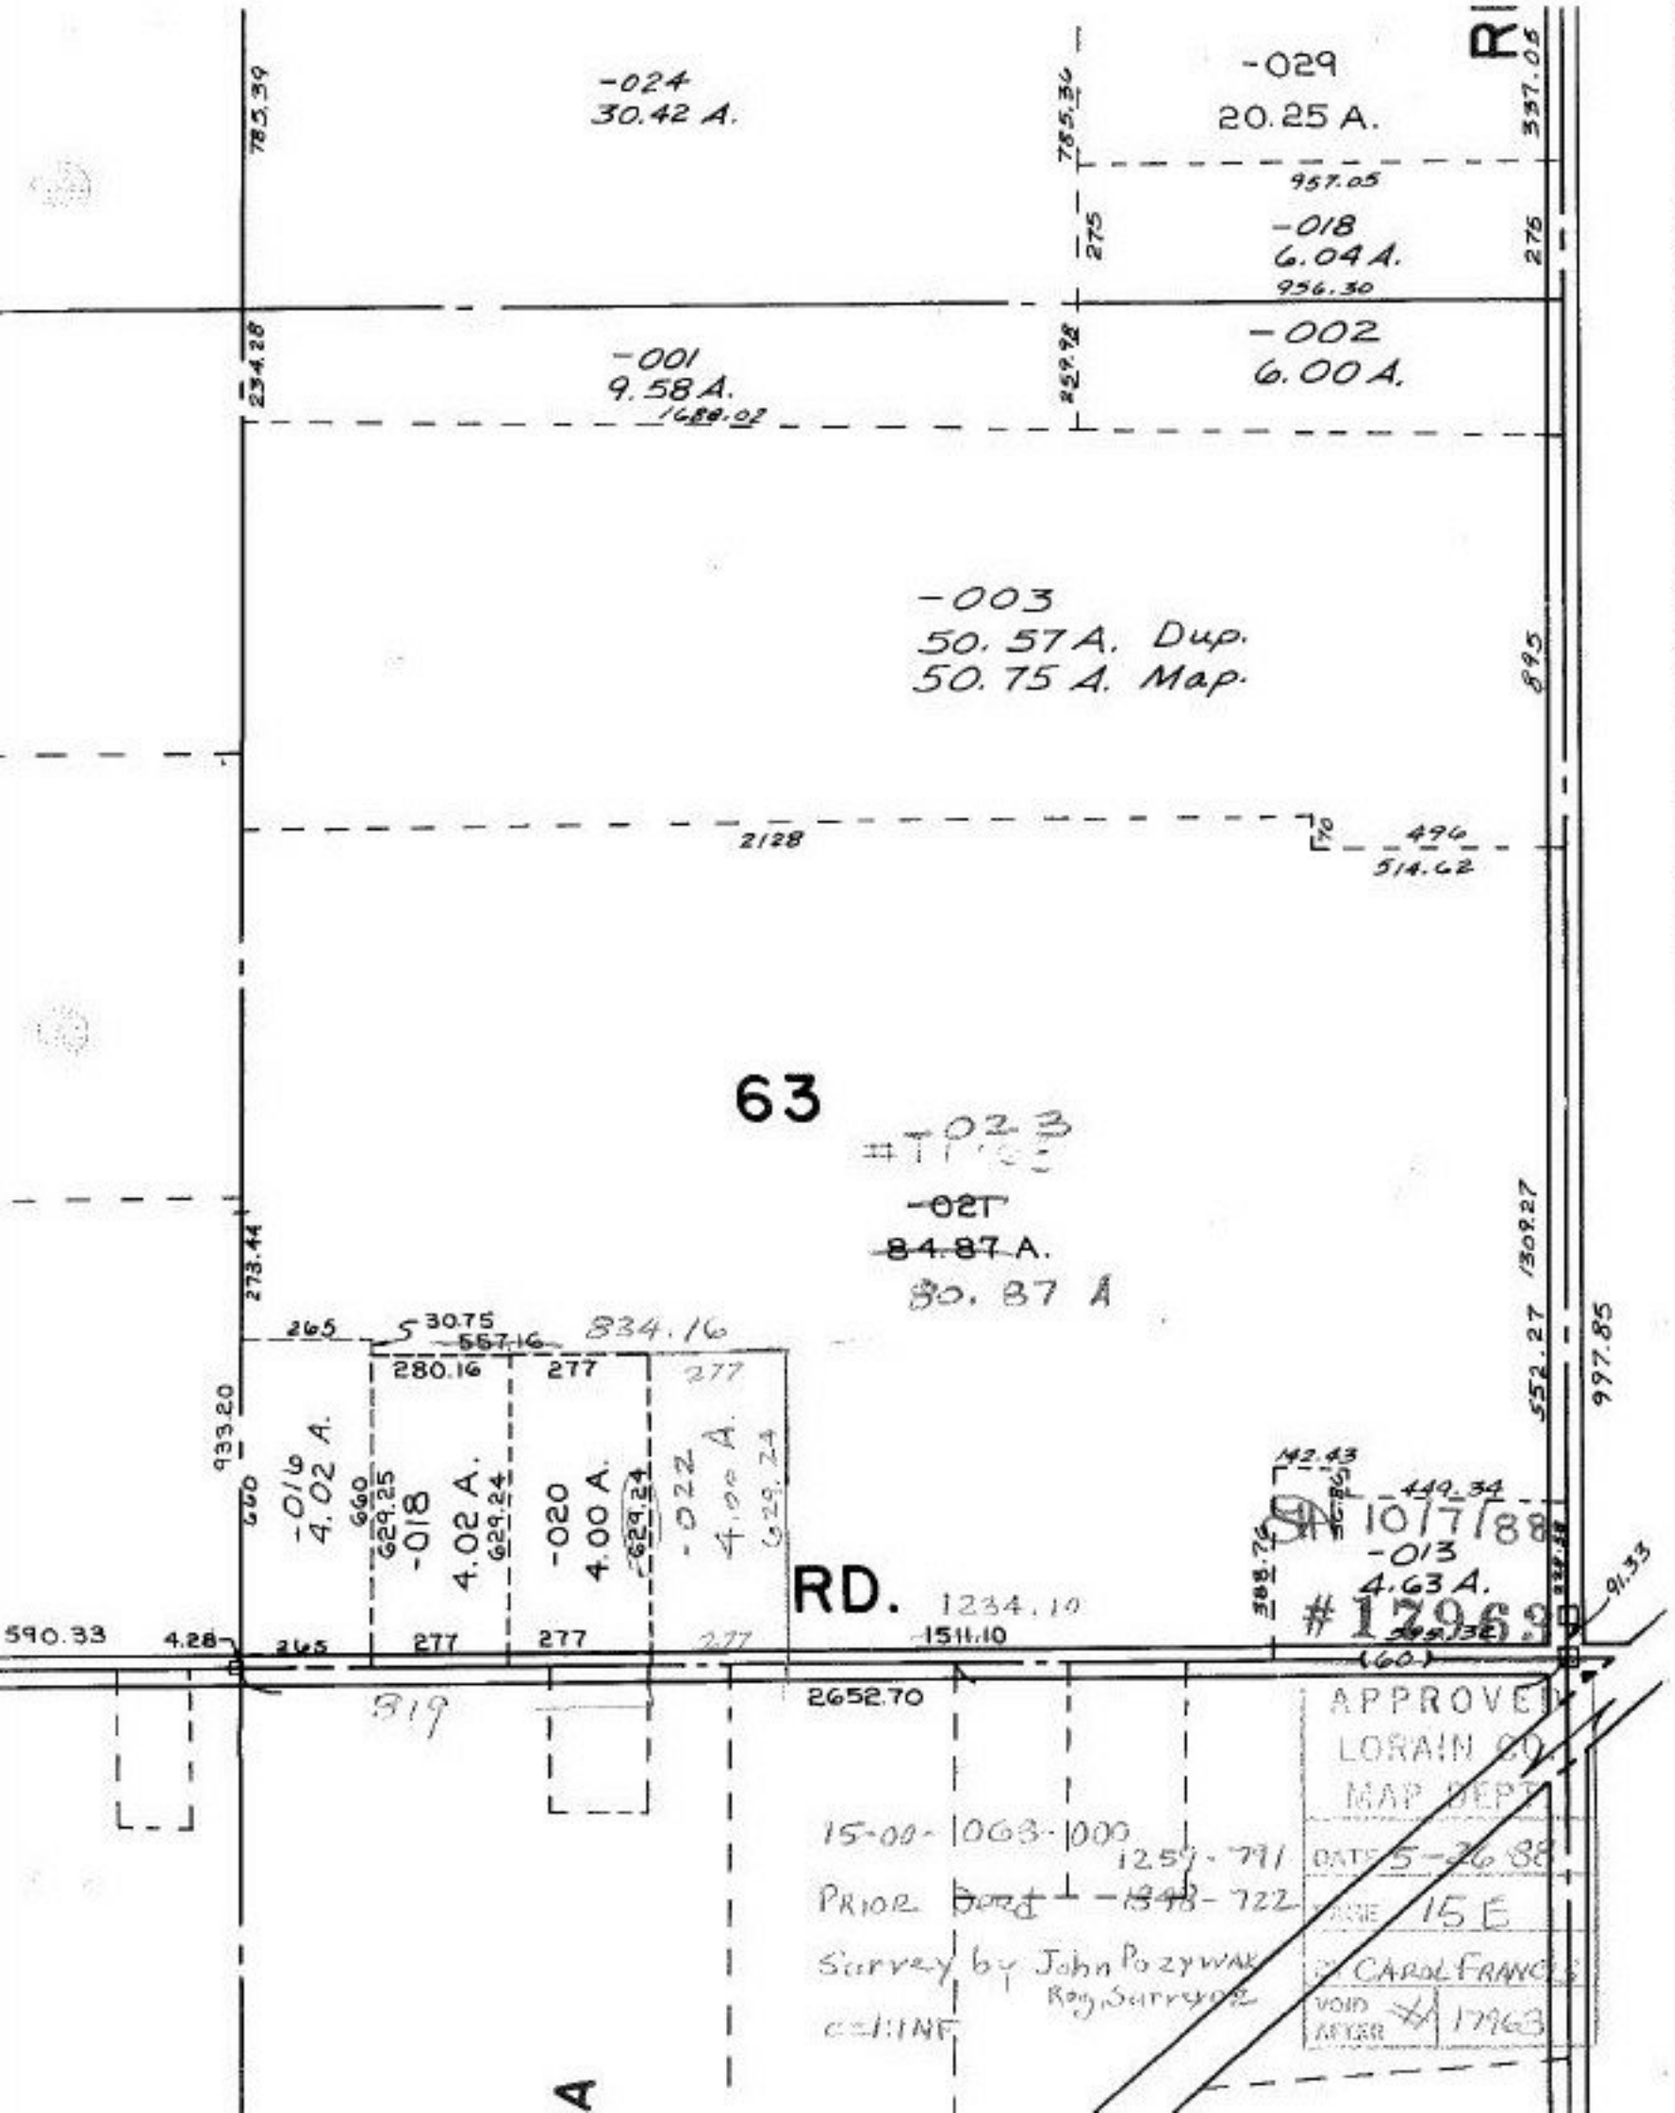

-024
30.42 A.
-029
20.25 A.
-018
6.04 A.
-002
6.00 A.
-001
9.58 A.
-003
50.57 A. Dup.
50.75 A. Map.
63
-023
-021
84.87 A.
80.87 A
-016
4.02 A.
-018
4.02 A.
-020
4.00 A.
-022
4.00 A.
-013
4.63 A.
RD.
1234.10
1511.10
2652.70
590.33
4.28
265
277
280.16
834.16
557.16
30.75
933.20
660
629.25
629.24
142.43
449.34
388.76
91.33
997.85
552.27
1309.27
895
2128
496
514.62
785.39
785.36
337.05
957.05
956.30
275
234.28
259.98
1688.02
273.44
15-00-063-000
1259-791
PRIOR Deed 1848-722
Survey by John Pozywak
Reg. Surveyor
c=1:INF
APPROVED
LORAIN CO.
MAP DEPT.
DATE 5-26-88
PAGE 15 E
BY CAROL FRANCIS
VOID AFTER # 17963