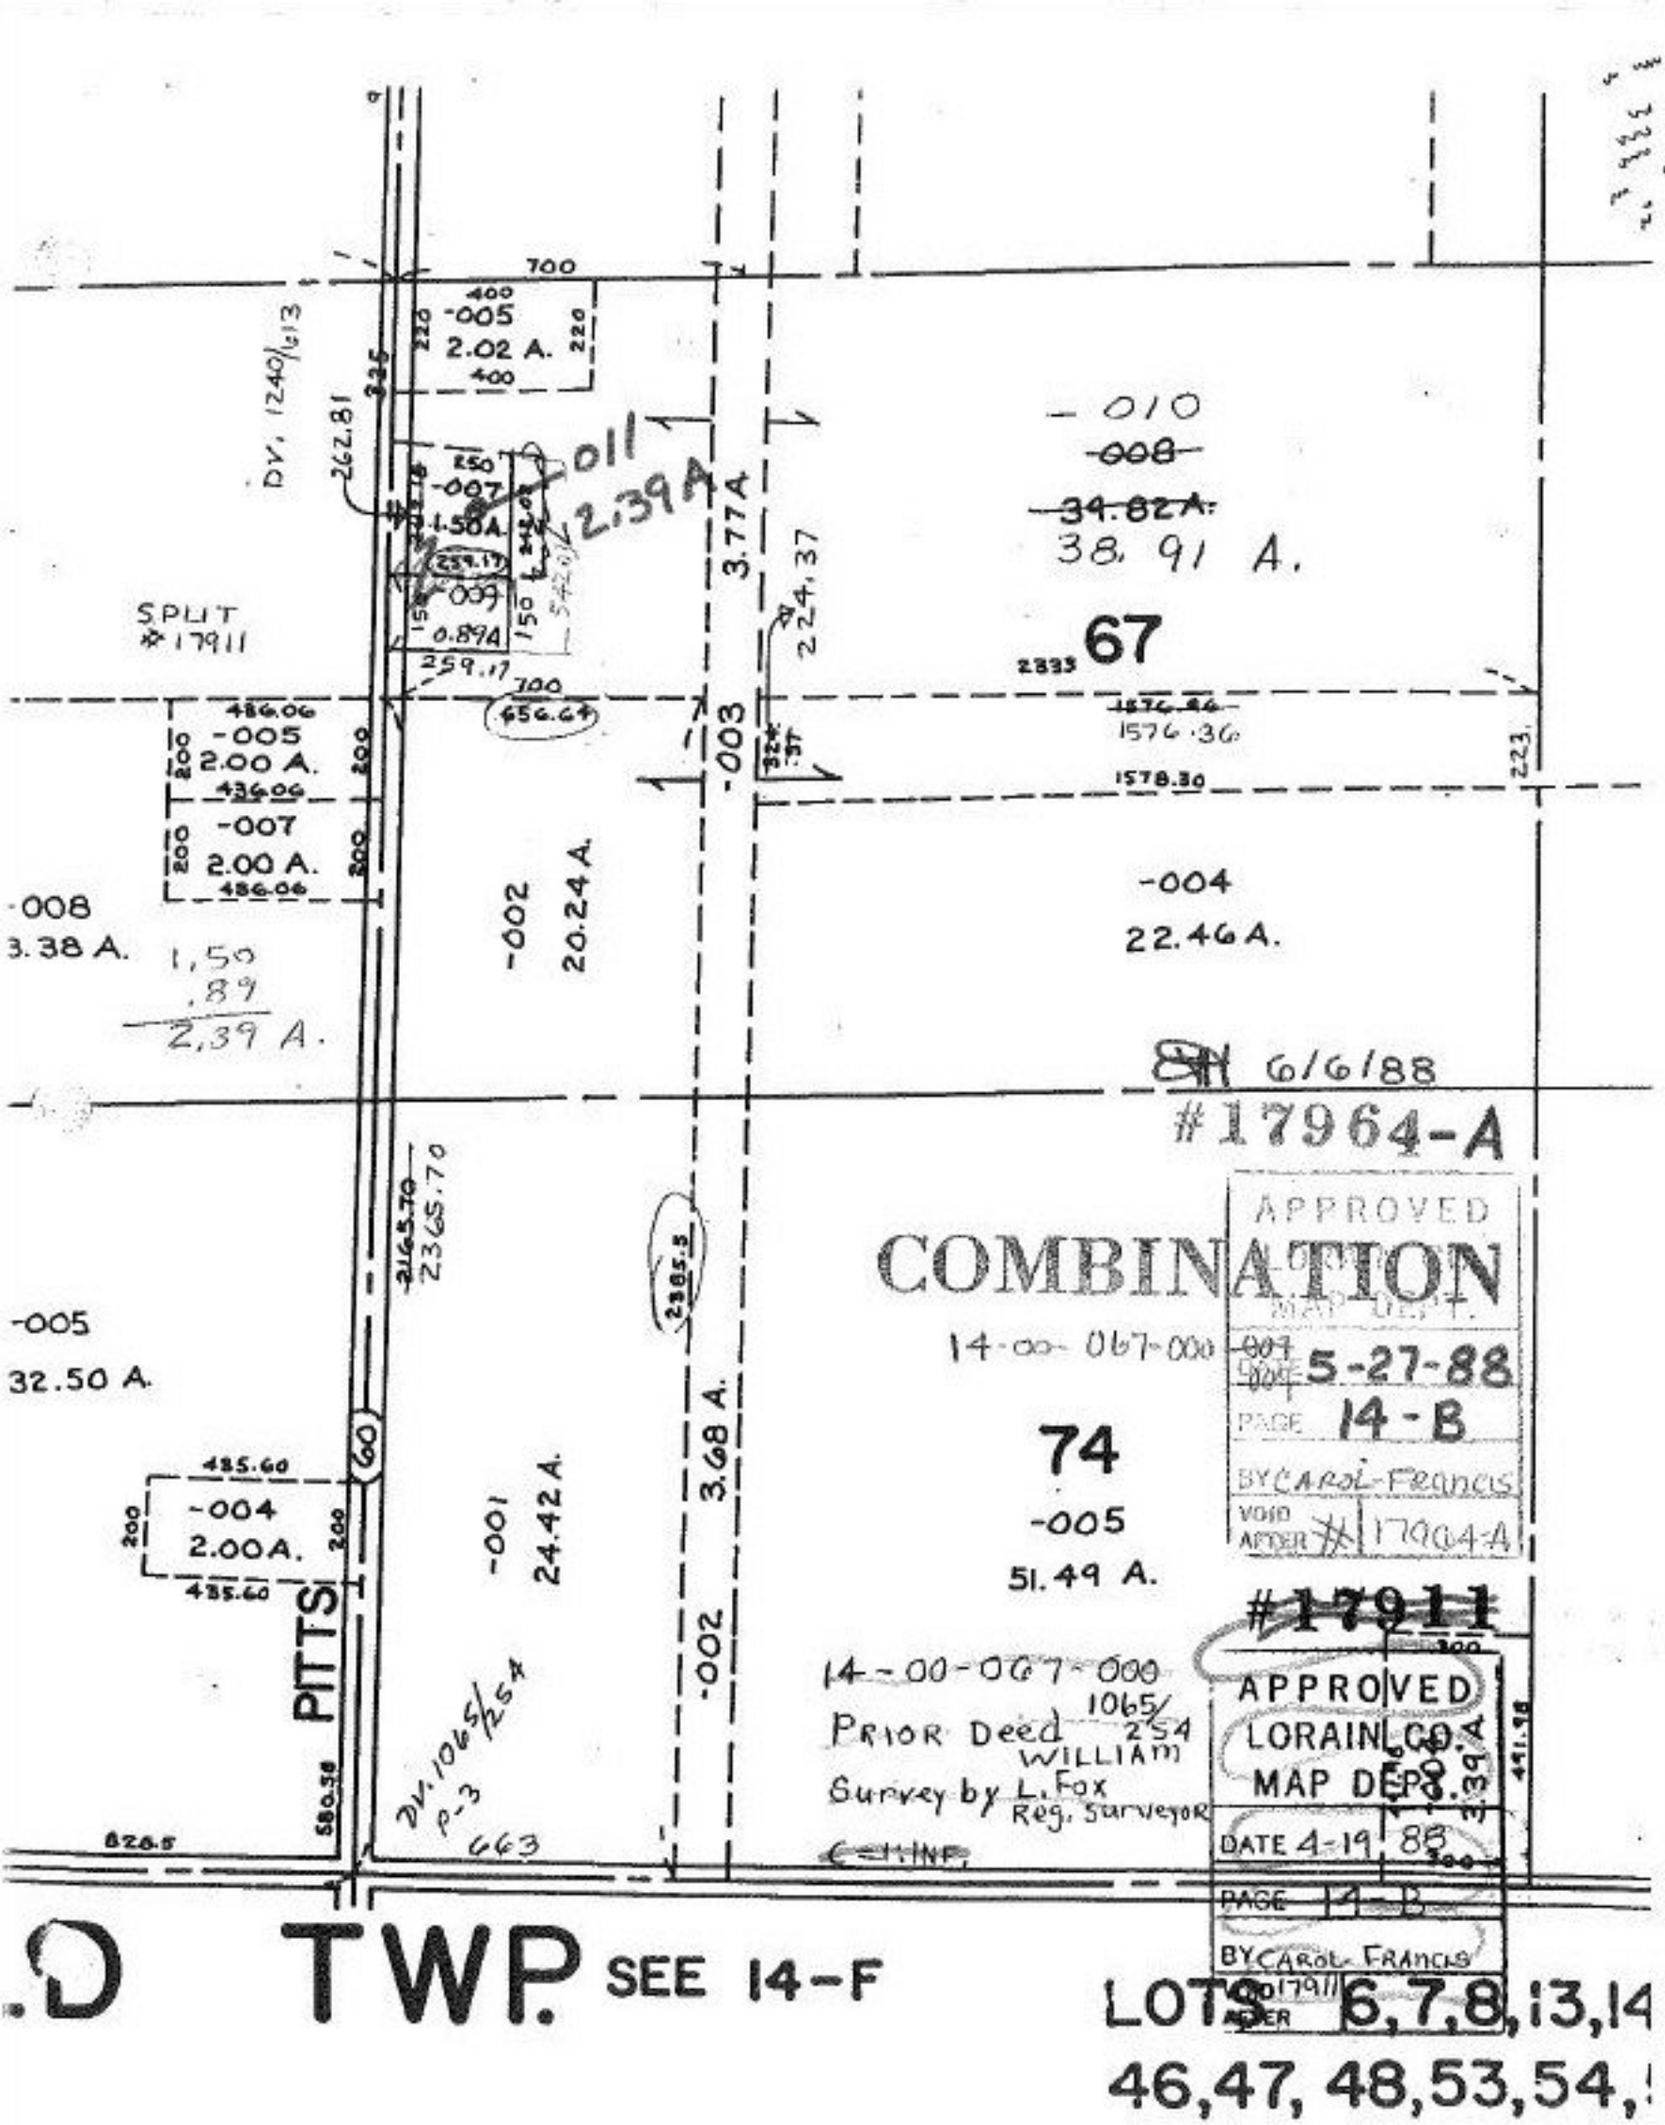
700
-005
2.02 A.
DV. 1240/613
262.81
325
-007
1.50A.
SPLIT
#17911
-009
0.89A
259.17
700
456.64
-010
-008
34.82A.
38.91 A.
67
2833
224.37
3.77A
-003
1576.36
1578.30
223.
-005
2.00 A.
436.06
-007
2.00 A.
-008
3.38 A.
1.50
.89
2.39 A.
-002
20.24 A.
-004
22.46A.
6/6/88
#17964-A
APPROVED
COMBINATION
MAP DEPT.
14-00-067-000
DATE 5-27-88
PAGE 14-B
BY CAROL-FRANCIS
VOID AFTER # 17964-A
2365.70
2385.3
-005
32.50 A.
74
-005
51.49 A.
485.60
-004
2.00A.
60
-001
24.42 A.
3.68 A.
-002
PITTSI
DV. 1065/254
P-3
663
580.38
826.5
14-00-067-000
PRIOR DEED 1065/254 WILLIAM
SURVEY BY L. FOX REG. SURVEYOR
℄ HWY.
#17911
APPROVED
LORAIN CO.
MAP DEPT.
DATE 4-19-88
PAGE 14-B
BY CAROL-FRANCIS
VOID AFTER #17911
.D TWP. SEE 14-F
LOTS 6,7,8,13,14
46,47,48,53,54,