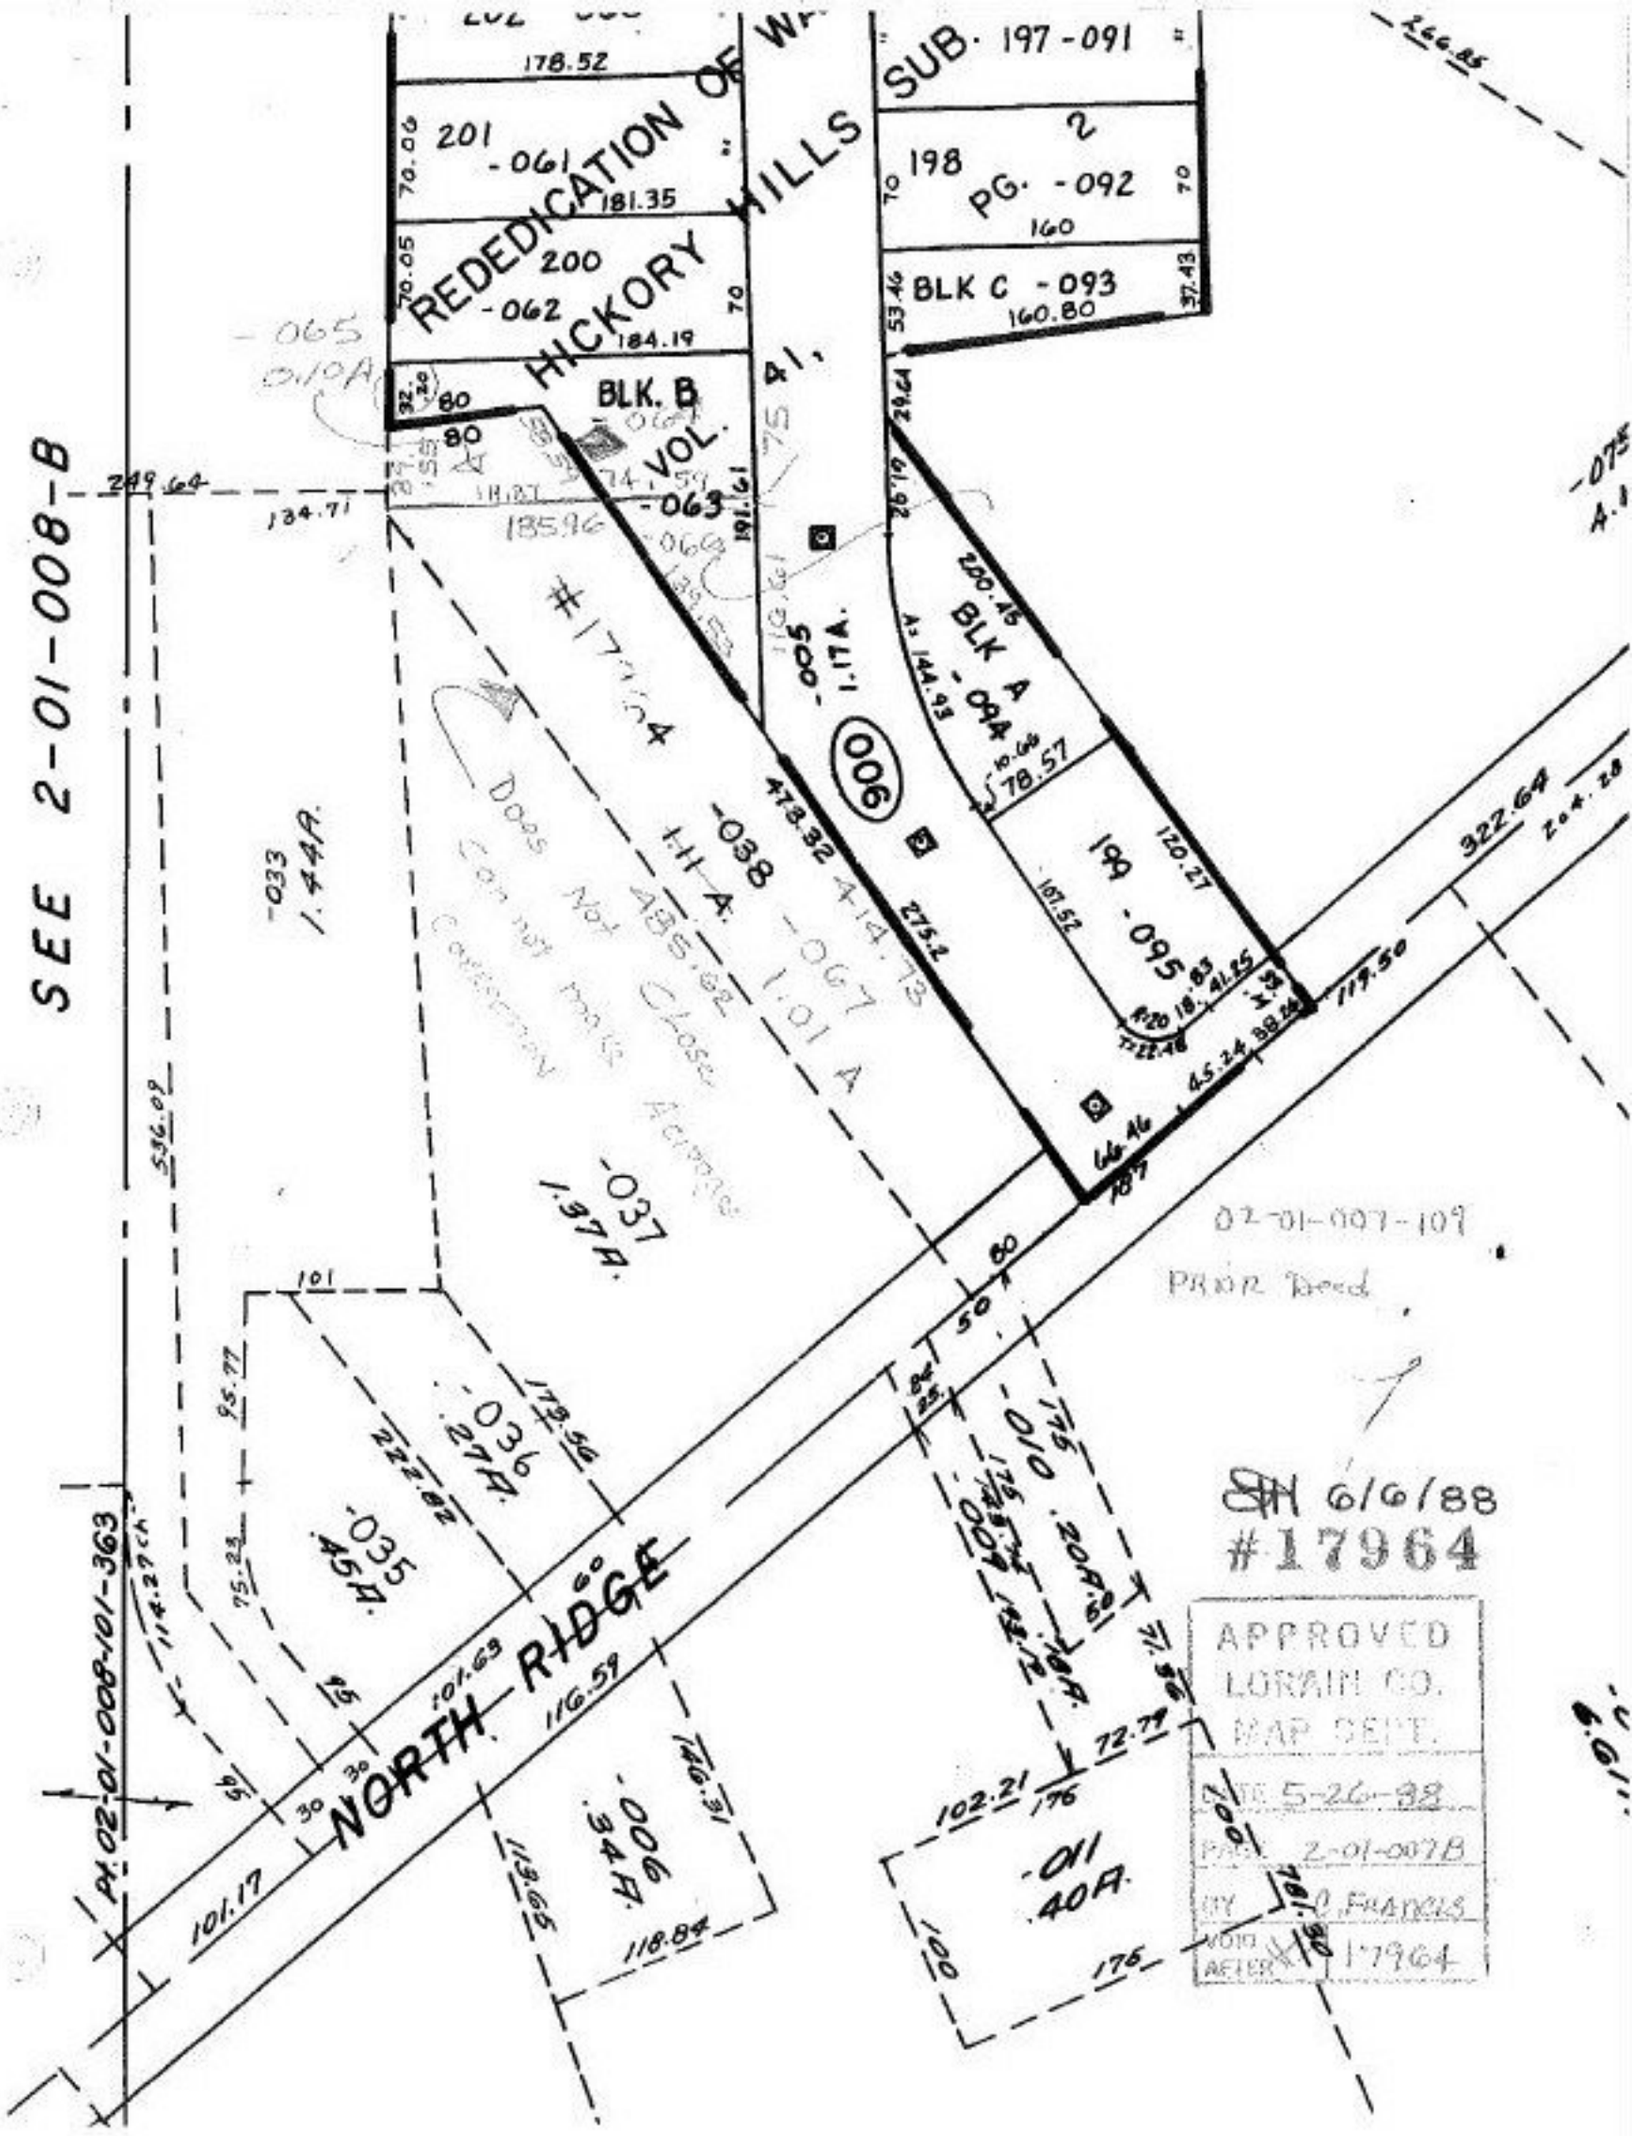
REDEDICATION OF WA
HICKORY HILLS SUB. 197-091
201 -061
200 -062
198 PG. -092
BLK C -093
BLK. B VOL. 41, -063
BLK A -094
199 -095
-005 1.17A.
-038 1.11 A.
-067 1.01 A
-033 1.44A.
-037 1.37A.
-036 .27A.
-035 .45A.
-010 .20A.
-009 .18A.
-006 .34A.
-011 .40A.
SEE 2-01-008-B
NORTH RIDGE
Does Not Close
Can not make Acreage
Coefficient
02-01-007-109
PRIOR Deed
6/6/88
#17964
APPROVED
LORAIN CO.
MAP DEPT.
DATE 5-26-88
PAGE 2-01-007B
BY C. FRANCIS
VOID AFTER #17964