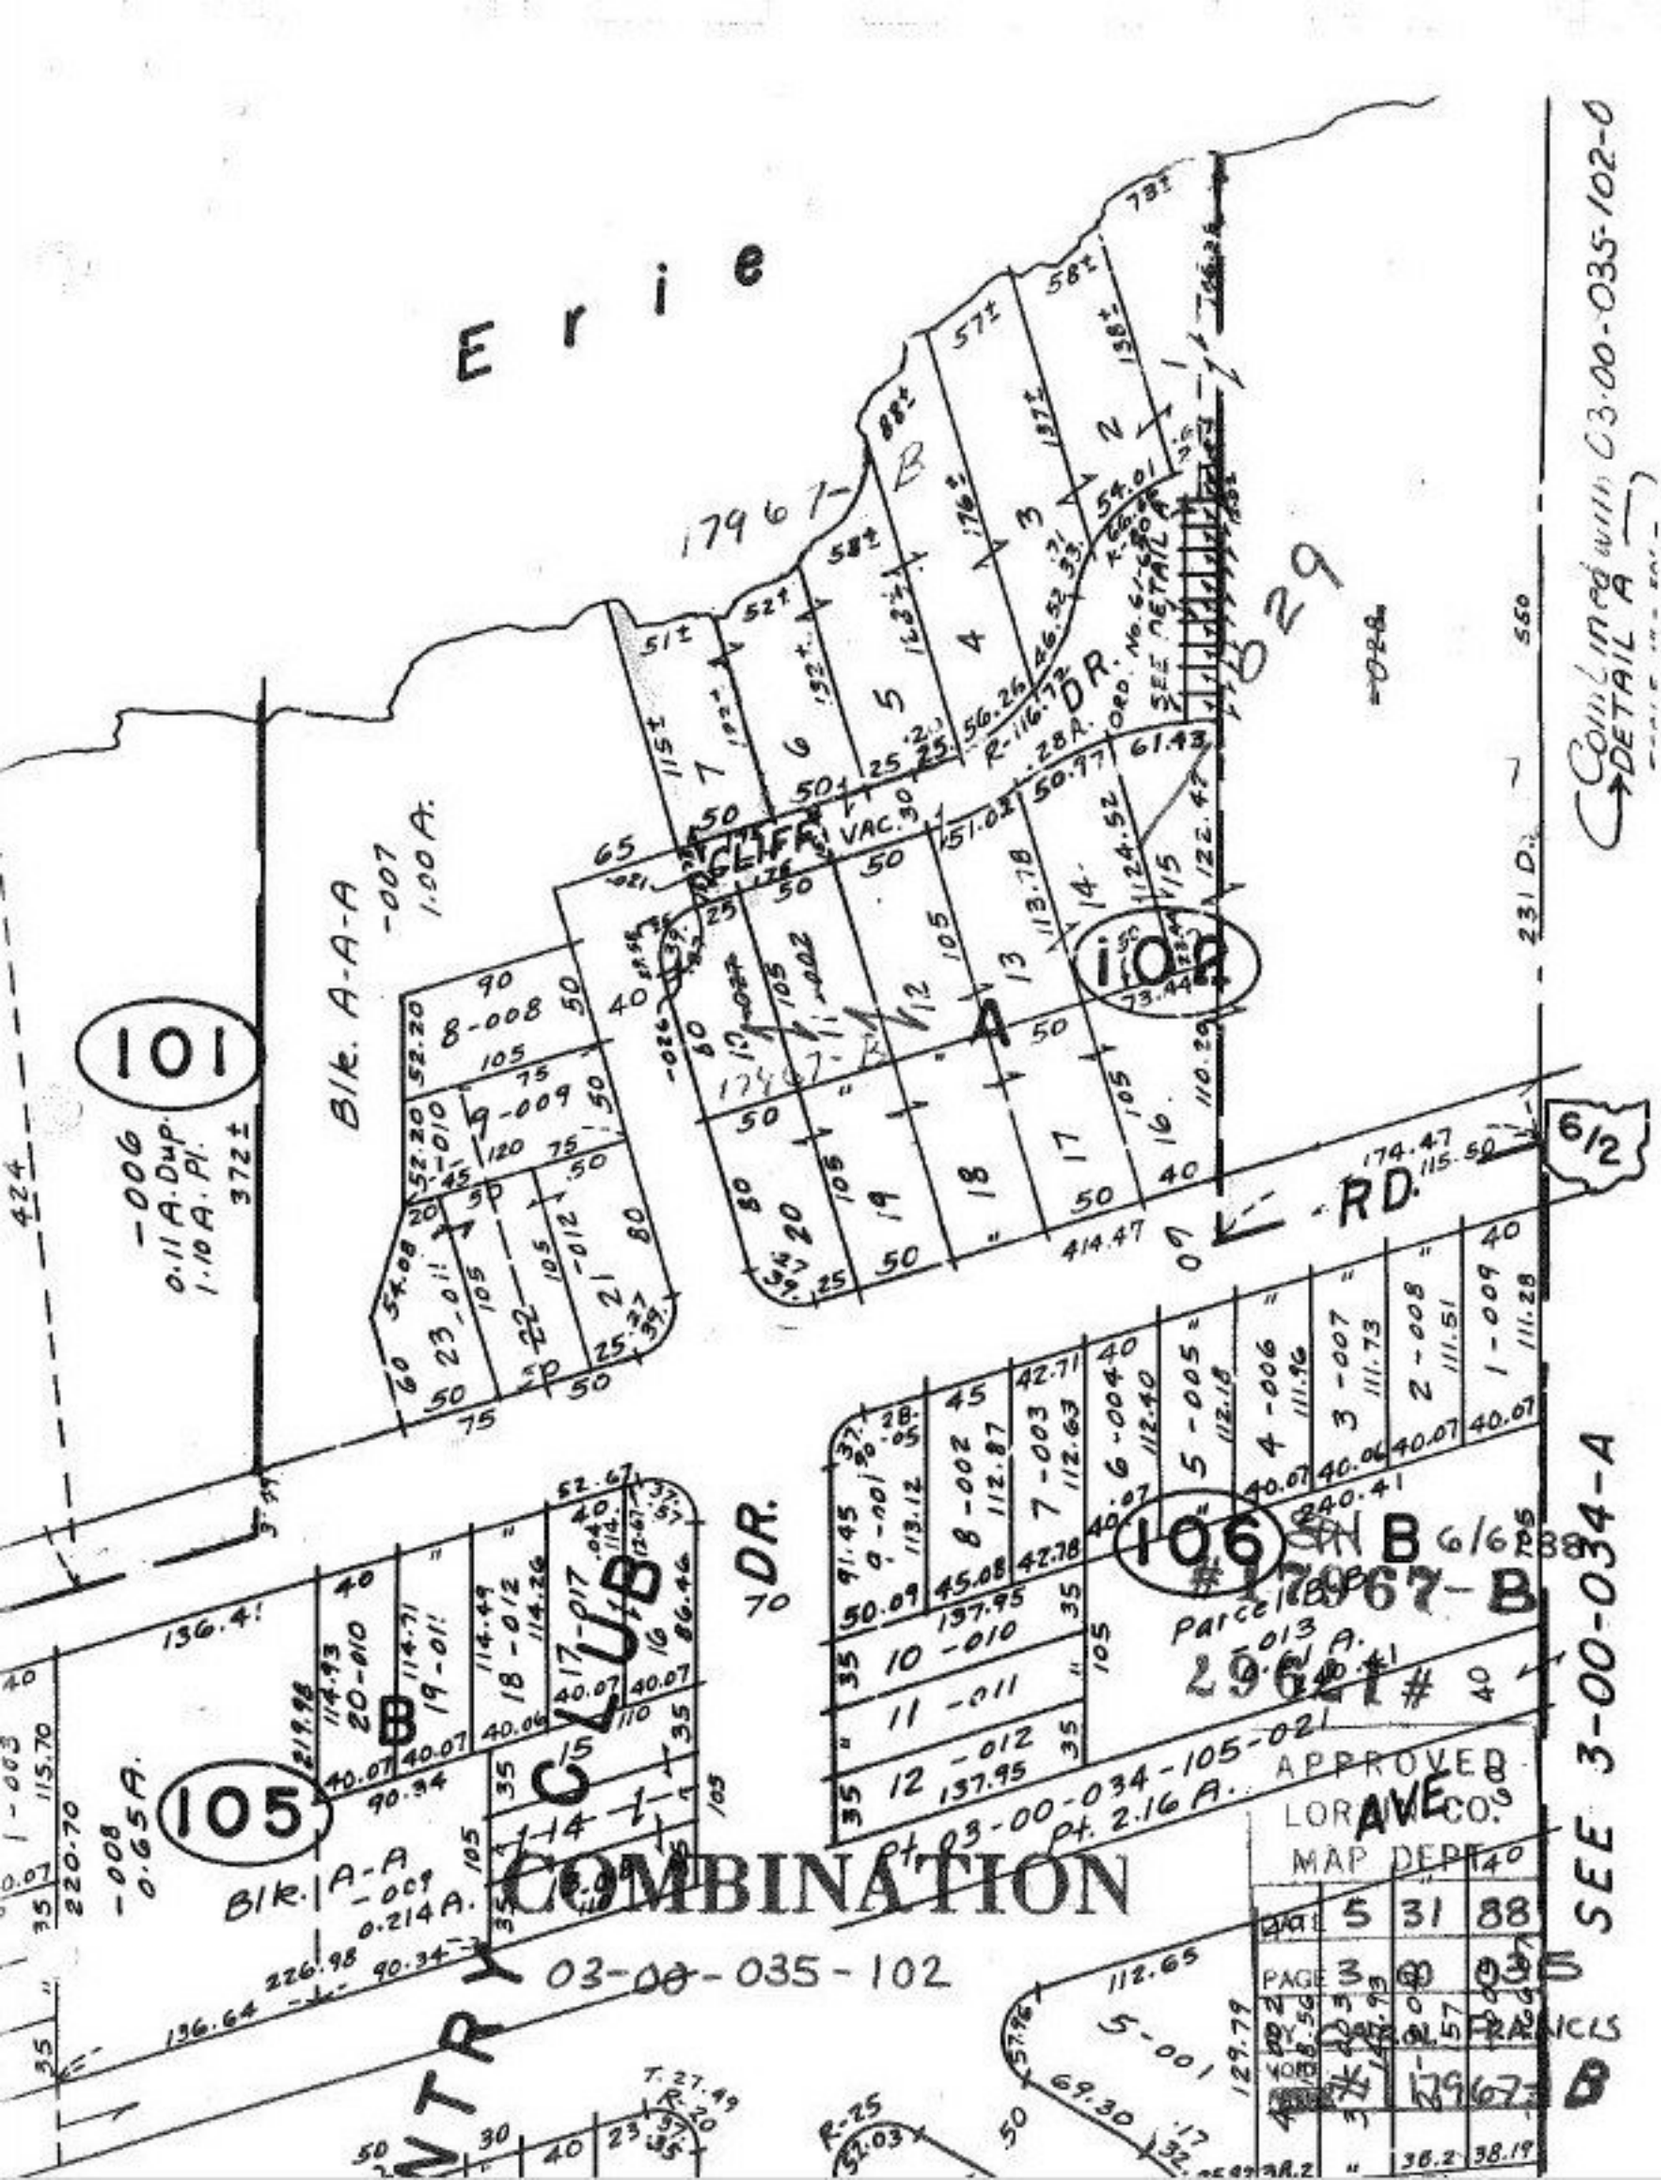
Erie
101
-006
0.11 A. Dup.
1.10 A. Pl.
372±
Blk. A-A-A
-007
1.00 A.
424
8-008
9-009
-010
-012
21
80
23
-011
22
105
120
75
50
45
20
54.08
52.20
105
DR.
VAC.
30
R-116.72
ORD. No. 61-80
SEE DETAIL A
DETAIL A
Continued with 03-00-035-102-0
1796 7-B
1829
231 D.
560
731
58±
57±
138±
187±
176±
162±
132±
122±
115±
102±
88±
51±
52±
65
61.43
50.97
151.02
124.52
122.42
113.78
110.29
73.44
414.47
174.47
115.50
RD.
6/2
106
#17967-B
6/6
240.41
111.28
111.51
111.73
111.96
112.18
112.40
112.63
112.87
113.12
91.45
42.78
45.08
50.09
137.95
10-010
11-011
12-012
Parcel B
29.013 A.
29621 #
03-00-034-105-021
Pt. 2.16 A.
APPROVED
LOR CO.
MAP DEPT
DATE 5 31 88
PAGE 3
105
B
20-010
19-011
18-012
17-013
114.93
114.31
114.49
114.26
136.4!
136.64
226.98
90.34
220.70
115.70
0.65 A.
-008
Blk. A-A
-009
0.214 A.
COMBINATION
03-00-035-102
SEE 3-00-034-4
AVE.
DR.
CLUB
COUNTRY
T. 27.49
R-20
R-25
52.03
112.65
129.79
69.30
36.2
38.19