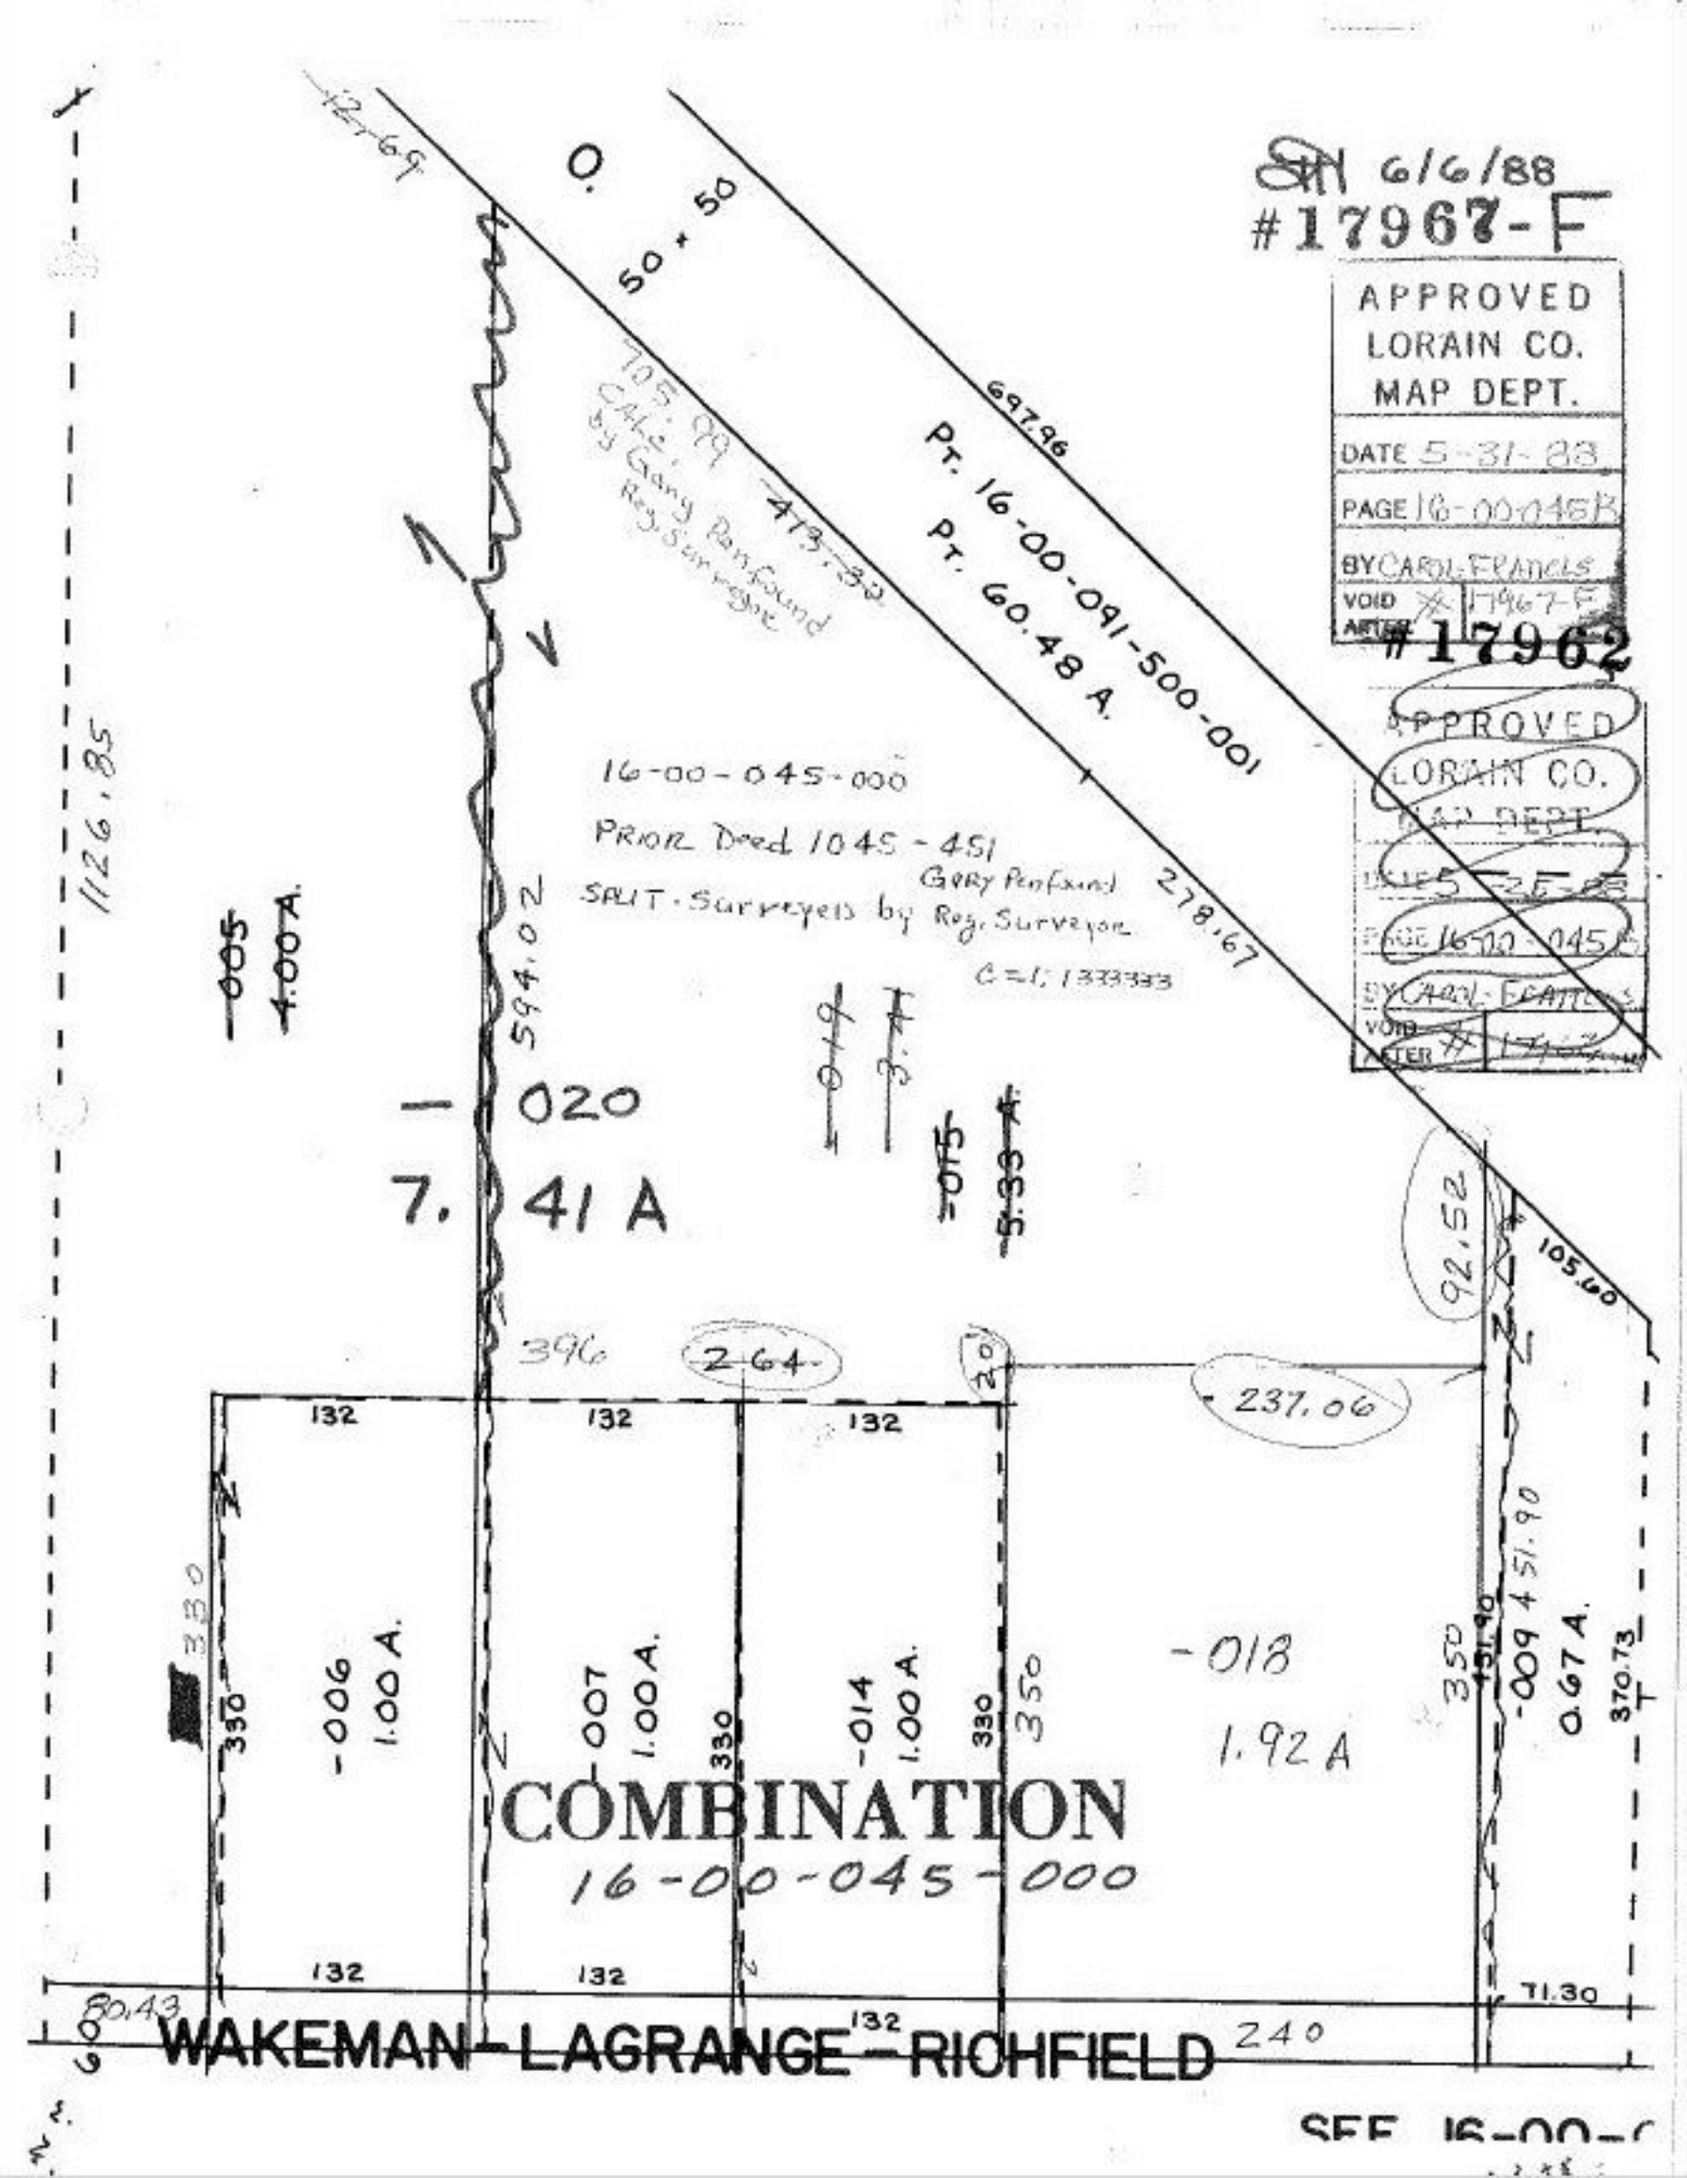
6/6/88
#17967-F
APPROVED
LORAIN CO.
MAP DEPT.
DATE 5-31-88
PAGE 16-00-045B
BY CAROL FRANCIS
VOID AFTER #17967-F
#17962
APPROVED
LORAIN CO.
MAP DEPT.
DATE 5-25-88
PAGE 16-00-045
BY CAROL FRANCIS
VOID AFTER #
50 + 50
697.96
Pt. 16-00-091-500-001
Pt. 60.48 A.
278.67
705.99
CALC. Gary Penfound
by Reg. Surveyor
473.33
16-00-045-000
PRIOR Deed 1045-451
Gary Penfound
SALT. Surveyed by Reg. Surveyor
C=L 1333383
1126.85
005
4.00 A.
594.02
020
7.41 A
010
4.3
015
5.33 A
92.52
105.00
396
264
20
237.06
132
132
132
330
006
1.00 A.
007
1.00 A.
330
014
1.00 A.
330
350
018
1.92 A
350
151.90
009
0.67 A.
370.73
COMBINATION
16-00-045-000
132
132
80.43
132
240
71.30
WAKEMAN-LAGRANGE-RICHFIELD
SEE 16-00-