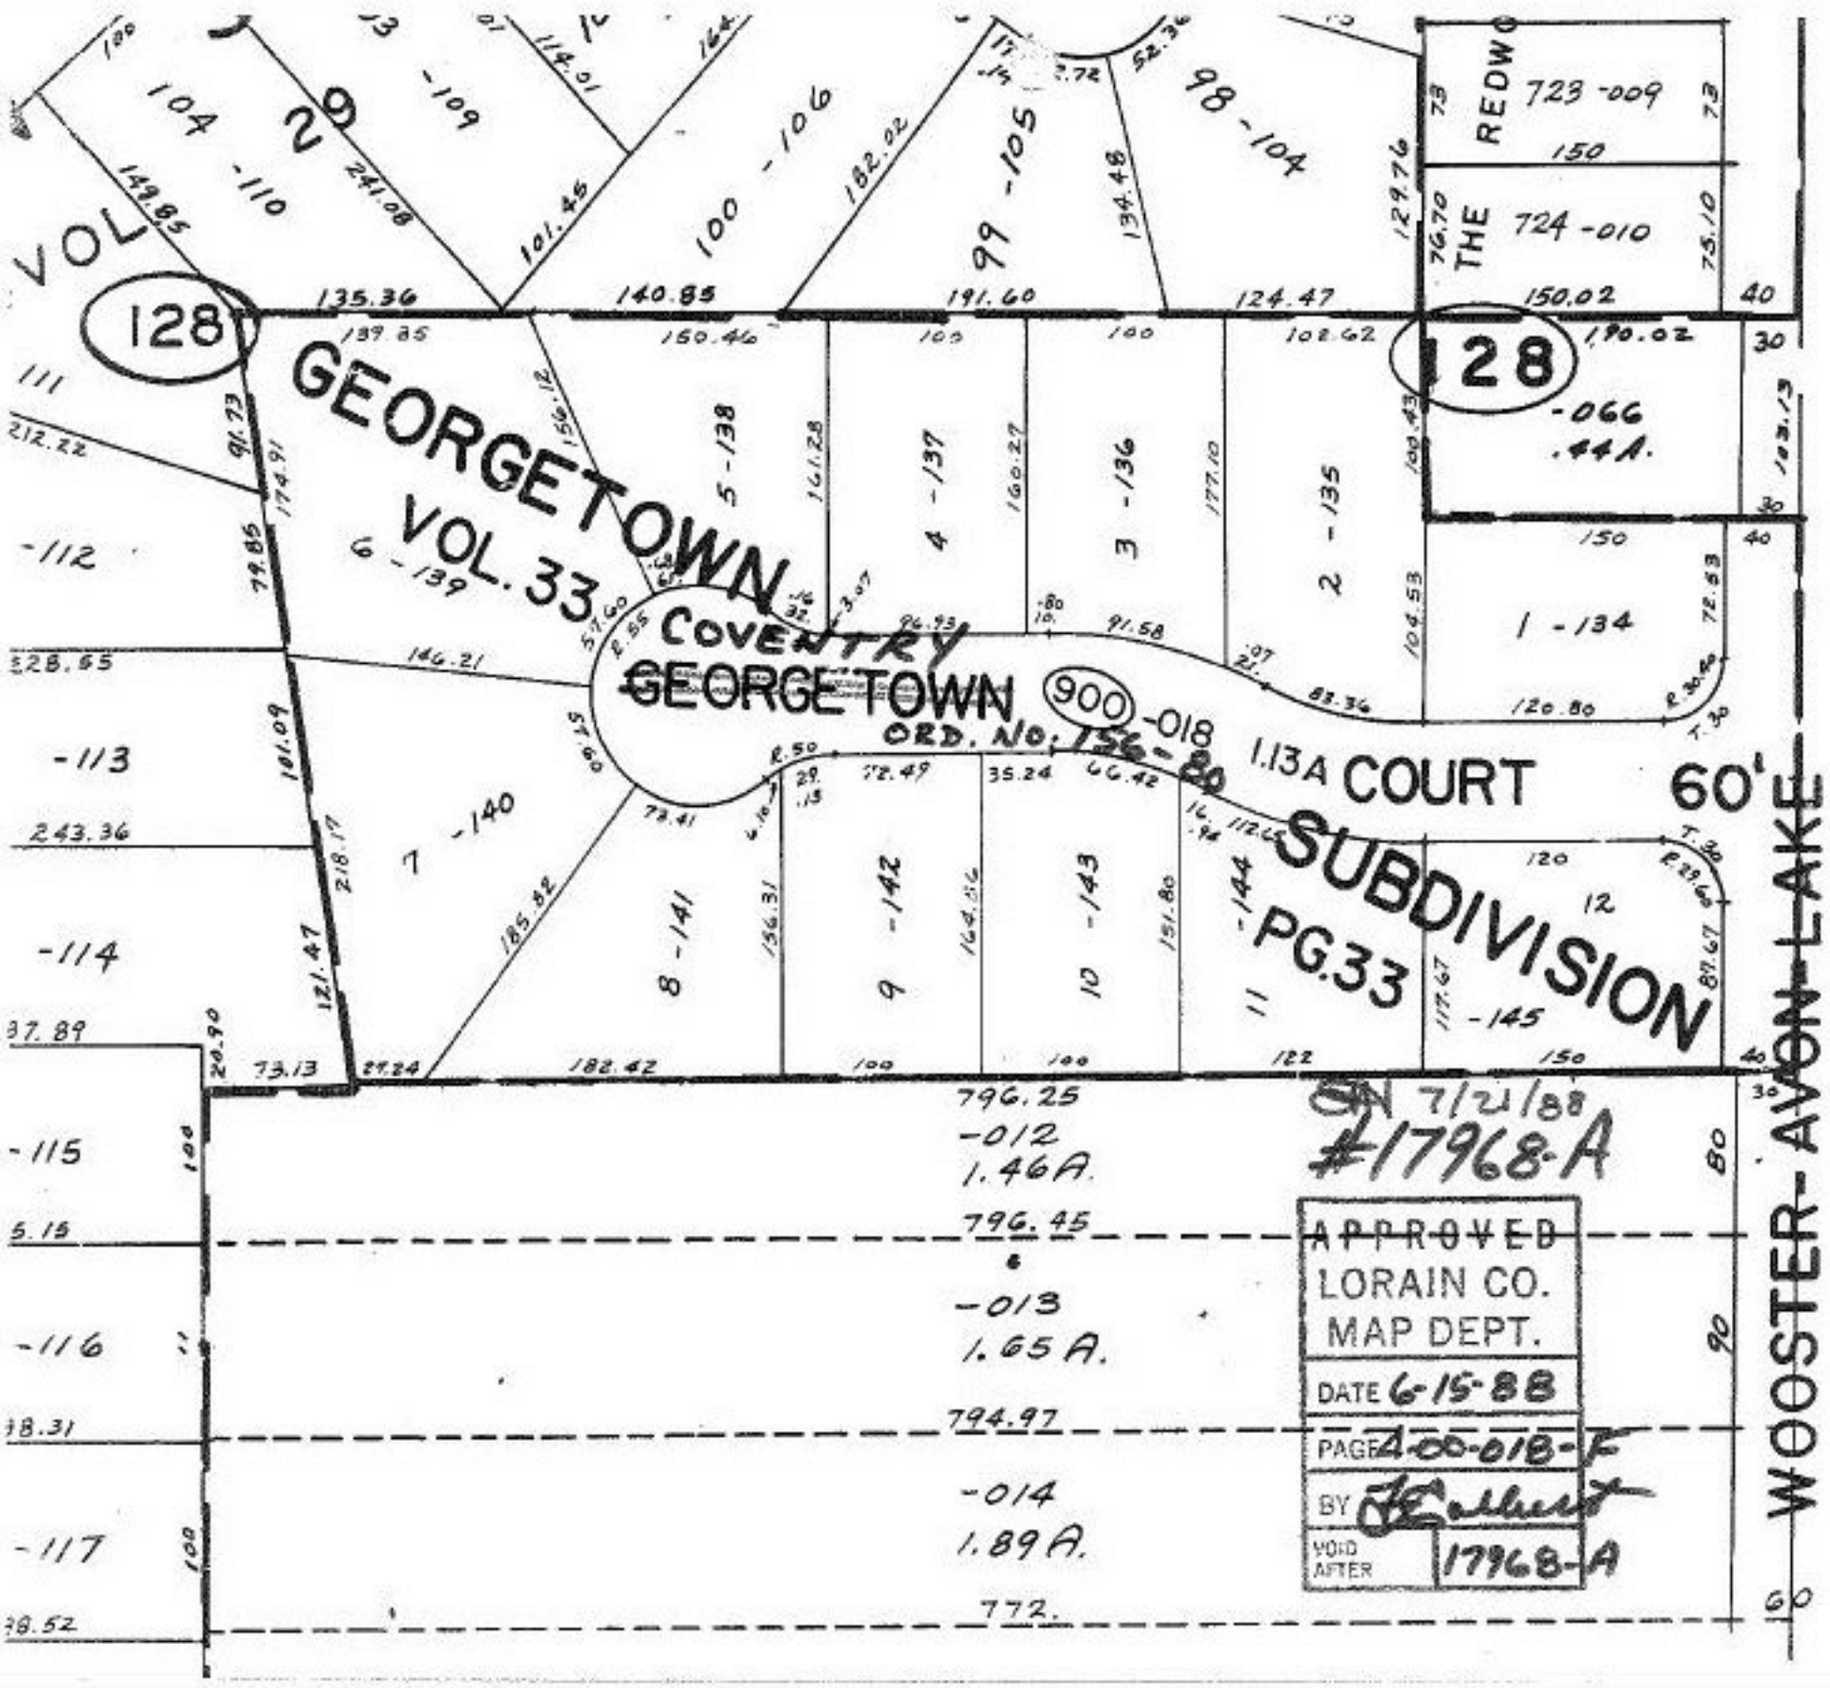
GEORGETOWN
VOL. 33
PG. 33
COVENTRY
GEORGE TOWN
ORD. No. 156-80
SUBDIVISION
1.13A COURT
60'
WOOSTER-AVON LAKE
REDWOOD THE
723-009
724-010
128
-066
.44A.
900
-018
1.13A
1 -134
2 -135
3 -136
4 -137
5 -138
6 -139
7 -140
8 -141
9 -142
10 -143
11 -144
12
-145
796.25
-012
1.46A.
796.45
-013
1.65A.
794.97
-014
1.89A.
772.
ON 7/21/88
#17968-A
APPROVED
LORAIN CO.
MAP DEPT.
DATE 6-15-88
PAGE 4-00-018-F
BY
VOID AFTER 17968-A