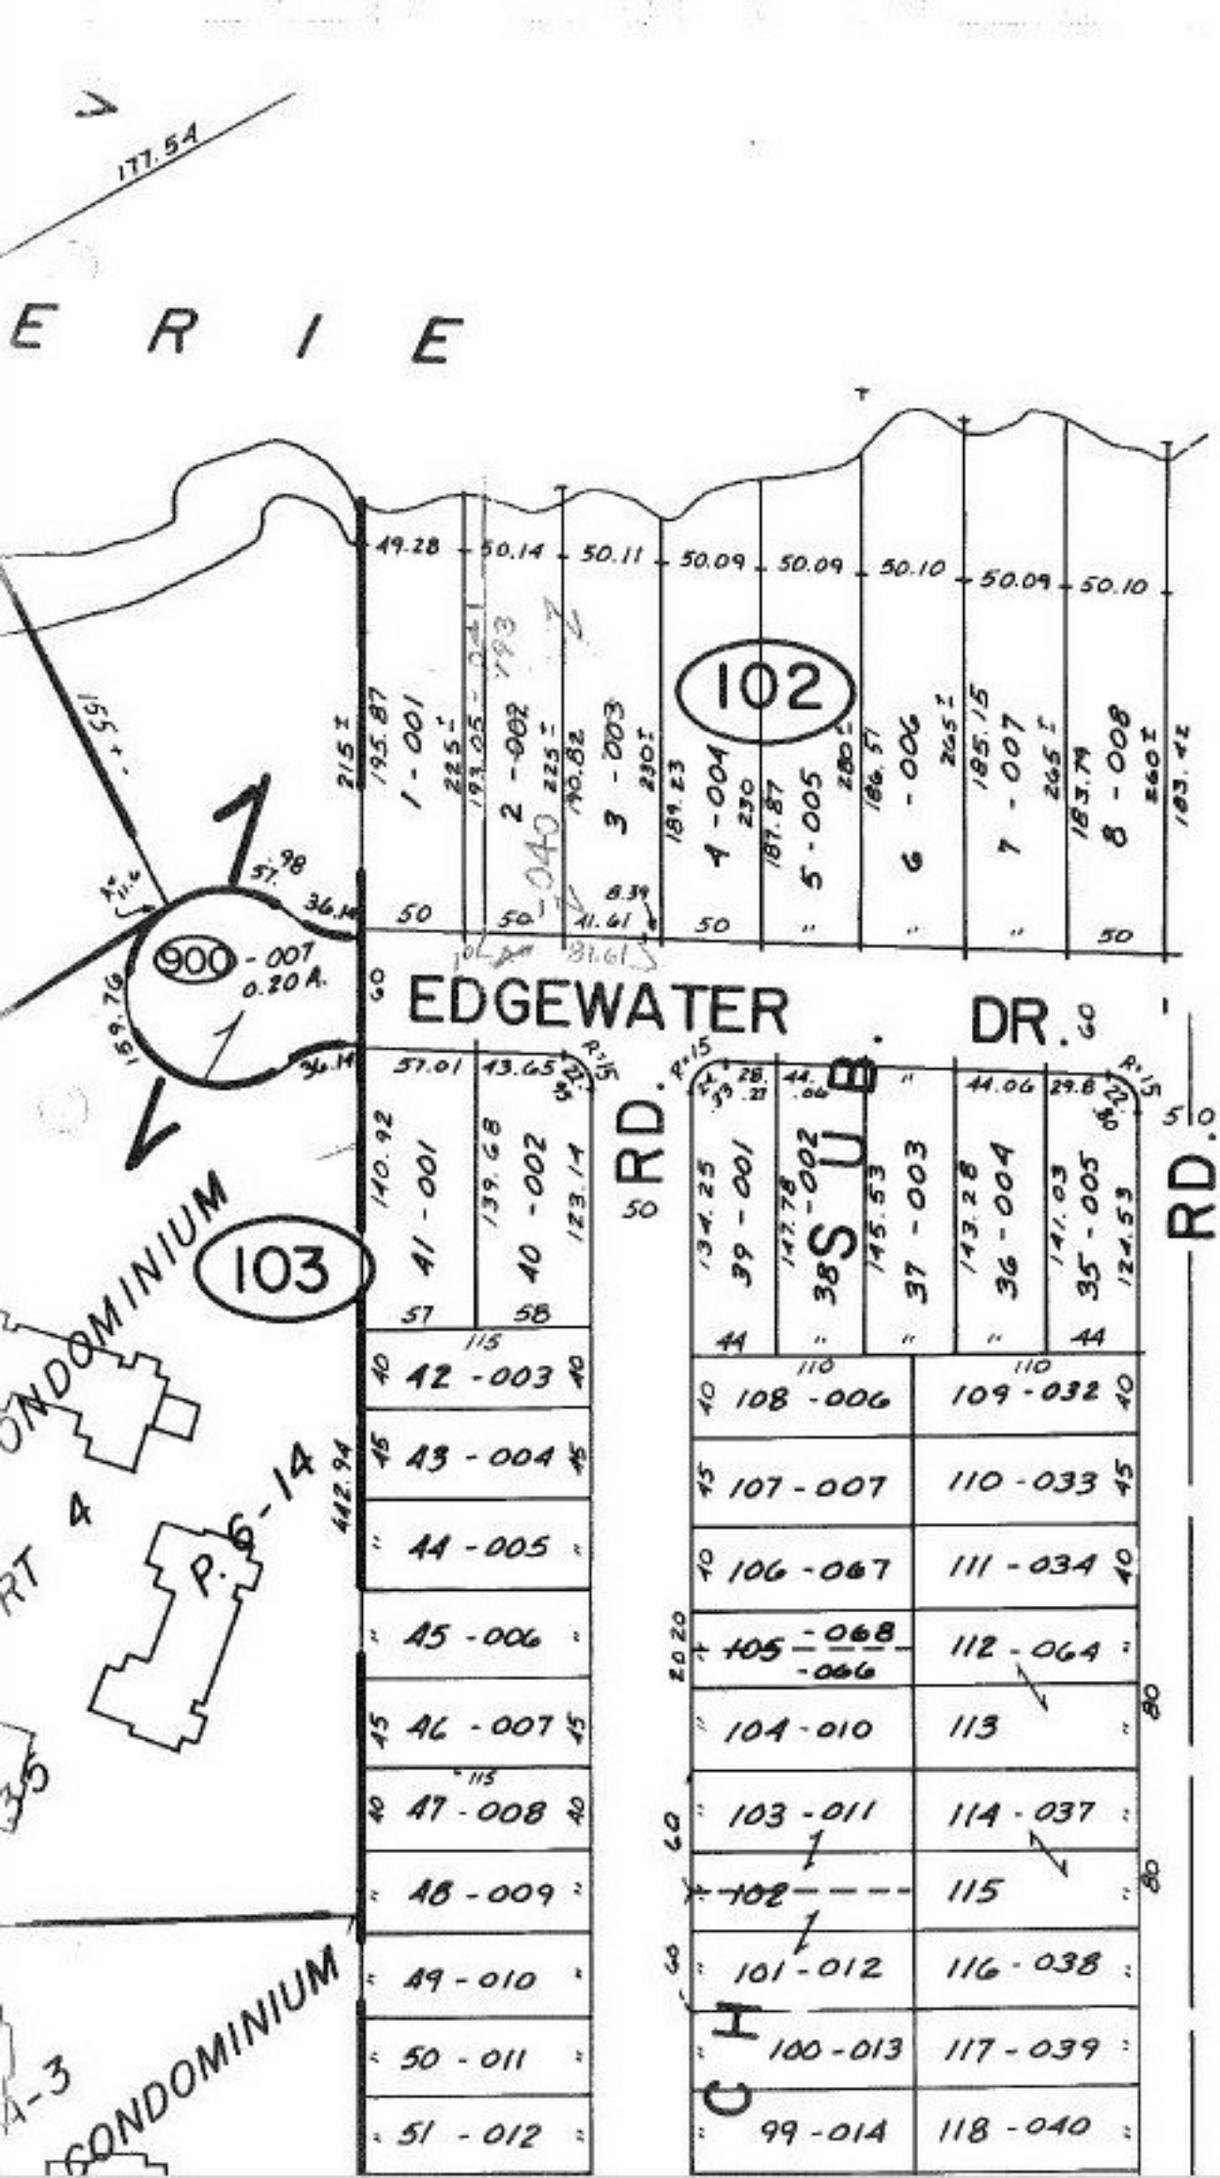
177.54
E R I E
102
103
900 - 007
0.20 A.
EDGEWATER DR.
RD.
SUB.
RD.
CONDOMINIUM
CONDOMINIUM
1 - 001
2 - 002
3 - 003
4 - 004
5 - 005
6 - 006
7 - 007
8 - 008
41 - 001
40 - 002
39 - 001
38 - 002
37 - 003
36 - 004
35 - 005
42 - 003
43 - 004
44 - 005
45 - 006
46 - 007
47 - 008
48 - 009
49 - 010
50 - 011
51 - 012
108 - 006
109 - 032
107 - 007
110 - 033
106 - 067
111 - 034
105 - 068
- 066
112 - 064
104 - 010
113
103 - 011
114 - 037
102
115
101 - 012
116 - 038
100 - 013
117 - 039
99 - 014
118 - 040
01-00-001-102
PRIOR Deed 1130/74
SEE 1-00-001-B
6/6/88
#17968
APPROVED
LORAIN CO.
MAP DEPT.
DATE 5-27-88
PAGE 1-00-001-A
BY CAROL FRANKS
VOID AFTER 6/8 17968