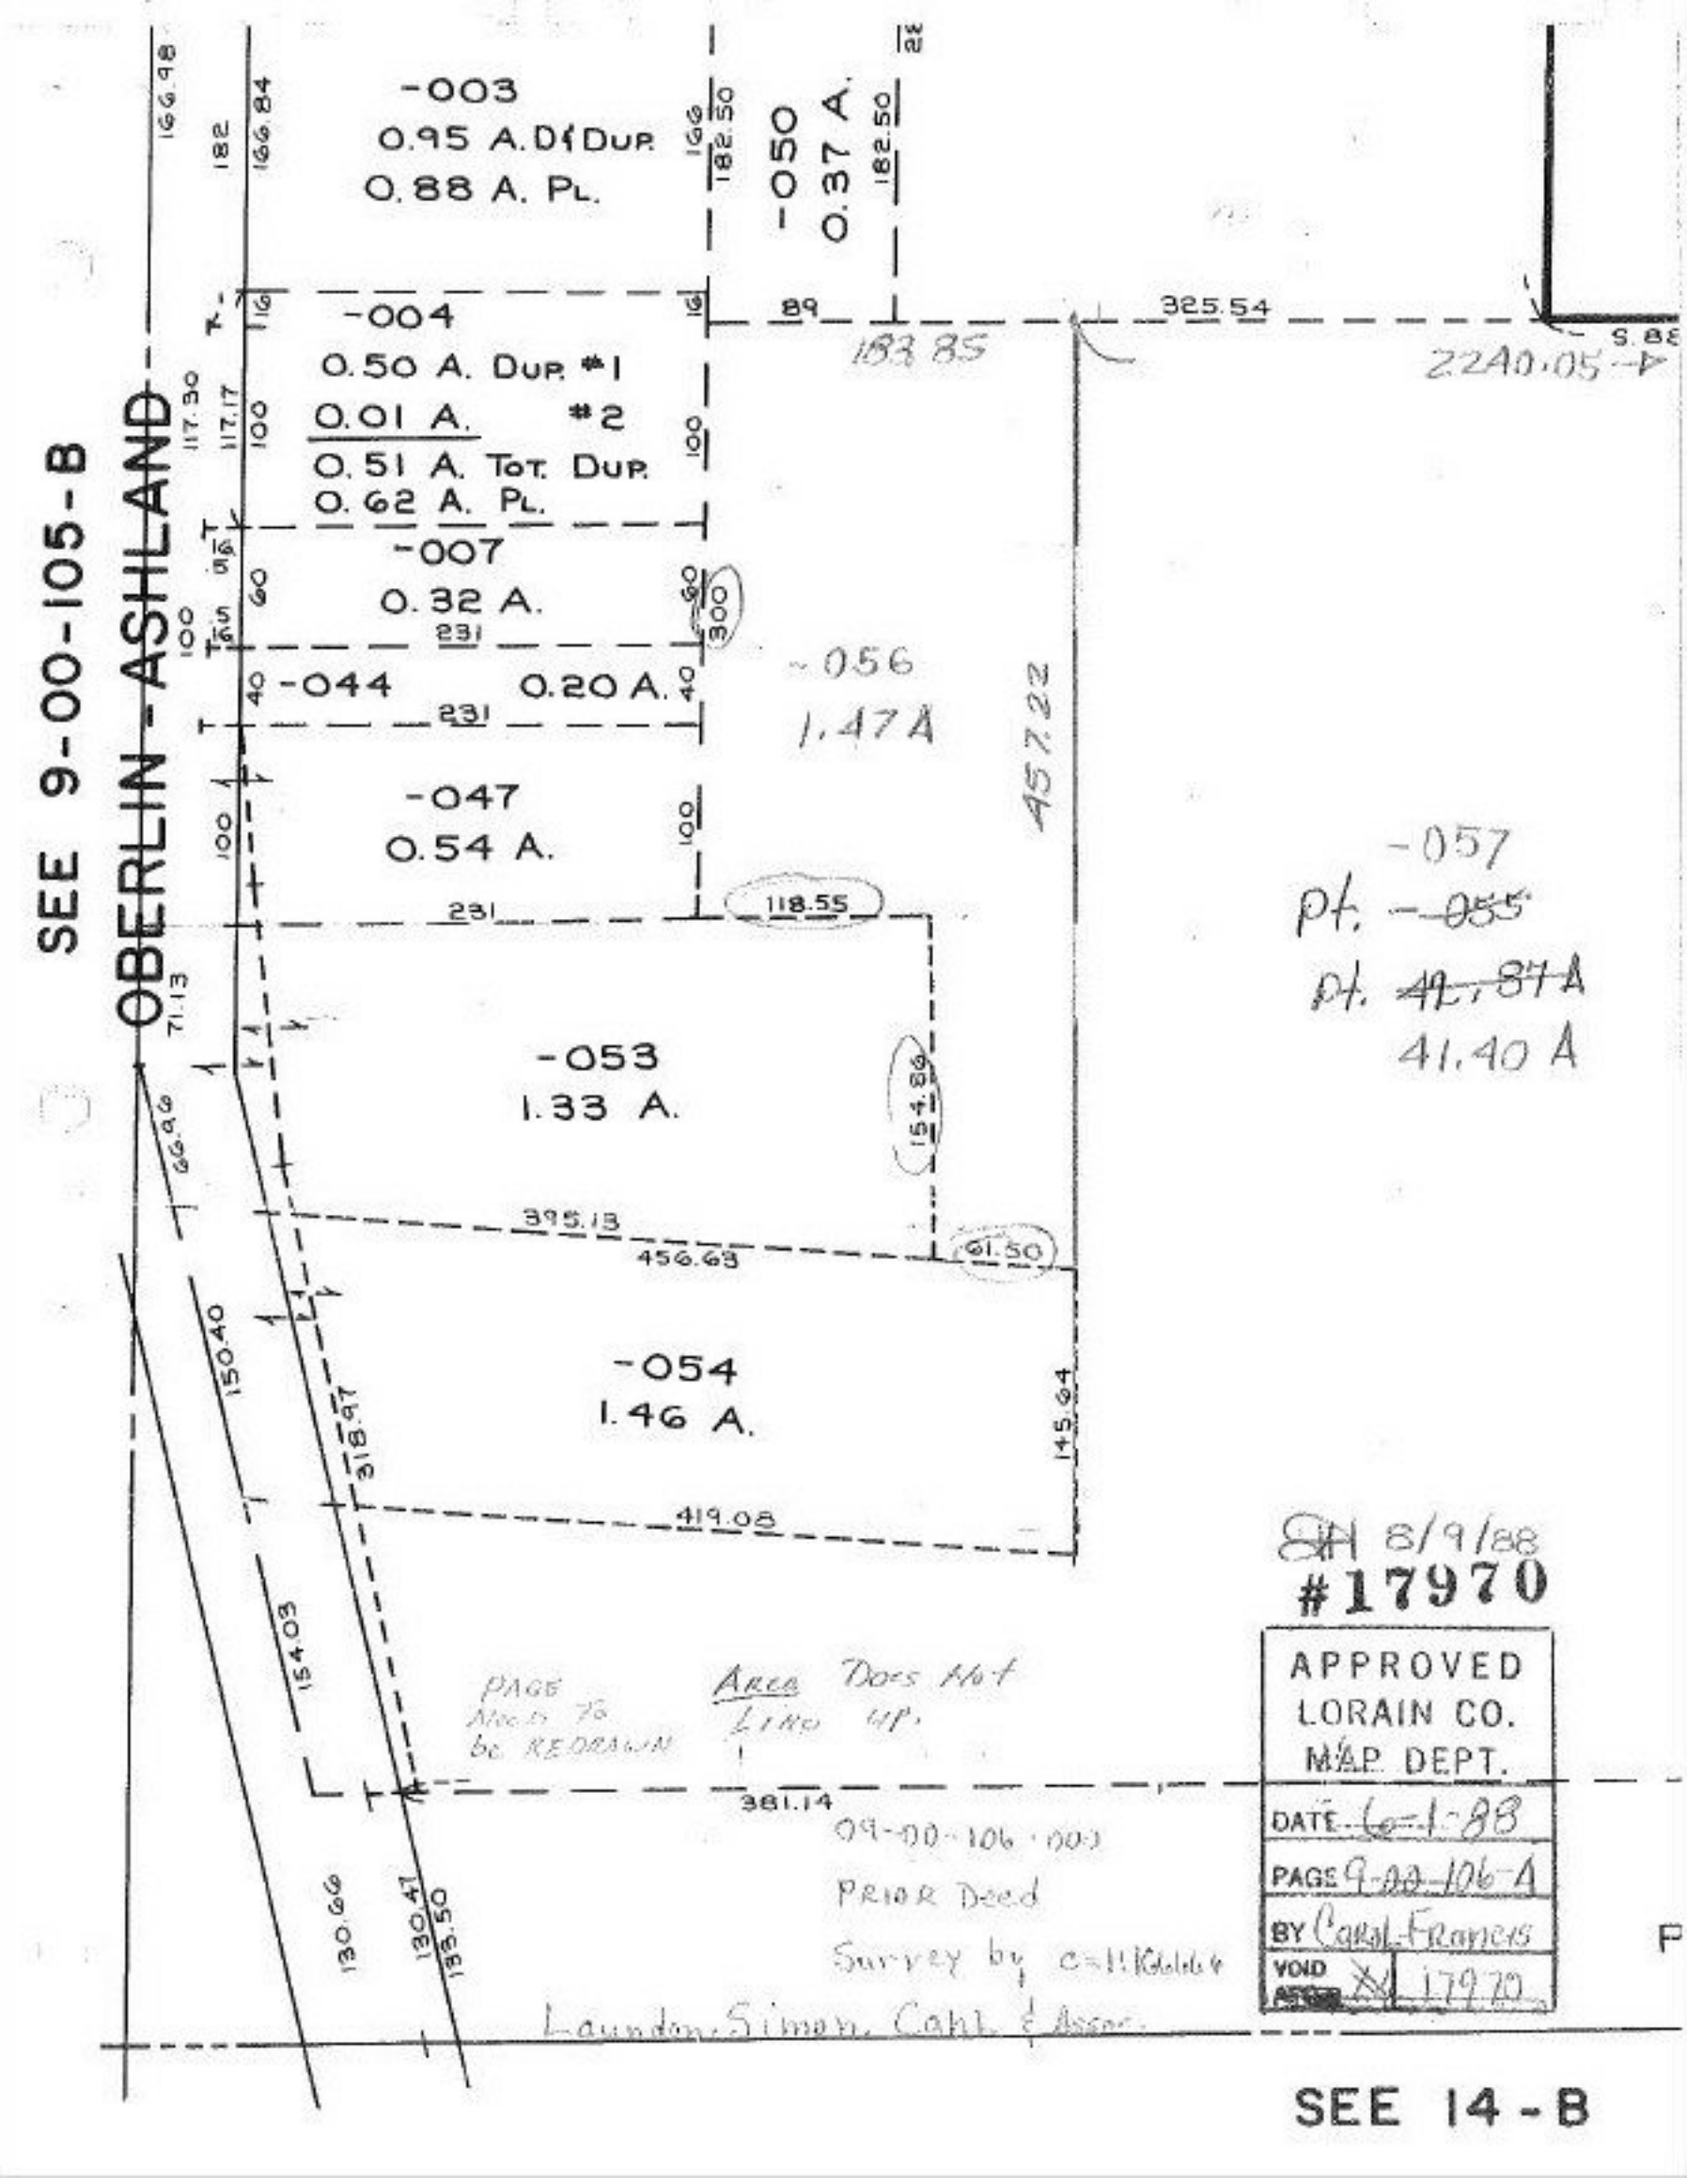
SEE 9-00-105-B
OBERLIN - ASHLAND
-003
0.95 A. Dup
0.88 A. Pl.
-050
0.37 A.
-004
0.50 A. Dup. #1
0.01 A. #2
0.51 A. Tot. Dup.
0.62 A. Pl.
-007
0.32 A.
-044 0.20 A.
-047
0.54 A.
-053
1.33 A.
-054
1.46 A.
-056
1.47 A
-057
pt. -055
pt. 41.87 A
41.40 A
166.98
166.84
182
182.50
182.50
325.54
183.85
2240.05
117.30
117.17
100
60
231
300
457.22
118.55
71.13
154.89
61.50
395.13
456.63
145.64
150.40
318.97
419.08
154.03
381.14
130.66
130.41
185.50
PAGE Needs To be REDRAWN
Area Does Not Line up.
09-00-106.003
Prior Deed
Survey by Lawndon, Simon, Cahl & Assoc.
SH 8/9/88
#17970
APPROVED
LORAIN CO.
MAP DEPT.
DATE 6-1-88
PAGE 9-00-106-A
BY Carol Frances
VOID
ASSGN XX 17970
SEE 14-B