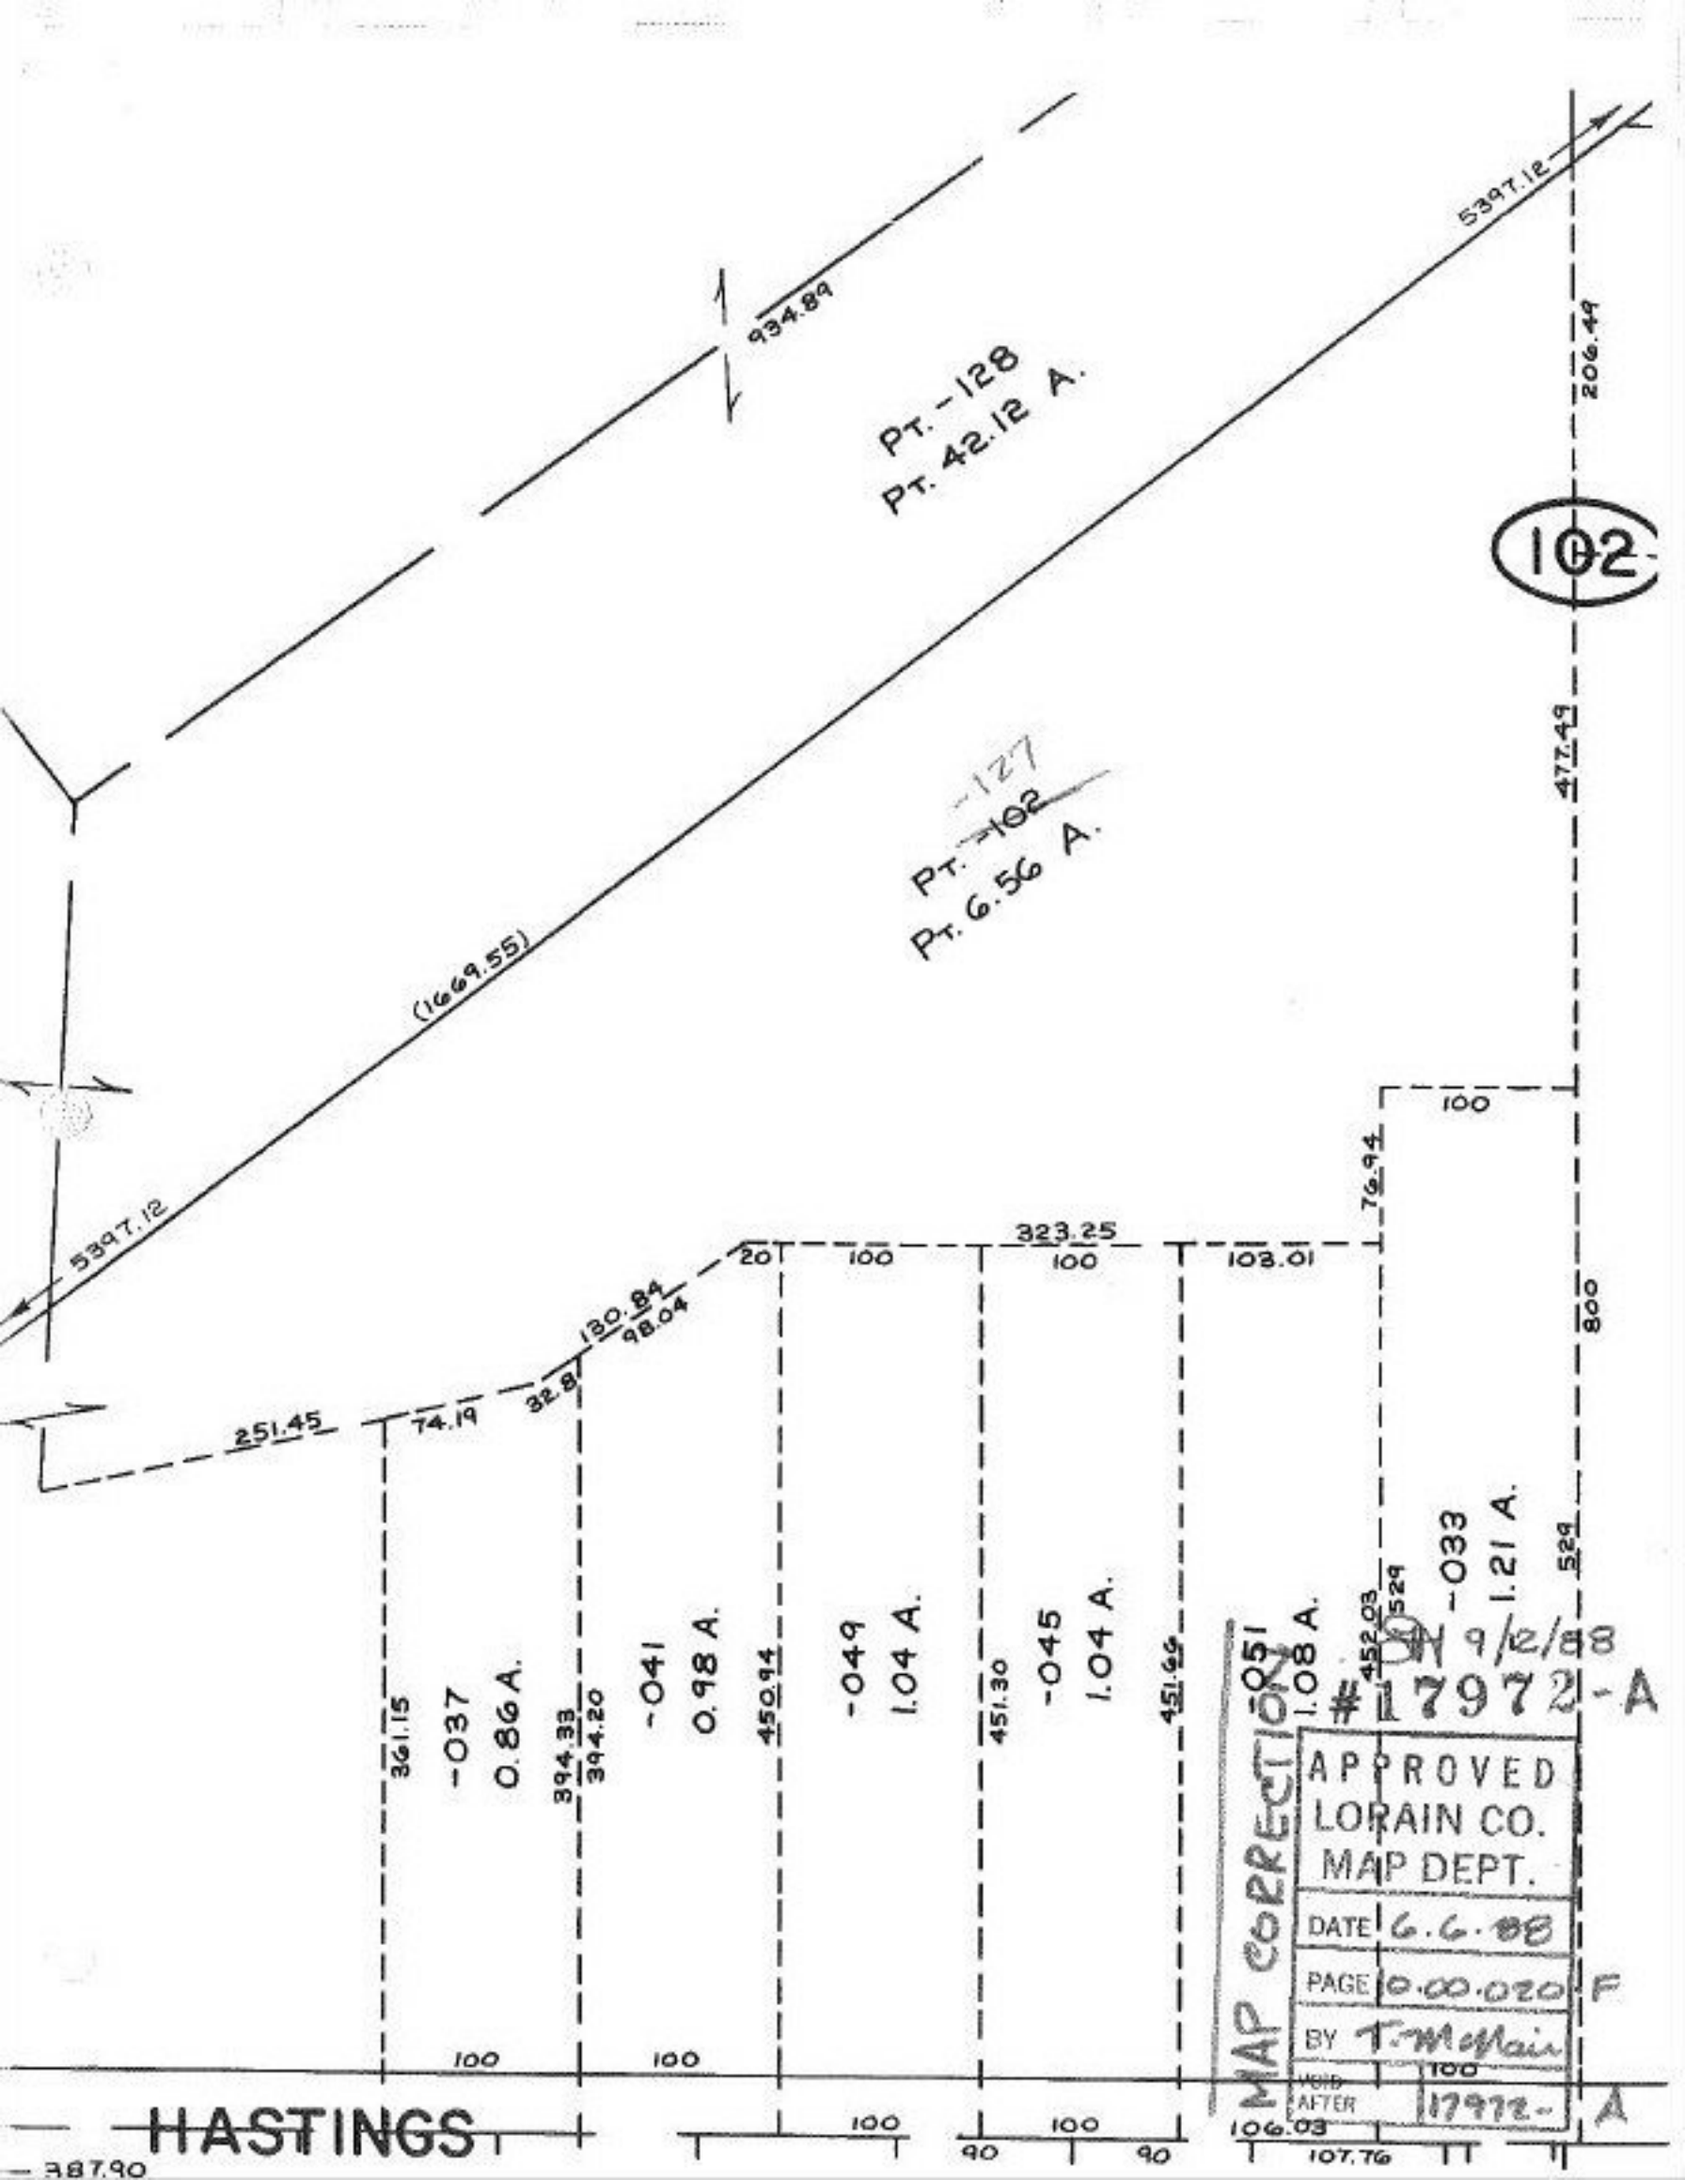
5397.12
934.89
PT. -128
PT. 42.12 A.
206.49
102
477.49
-127
PT. -102
PT. 6.56 A.
(1669.55)
5397.12
100
76.94
323.25
100
103.01
20
100
130.84
98.04
800
251.45
74.19
32.8
-037
0.86 A.
-041
0.98 A.
-049
1.04 A.
-045
1.04 A.
-051
1.08 A.
-033
1.21 A.
361.15
394.33
394.20
450.94
451.30
451.66
452.03
529
529
MAP CORRECTION
9/12/88
#17972-A
APPROVED
LORAIN CO.
MAP DEPT.
DATE 6.6.88
PAGE 0.00.020 F
BY T. McClain
VOID
AFTER 17972-A
100
100
100
100
100
90
90
106.03
107.76
HASTINGS
387.90