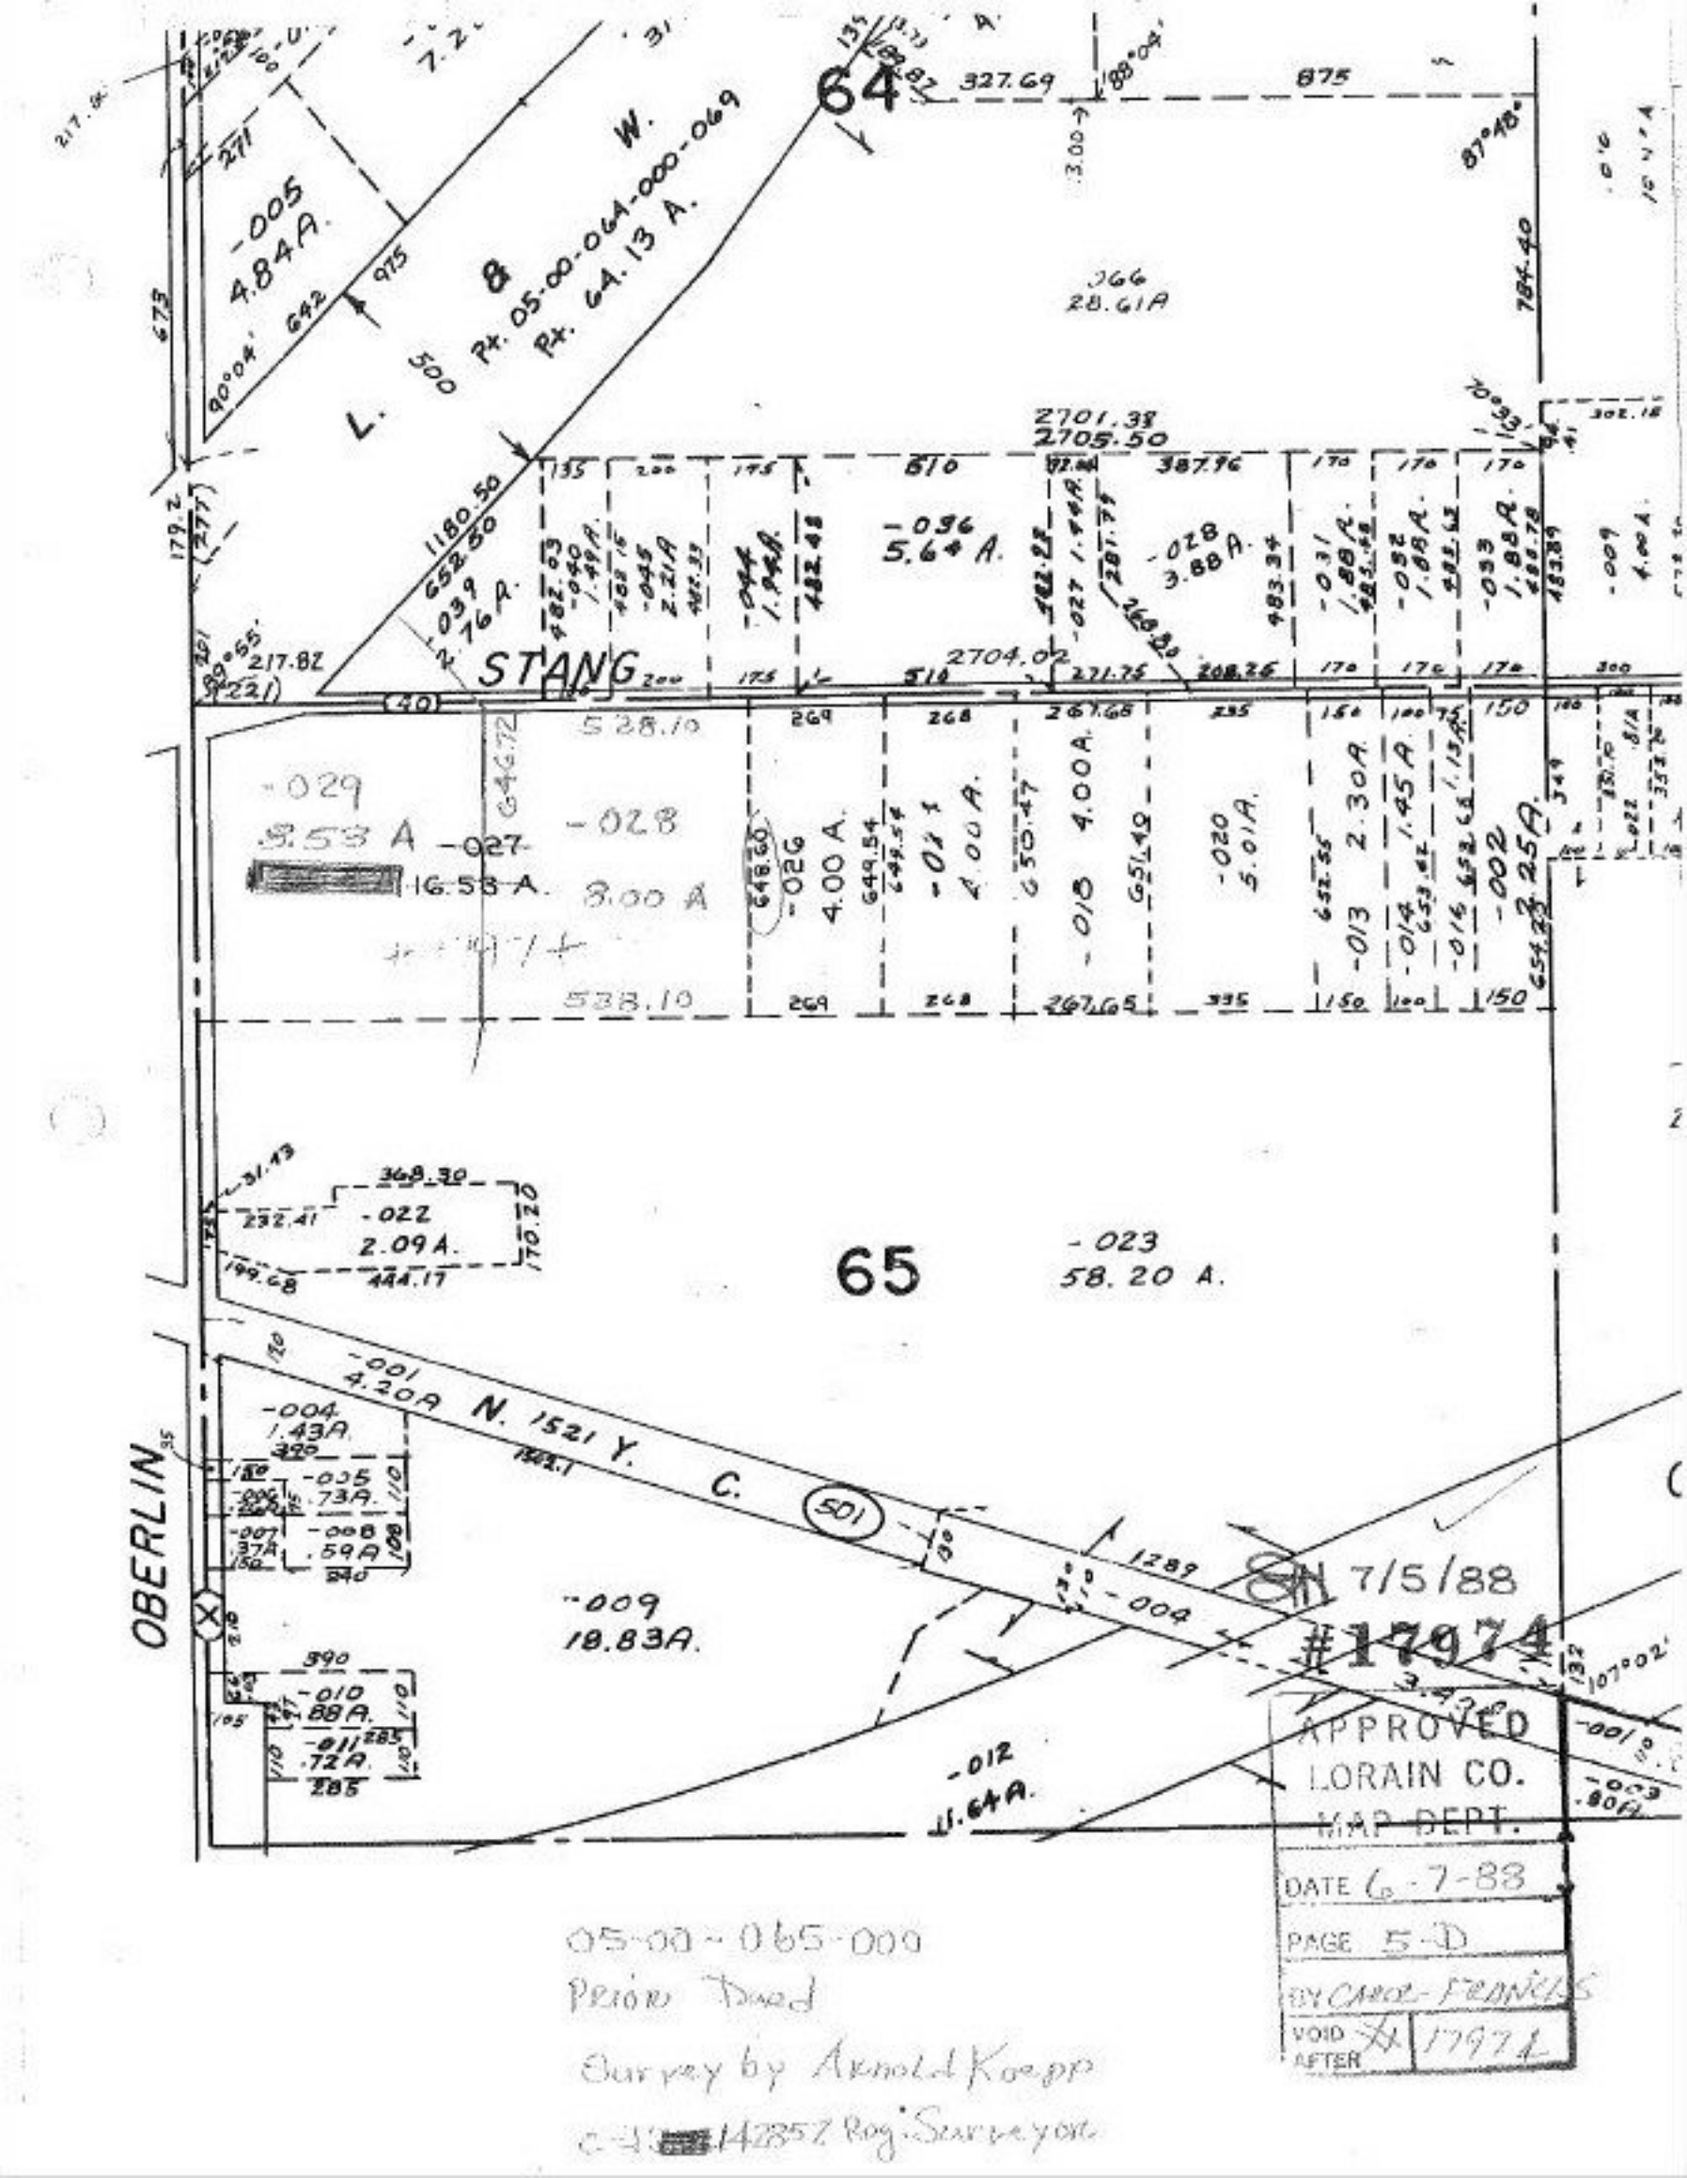

05-00-065-000
Prior Deed
Survey by Arnold Koepp
#14257 Reg. Surveyor