5-00-025-B

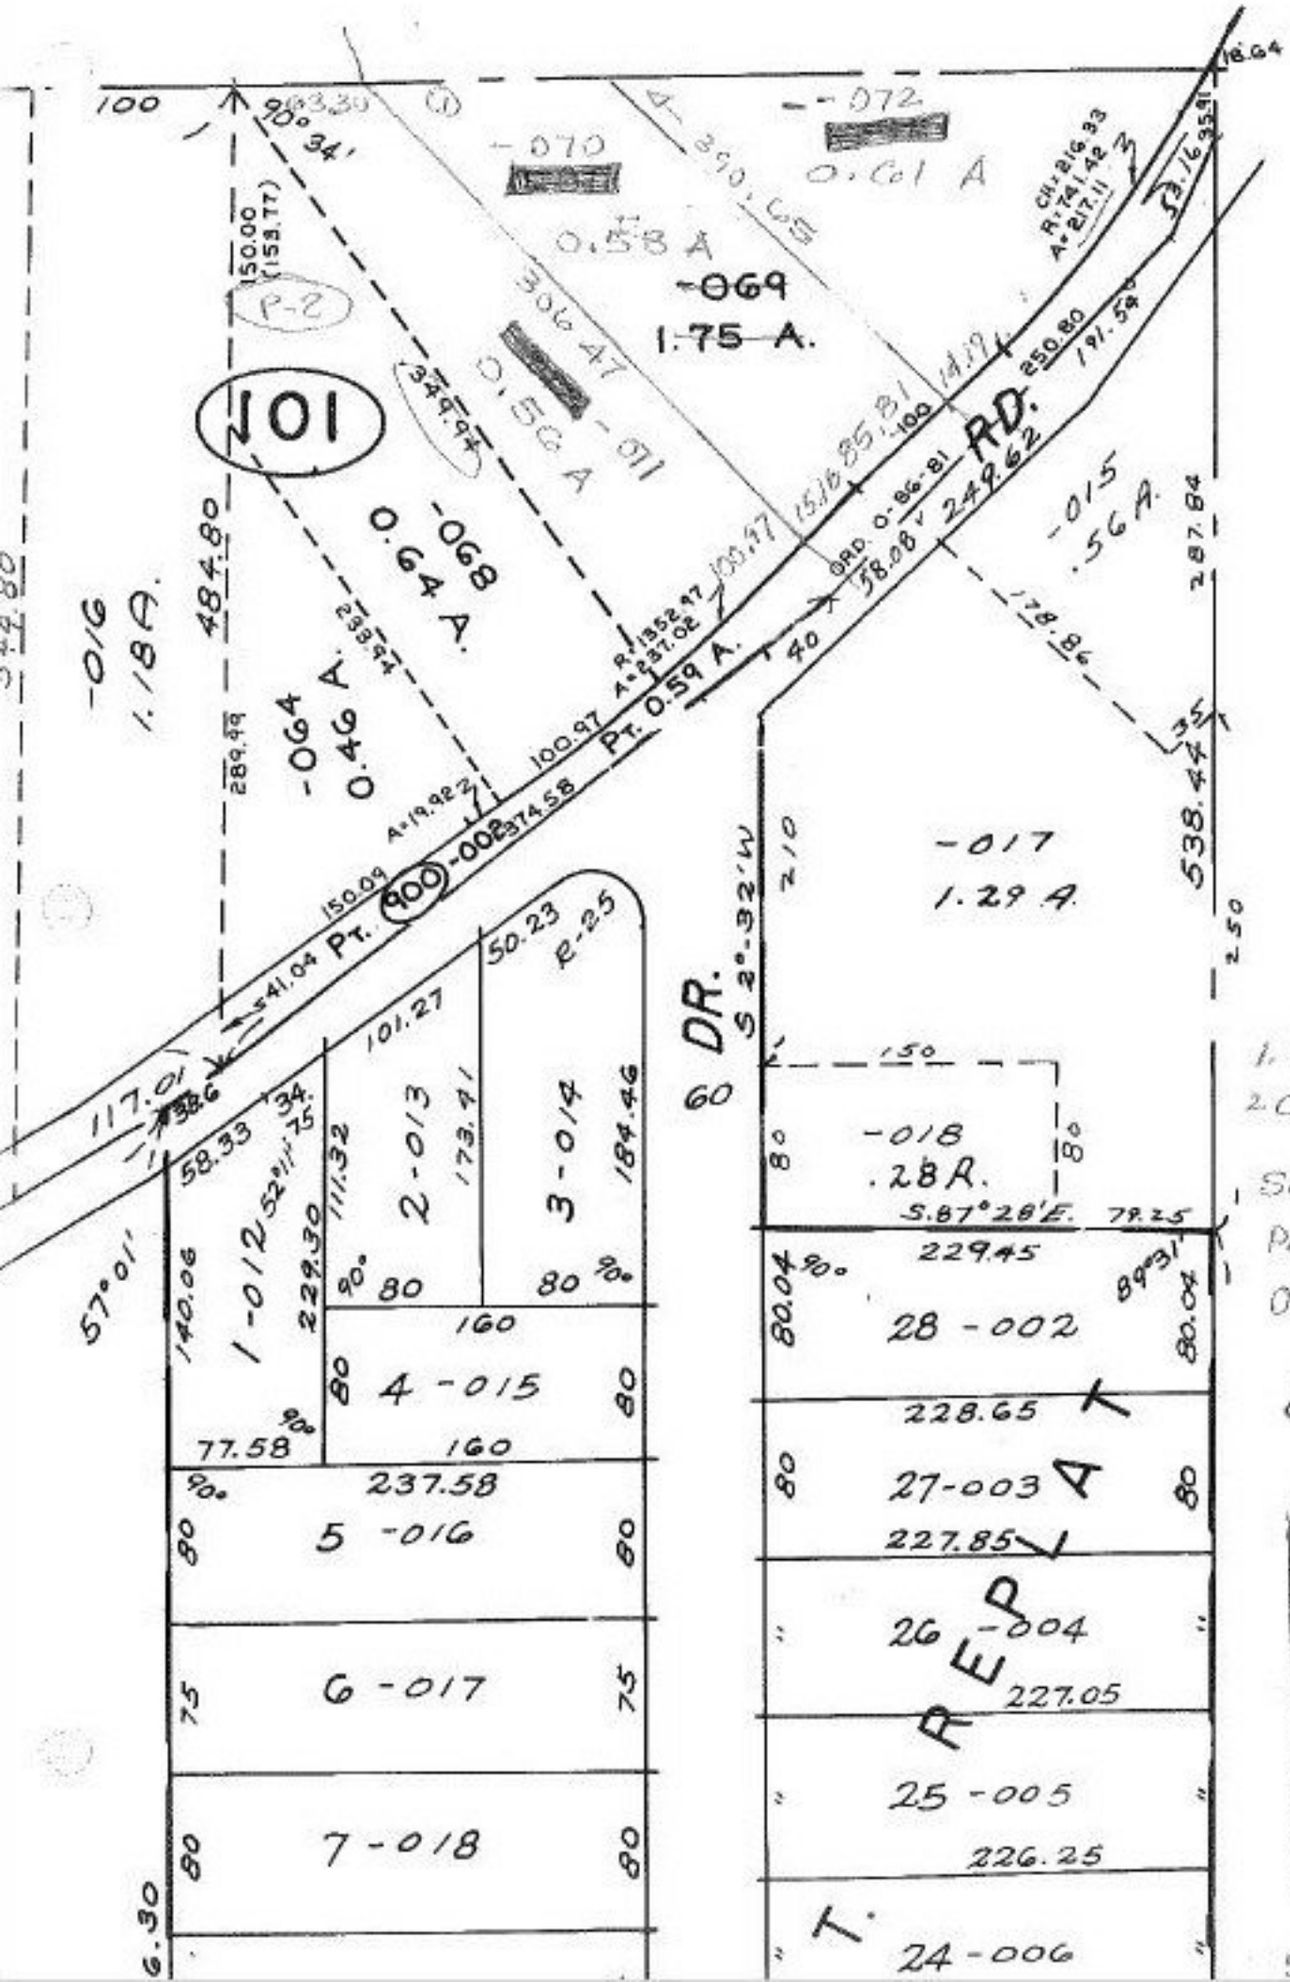

1. C=1:100000
2. C=1:125000

Survey by M. Hura
Prior Deed 1113-712
05-00-026-101

SH 7/5/88
#17976

APPROVED
LORAIN CO.
MAP DEPT.
DATE 6-7-88
PAGE 5-00-026-B
BY CAROL FRANCIS
VOID AFTER 17976

5-00-026-C