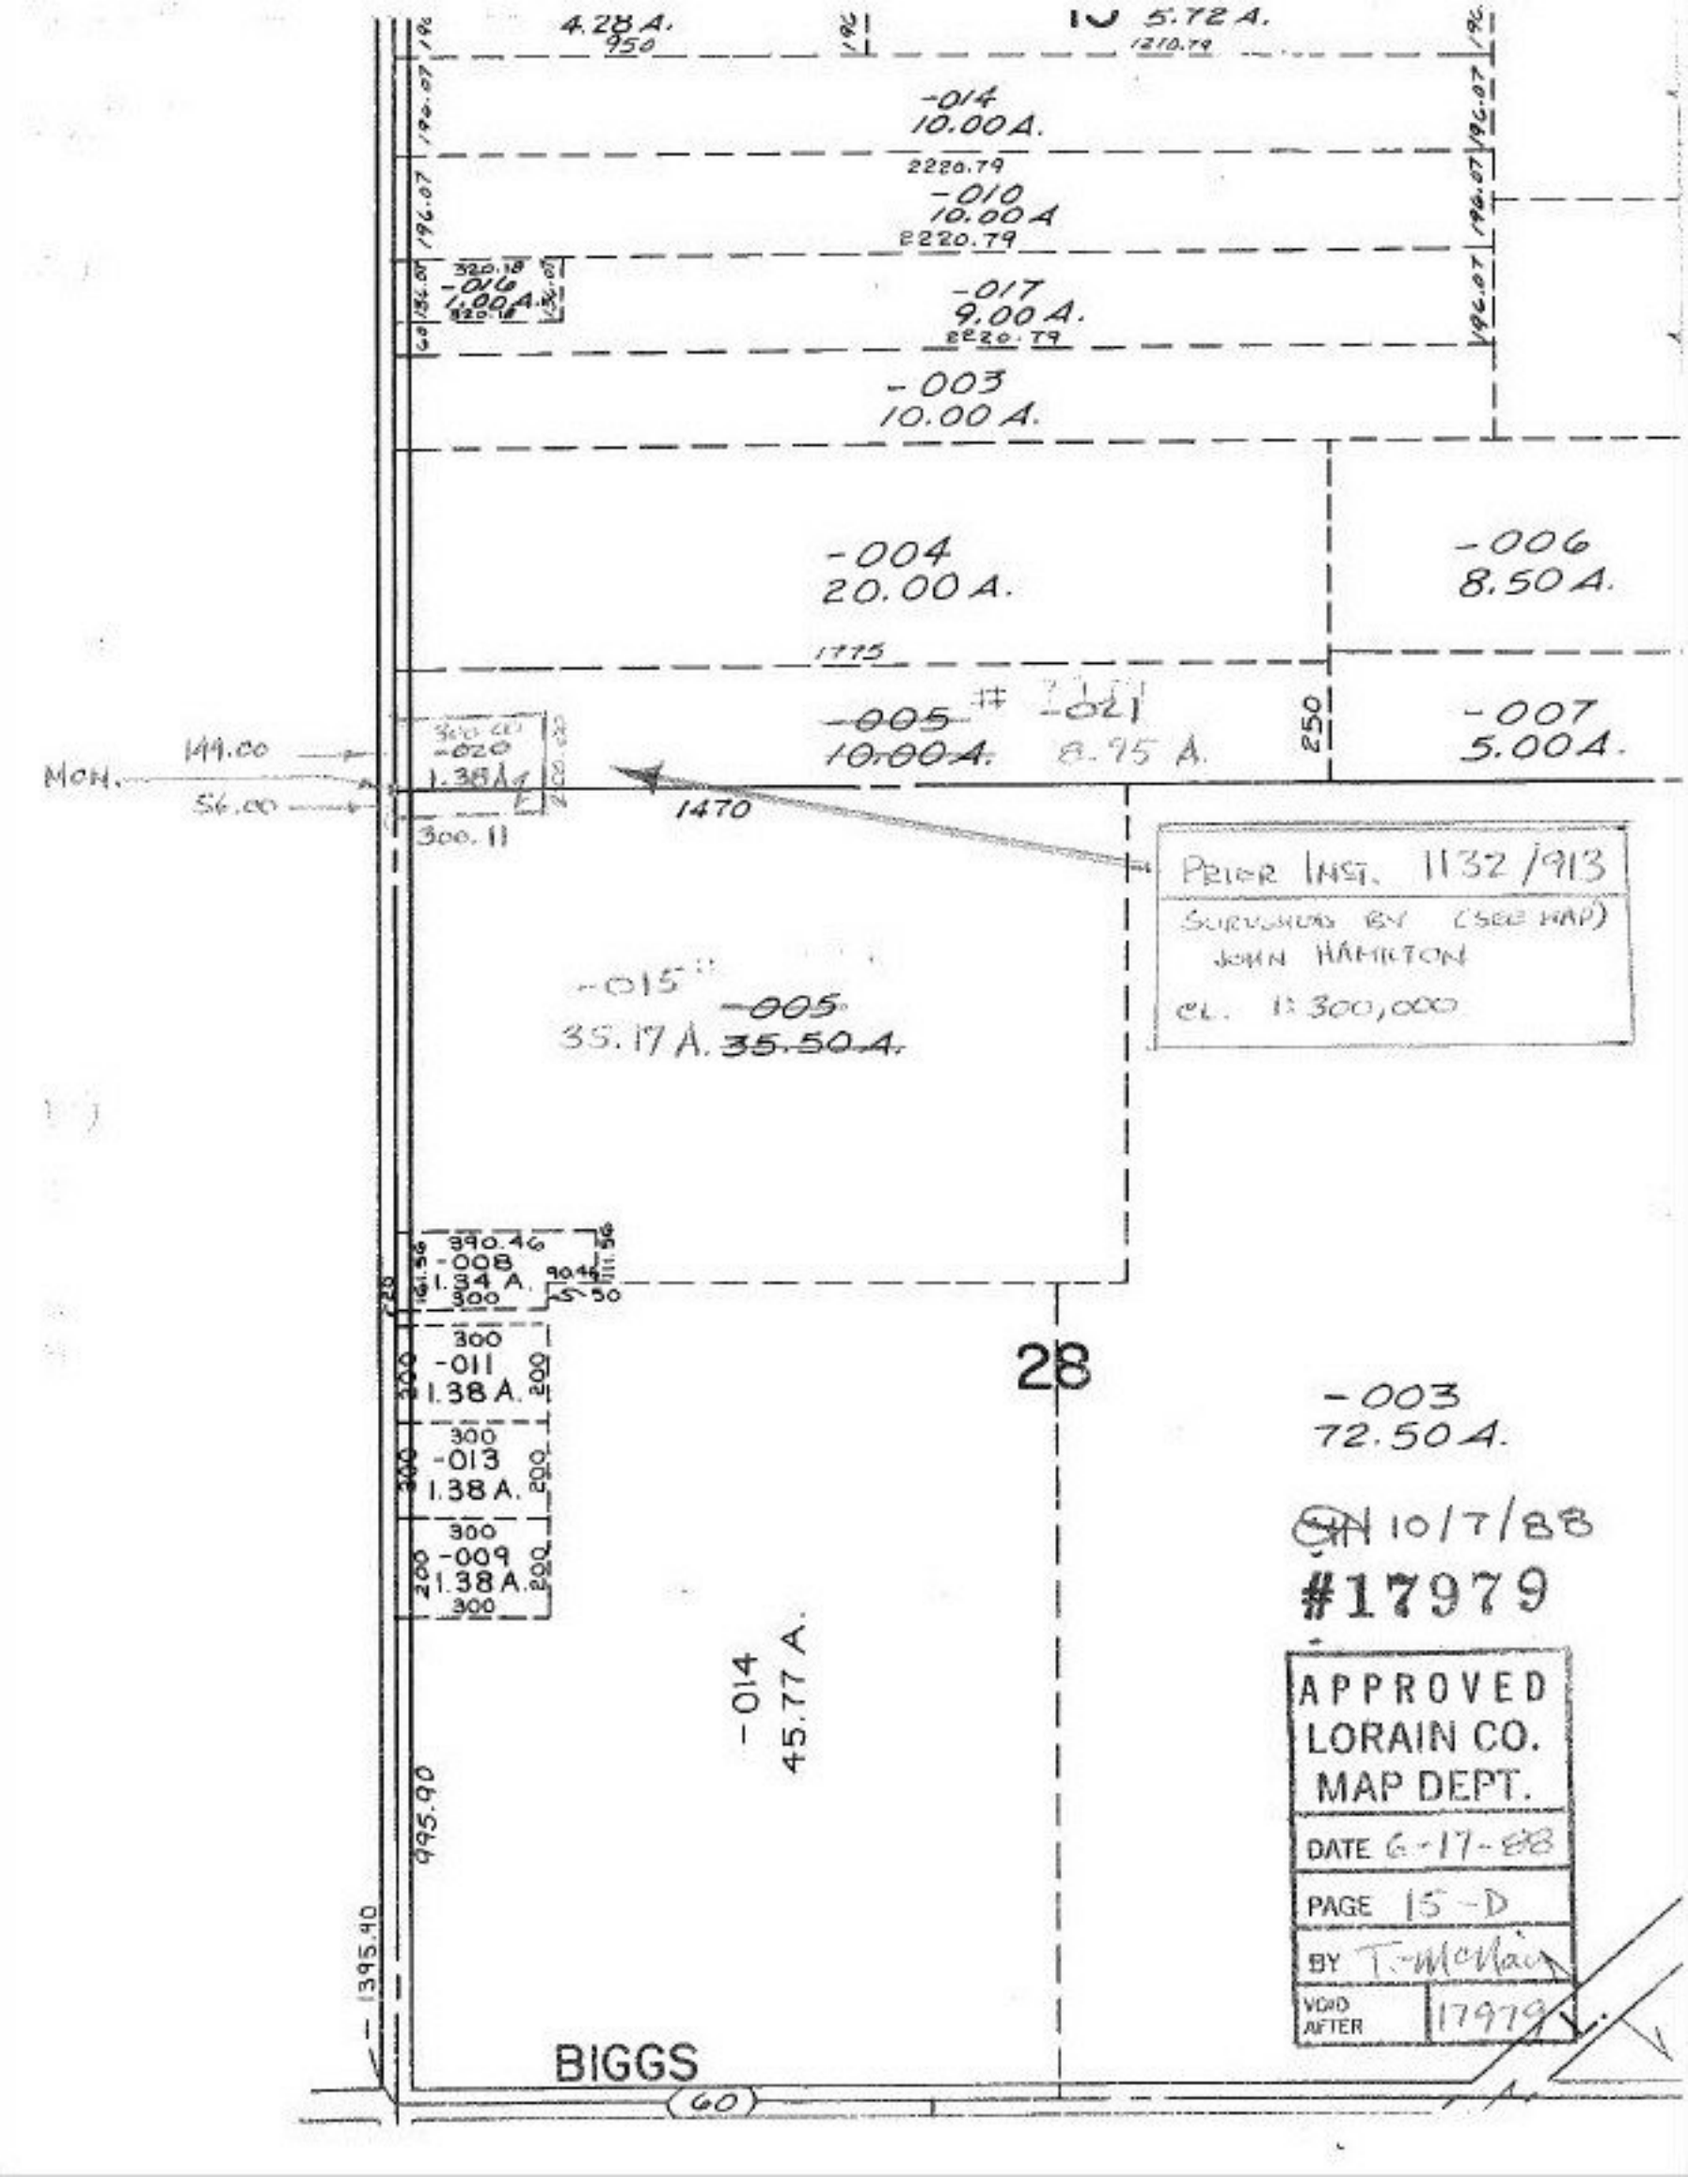
4.28 A.
950
5.72 A.
1210.79
-014
10.00 A.
2220.79
-010
10.00 A
2220.79
320.18
-016
1.00 A.
320.18
-017
9.00 A.
2220.79
-003
10.00 A.
-004
20.00 A.
-006
8.50 A.
1775
-005
10.00 A.
8.95 A.
-007
5.00 A.
250
149.00
MON.
56.00
-020
1.38 A.
300.11
1470
PRIOR INST. 1132/913
SURVEYED BY (SEE MAP)
JOHN HAMILTON
EL. 1:300,000
-015
35.17 A.
-005
35.50 A.
390.46
-008
1.34 A.
300
300
-011
1.38 A.
200
300
-013
1.38 A.
200
300
-009
1.38 A.
200
300
28
-003
72.50 A.
-014
45.77 A.
995.90
1395.90
BIGGS
60
10/7/88
#17979
APPROVED
LORAIN CO.
MAP DEPT.
DATE 6-17-88
PAGE 15-D
BY T. McHale
VOID AFTER 17979