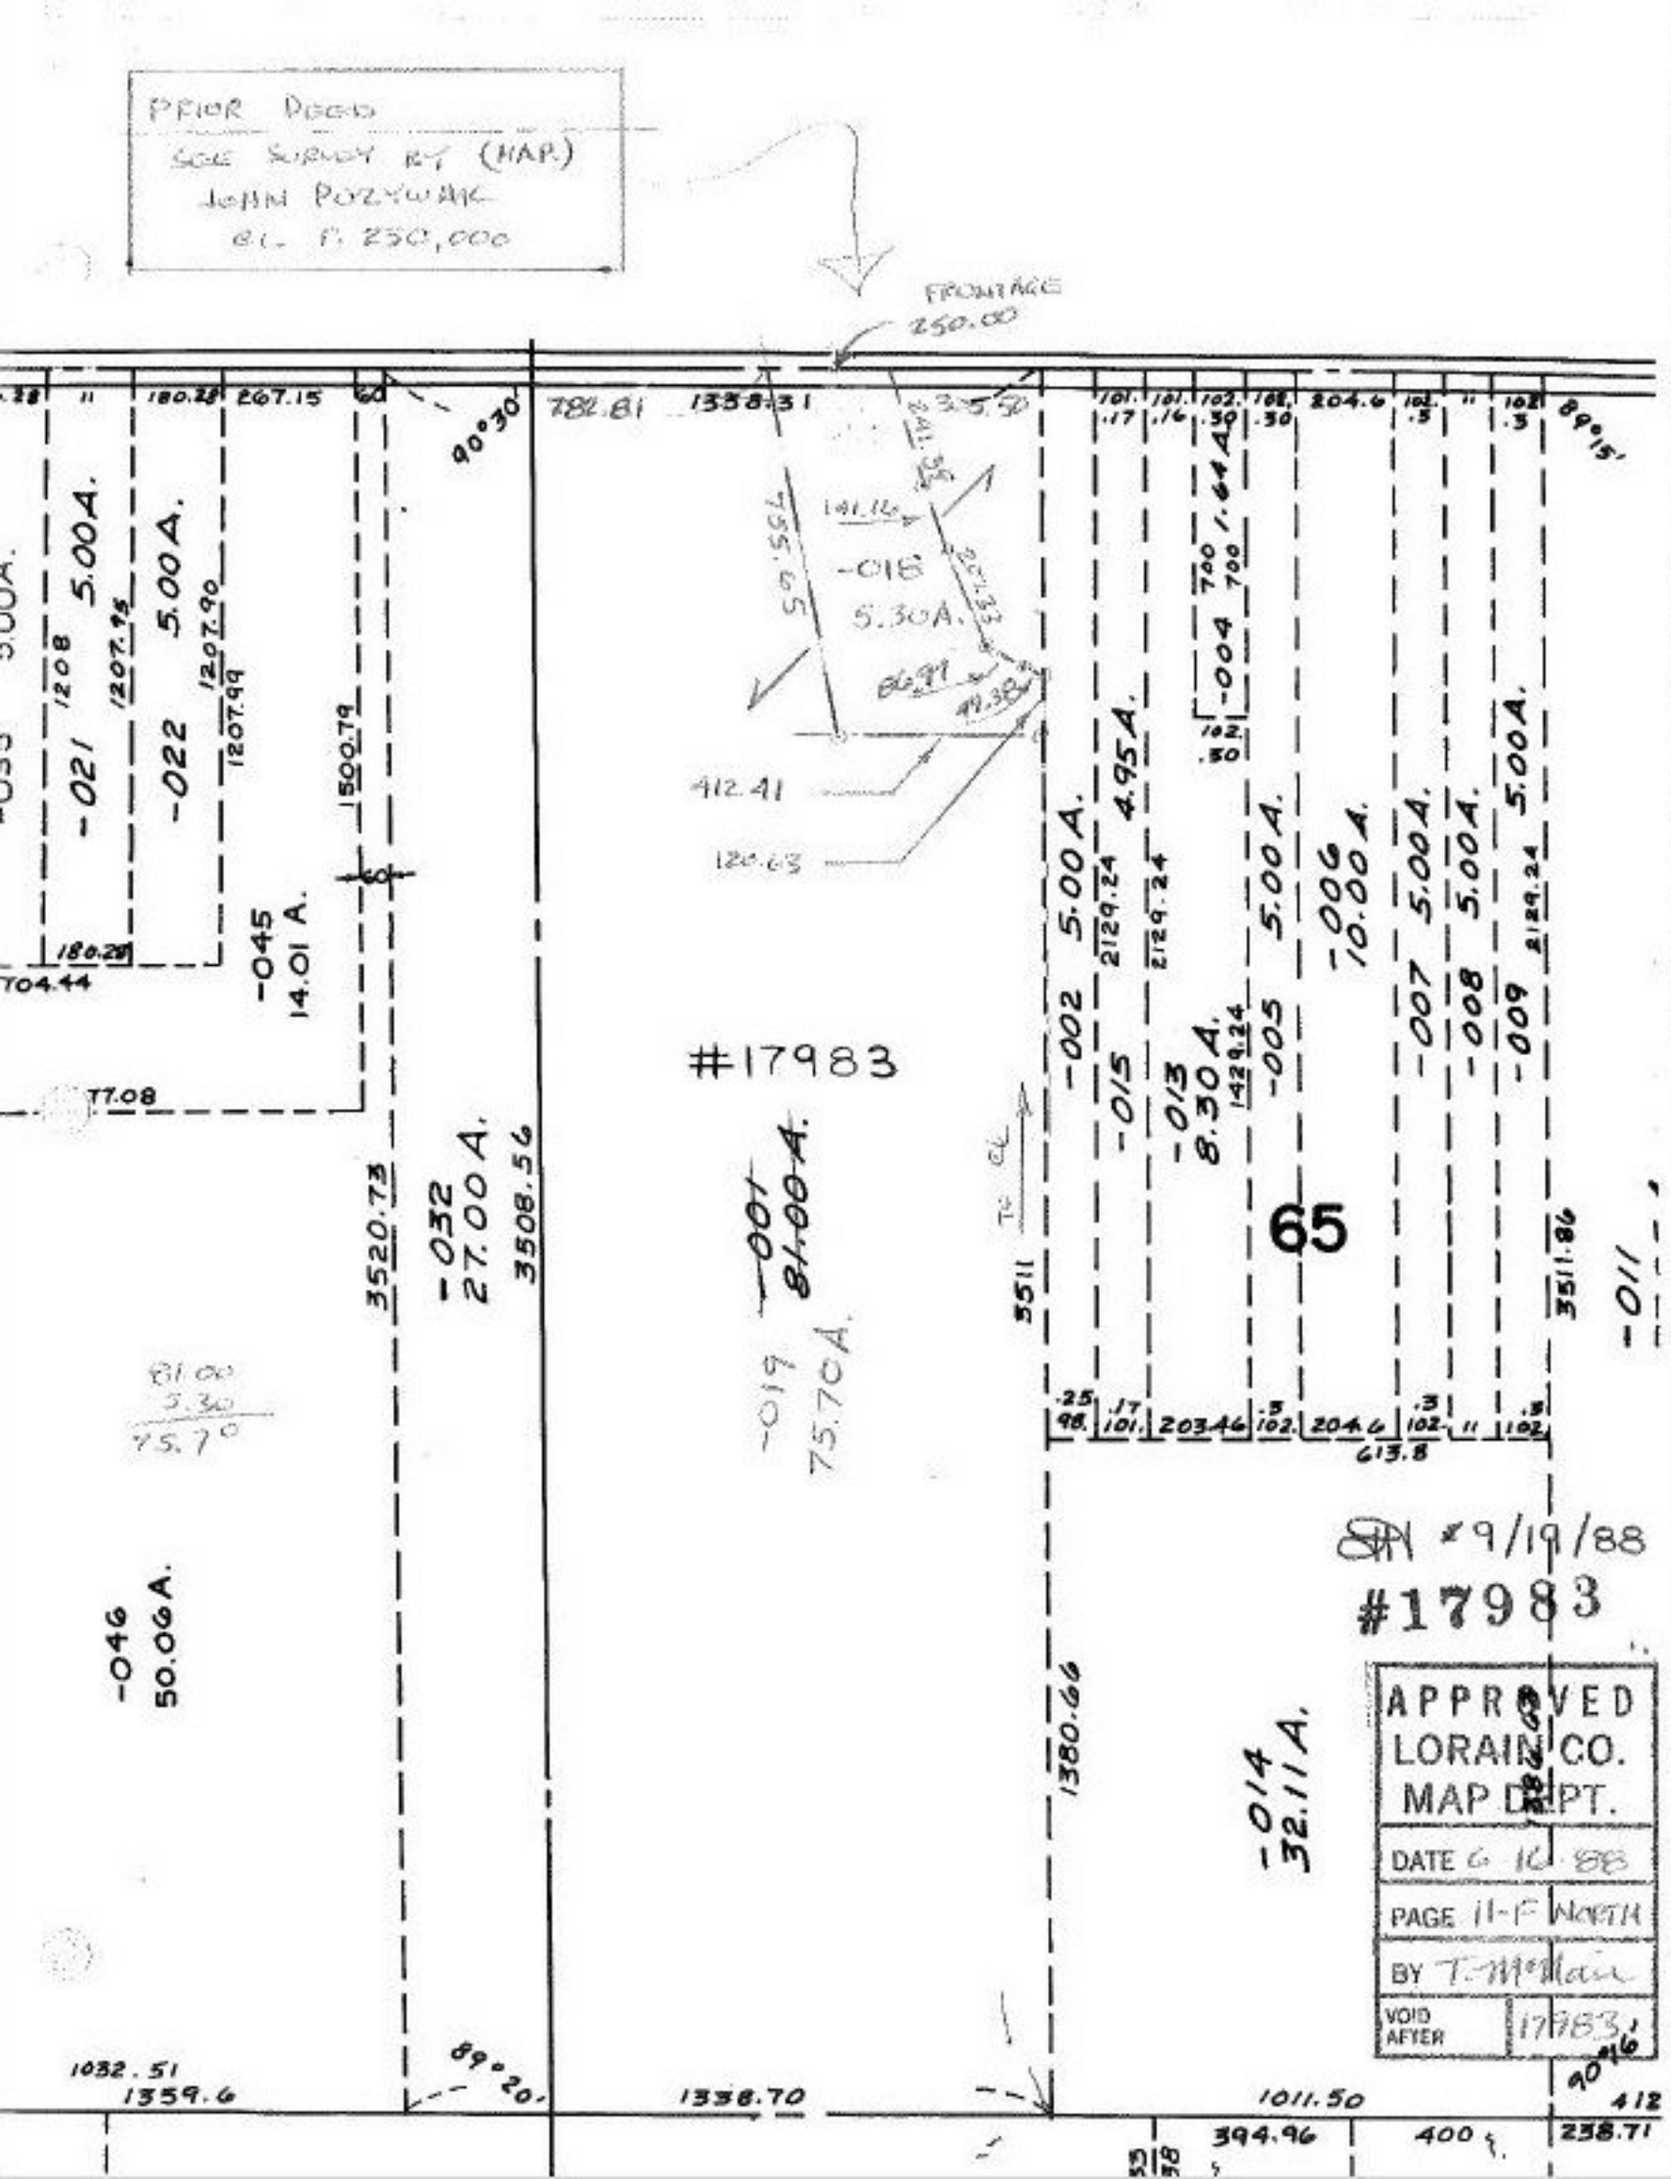
PRIOR DEED
SOLE SURVEY RT (MAP)
JOHN POZYWAK
AL. F. 250,000
FRONTAGE
250.00
782.81
1358.31
305.50
90°30'
90°15'
-021
5.00A.
1208
1207.75
180.28
-022
5.00A.
1207.99
1207.90
267.15
60
1500.79
-045
14.01 A.
704.44
77.08
141.16
-018
5.30A.
412.41
120.63
-002
5.00A.
2129.24
-015
4.95A.
-013
8.30A.
1429.24
-005
5.00A.
-004
1.64A.
700
700
-006
10.00A.
-007
5.00A.
-008
5.00A.
-009
5.00A.
2129.24
#17983
-001
81.00A.
-019
75.70A.
65
3511
3511.86
-011
3520.73
-032
27.00A.
3508.56
81.00
5.30
75.7°
-046
50.06A.
1380.66
-014
32.11A.
1032.51
1359.6
89°20'
1338.70
1011.50
394.96
400
238.71
613.8
APPROVED
LORAIN CO.
MAP DEPT.
DATE 6-10-88
PAGE 11-F NORTH
BY T. McClain
VOID AFTER 17783
9/19/88
#17983