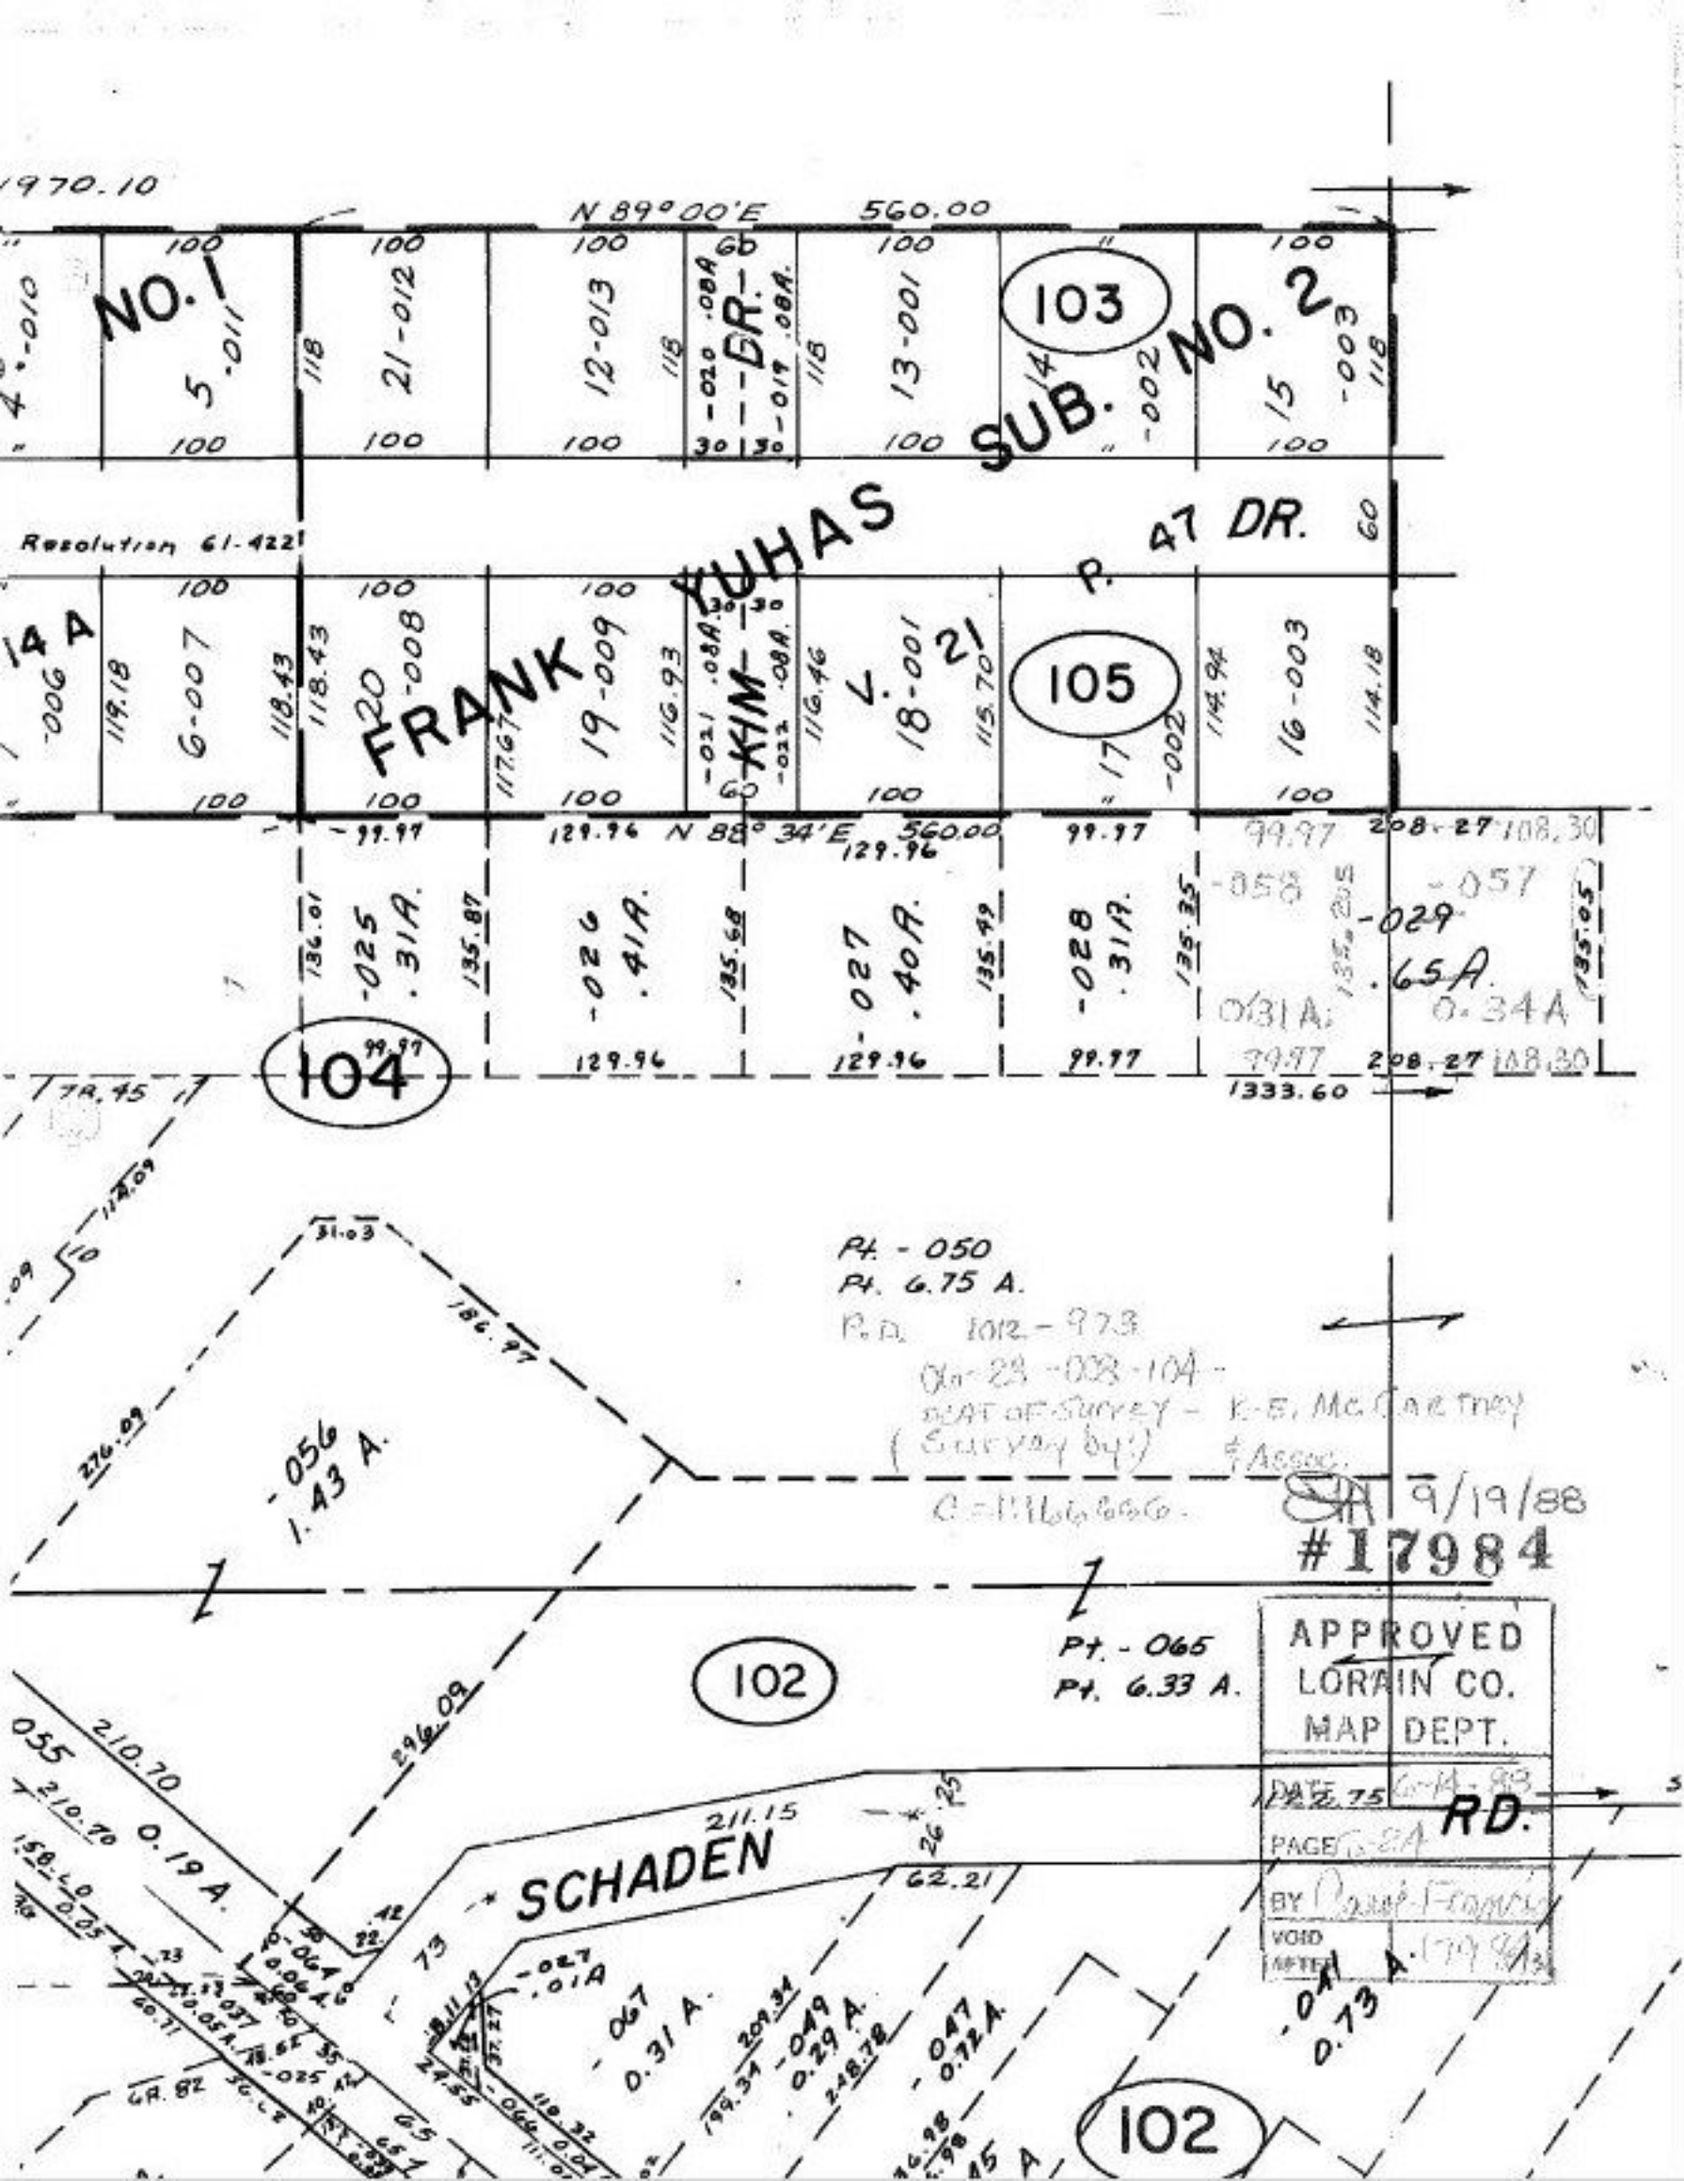
1970.10
N 89° 00' E 560.00
NO. 1
SUB. NO. 2
DR.
103
105
104
102
FRANK KUHAS
KIM DR.
Resolution 61-422
N 88° 34' E 560.00
APPROVED
LORAIN CO.
MAP DEPT.
DATE 6-14-88
PAGE 6-21A
BY
VOID
AFTER
9/19/88
#17984
SCHADEN RD.
Pt. - 050
Pt. 6.75 A.
Pt. - 065
Pt. 6.33 A.
0.19 A.
0.31 A.
0.29 A.
0.73