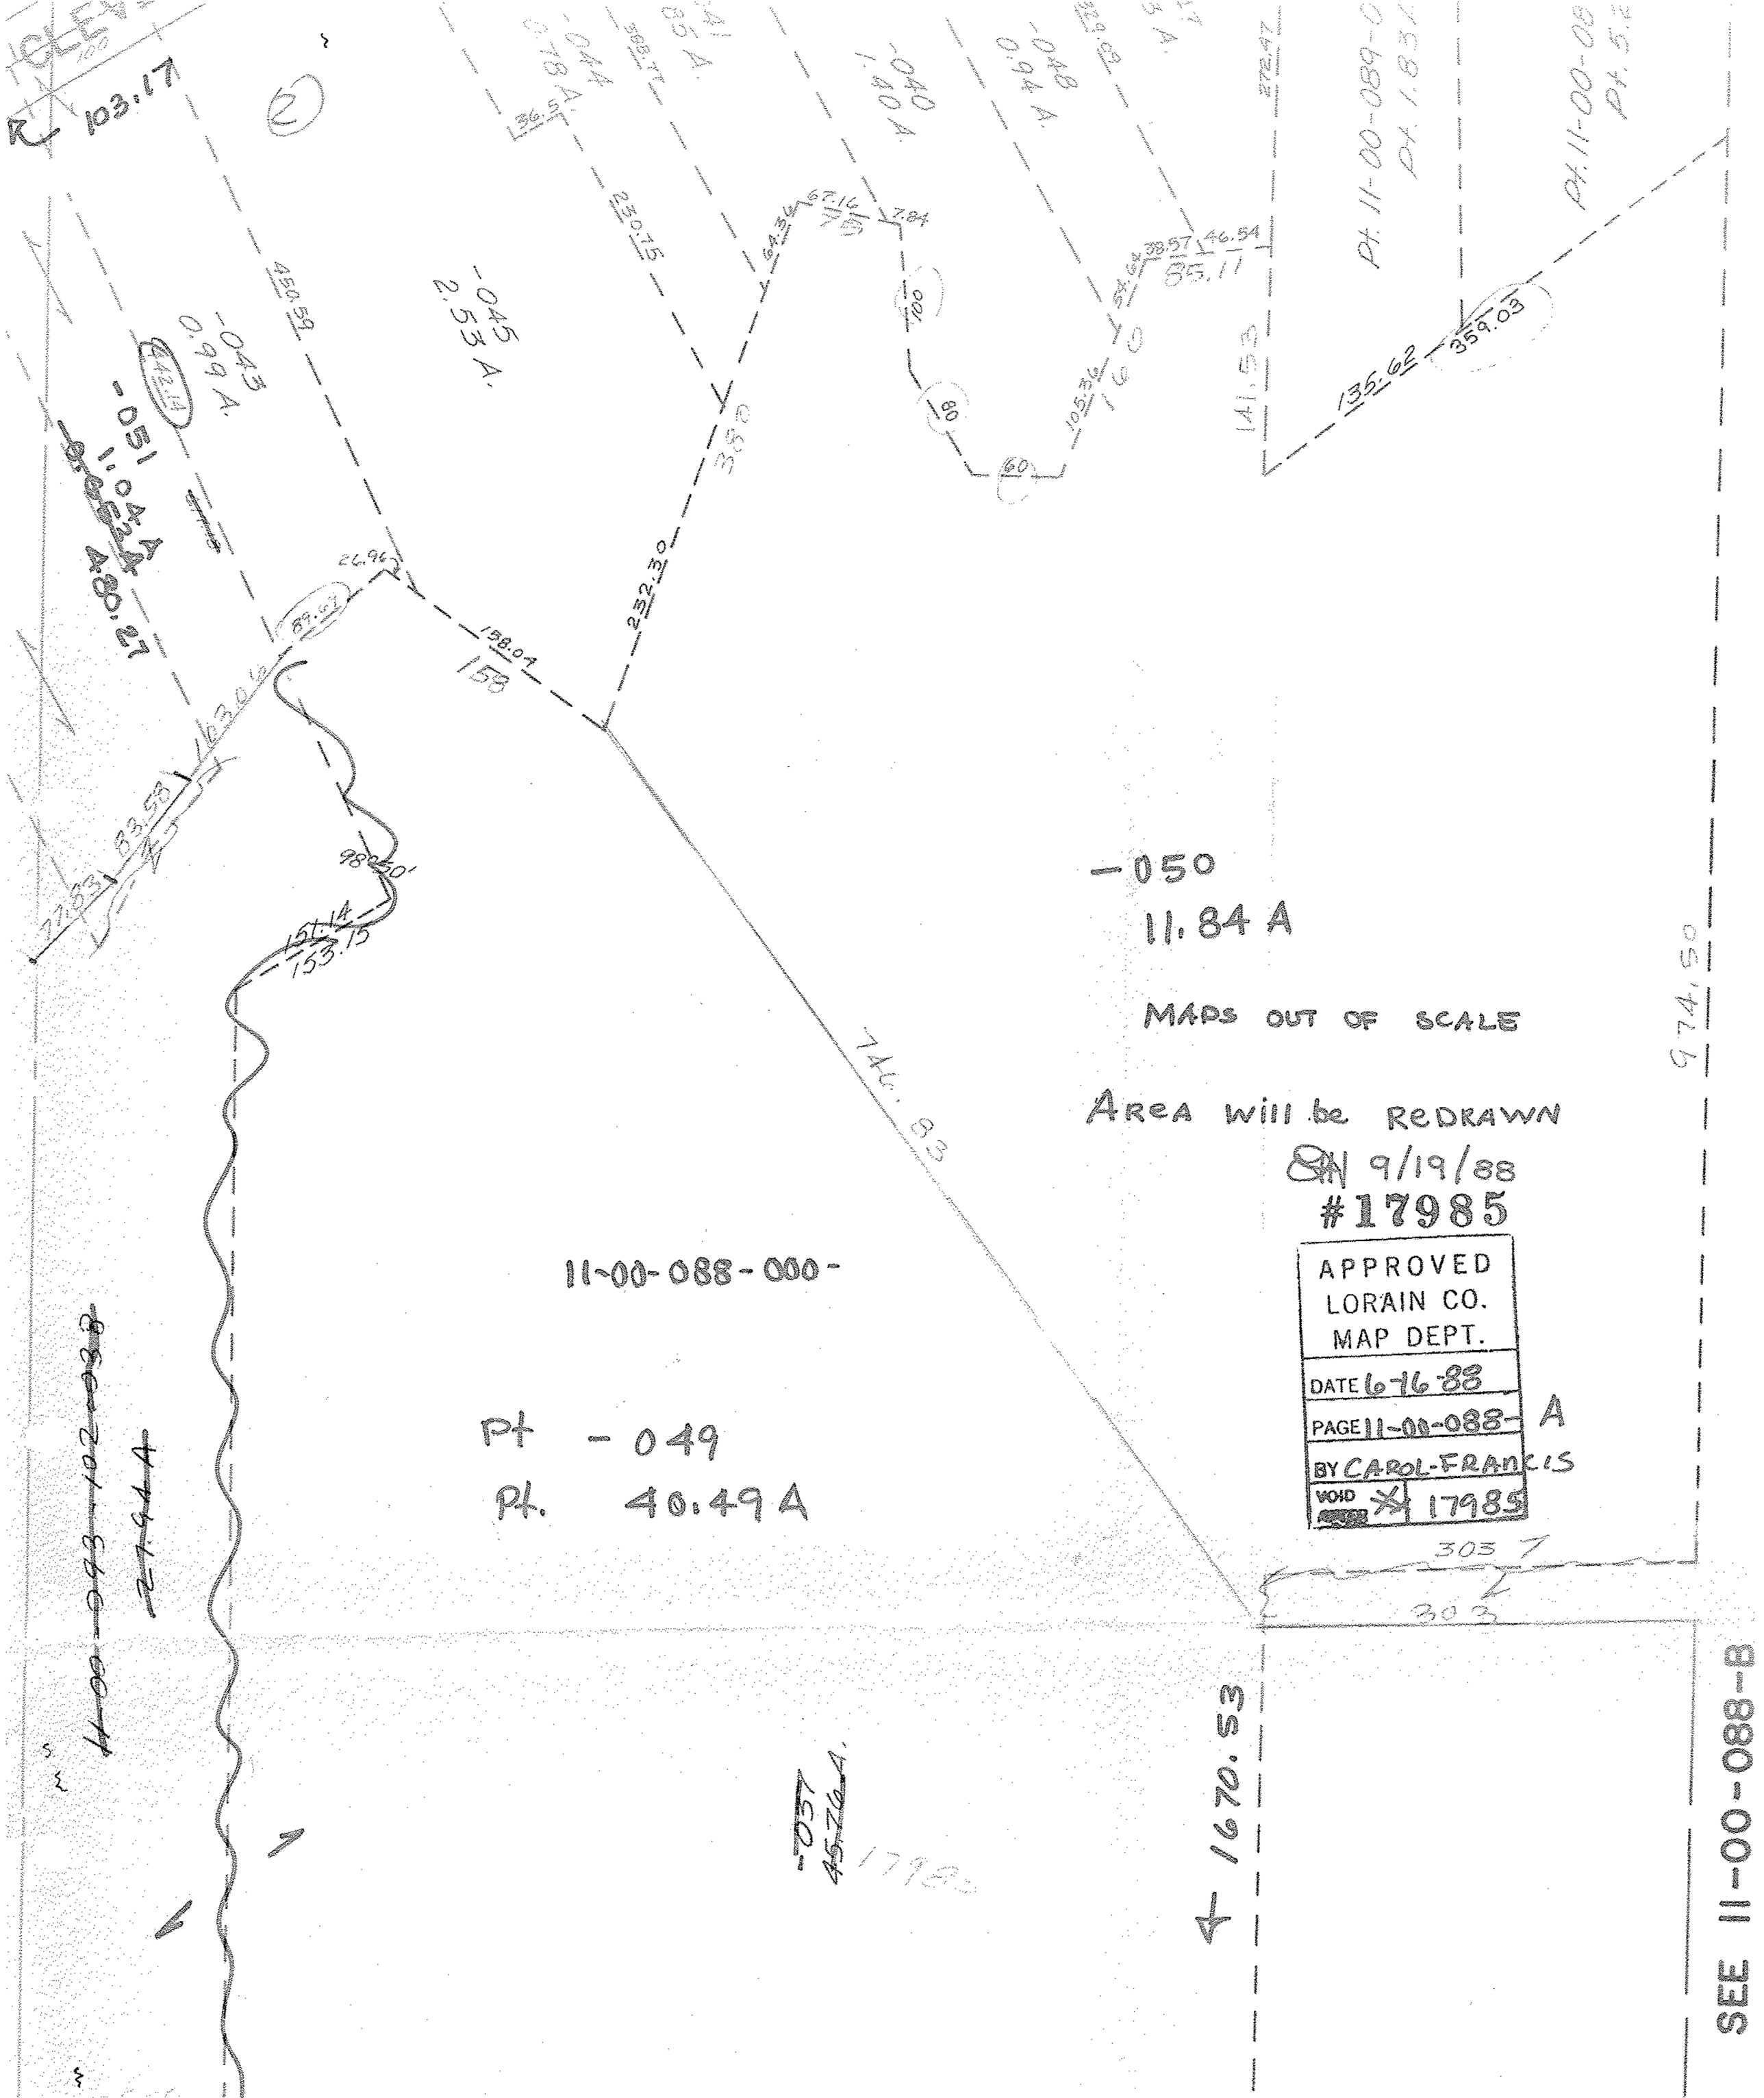

103.17
-045
2.53 A.
-043
0.99 A.
-051
1.04 A
-040
1.40 A.
-048
0.94 A.
-044
0.78 A.
Pt. 11-00-089-0
Pt. 1.83 A
Pt. 11-00-08
Pt. 5.2
135.62
359.03
141.53
-050
11.84 A
MAPS OUT OF SCALE
AREA will be REDRAWN
9/19/88
#17985
APPROVED
LORAIN CO.
MAP DEPT.
DATE 6-16-88
PAGE 11-00-088- A
BY CAROL-FRANCIS
VOID 17985
11-00-088-000-
Pt -049
Pt. 40.49 A
746.83
974.50
303
1670.53
SEE 11-00-088-B