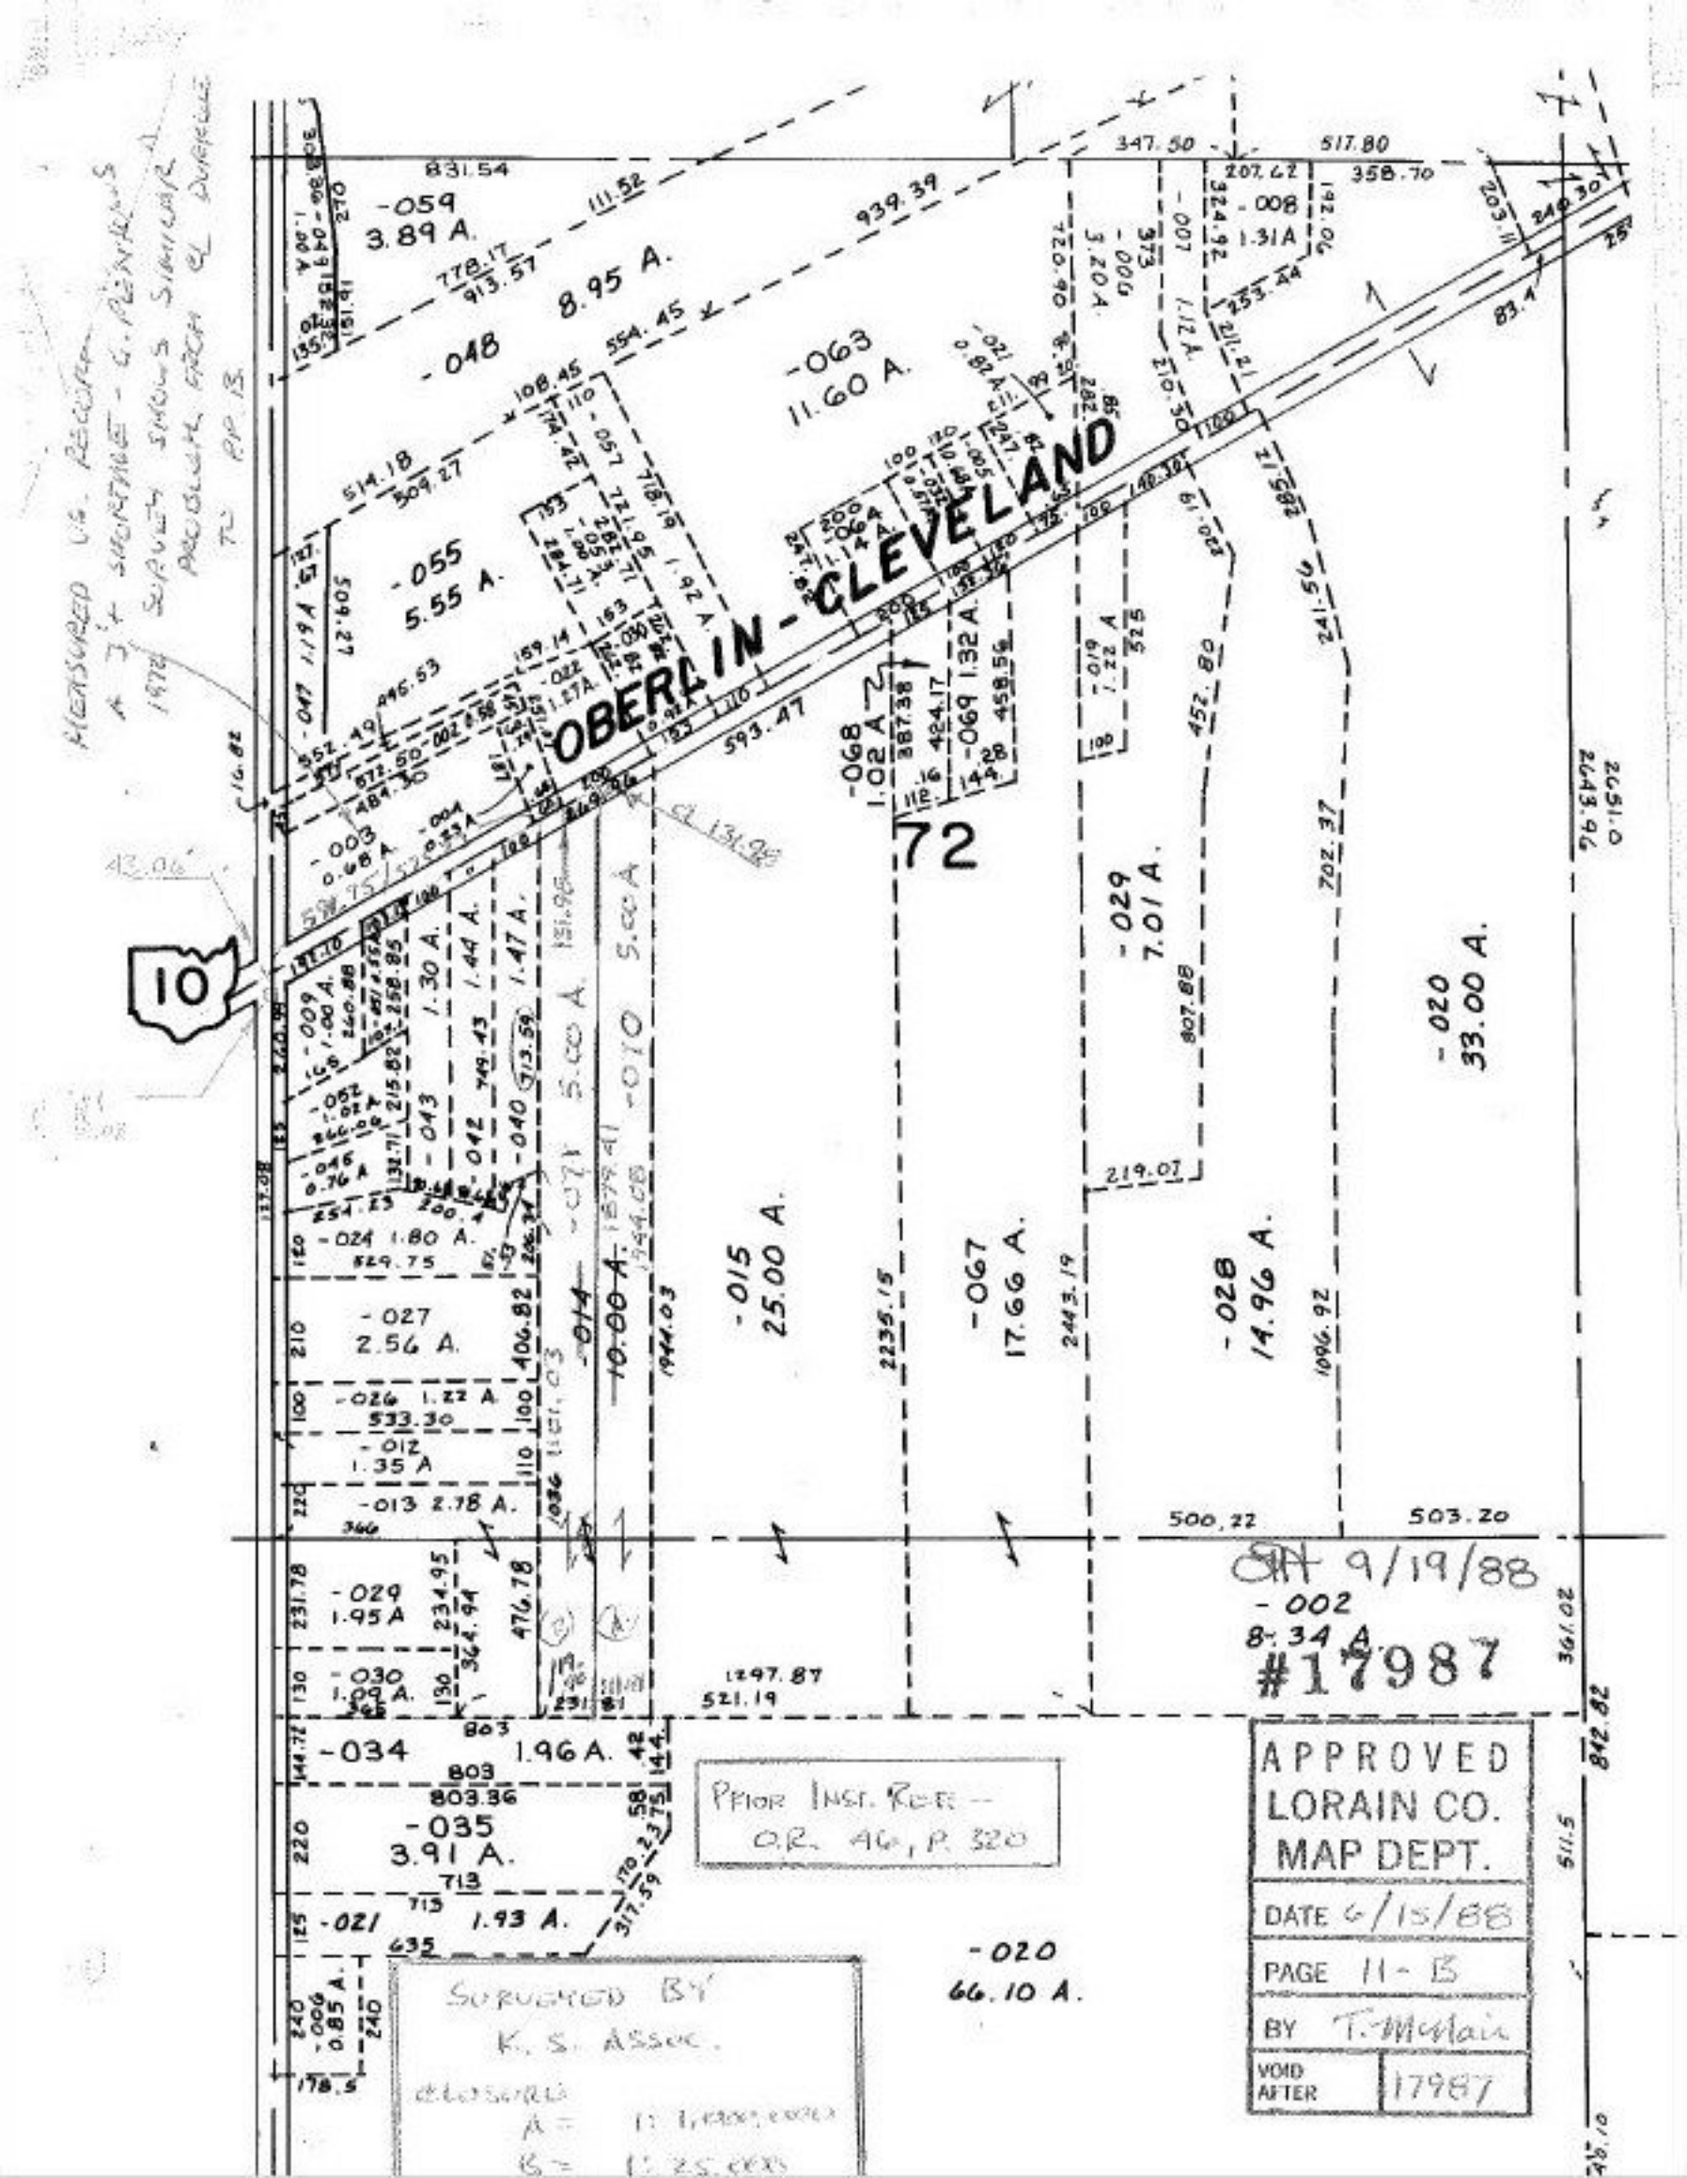
MEASURED U.S. RECORD
TO PIPE
OBERLIN - CLEVELAND
72
10
-059 3.89 A.
-048 8.95 A.
-063 11.60 A.
-055 5.55 A.
-068 1.02 A.
-069 1.32 A.
-029 7.01 A.
-020 33.00 A.
-015 25.00 A.
-067 17.66 A.
-028 14.96 A.
-027 2.56 A.
-026 1.22 A.
-012 1.35 A.
-013 2.78 A.
-029 1.95 A.
-030 1.09 A.
-034 1.96 A.
-035 3.91 A.
-021 1.93 A.
-002 8.34 A.
#17987
9/19/88
PRIOR INST. REF. -- O.R. 46, P. 320
APPROVED
LORAIN CO.
MAP DEPT.
DATE 6/15/88
PAGE 11-B
BY T. McClain
VOID AFTER 17987
SURVEYED BY
K. S. ASSOC.
-020
66.10 A.