MAP CORR

Page CORR

WASHINGTON PARK Sub No 2

Change - V. 21 P. 1A

TO: VOL 21 P-1

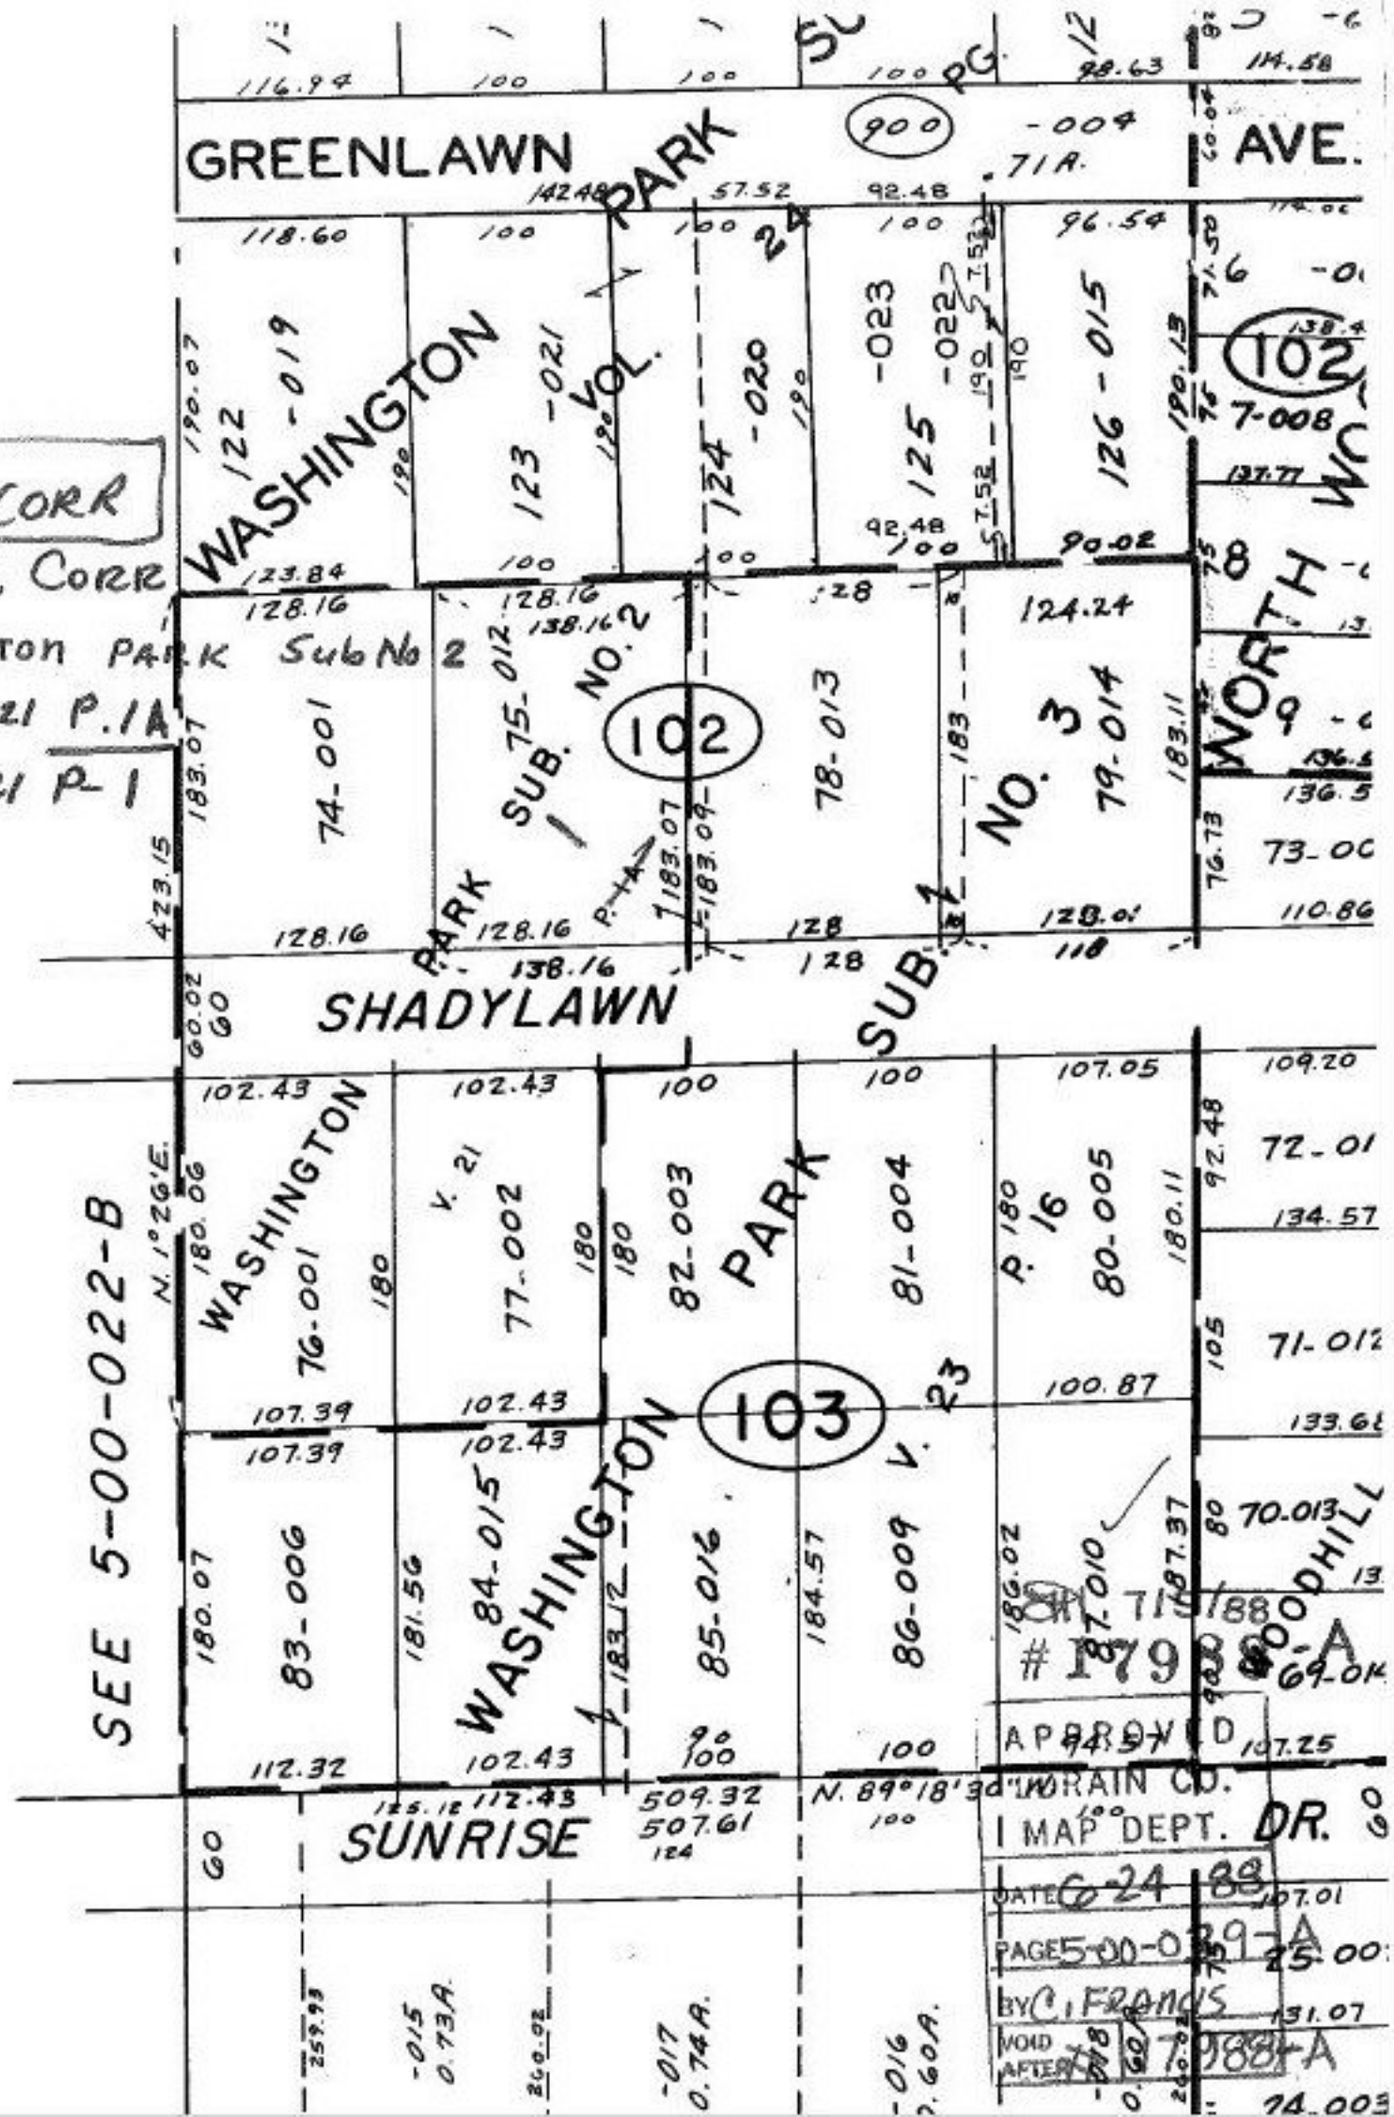

SR 7/5/88
17988-A
APPROVED
DRAIN CO.
MAP DEPT.
DATE 6-24-88
PAGE 5-00-039-A
BY C. FRANCIS
VOID AFTER