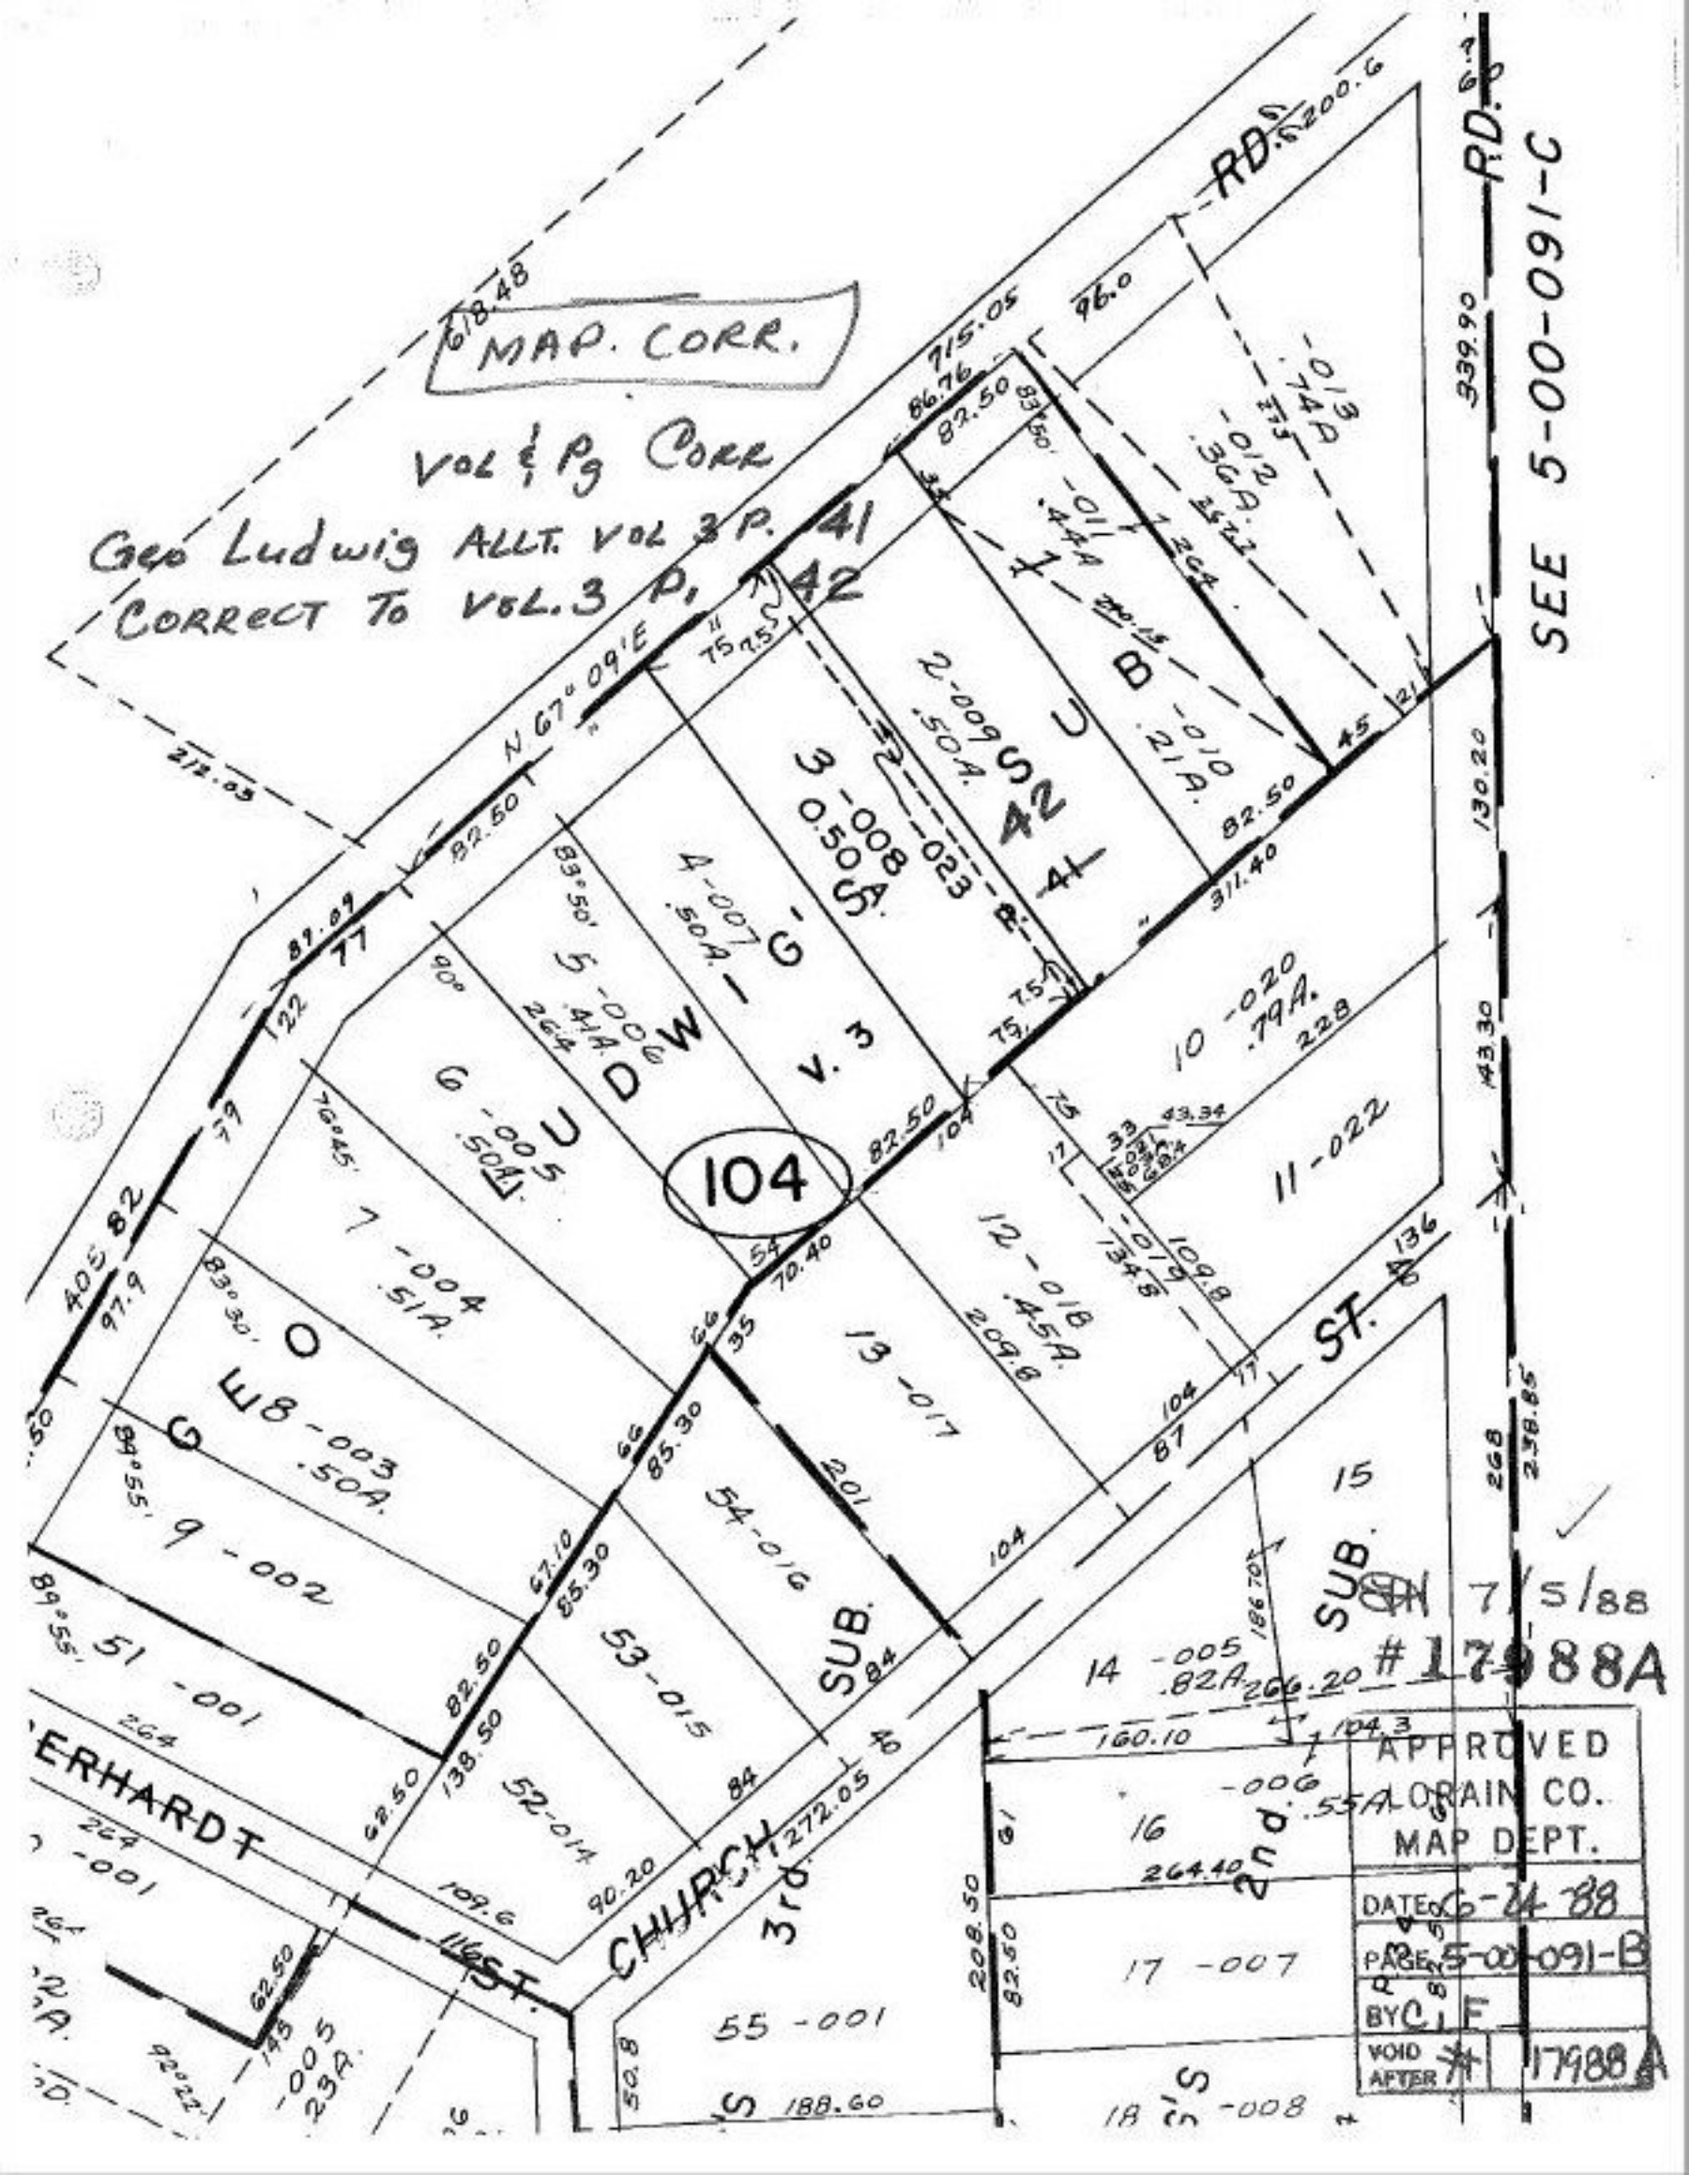
MAP. CORR.
VOL & PG CORR
Geo Ludwig ALLT. VOL 3 P. 41
CORRECT TO VOL. 3 P. 42
SEE 5-00-091-C
RD.
339.90
715.05
618.48
212.03
N 67° 09' E
82.50
87.09
405.82
97.9
.50
104
ST.
136
268
238.85
272.05
3rd
CHURCH
116 ST.
ERHARDT
SUB.
2nd
APPROVED
LORAIN CO.
MAP DEPT.
DATE 6-24-88
PAGE 5-00-091-B
BY C.L.F.
VOID AFTER 7/5/88
#17988A
7/5/88
#17988A