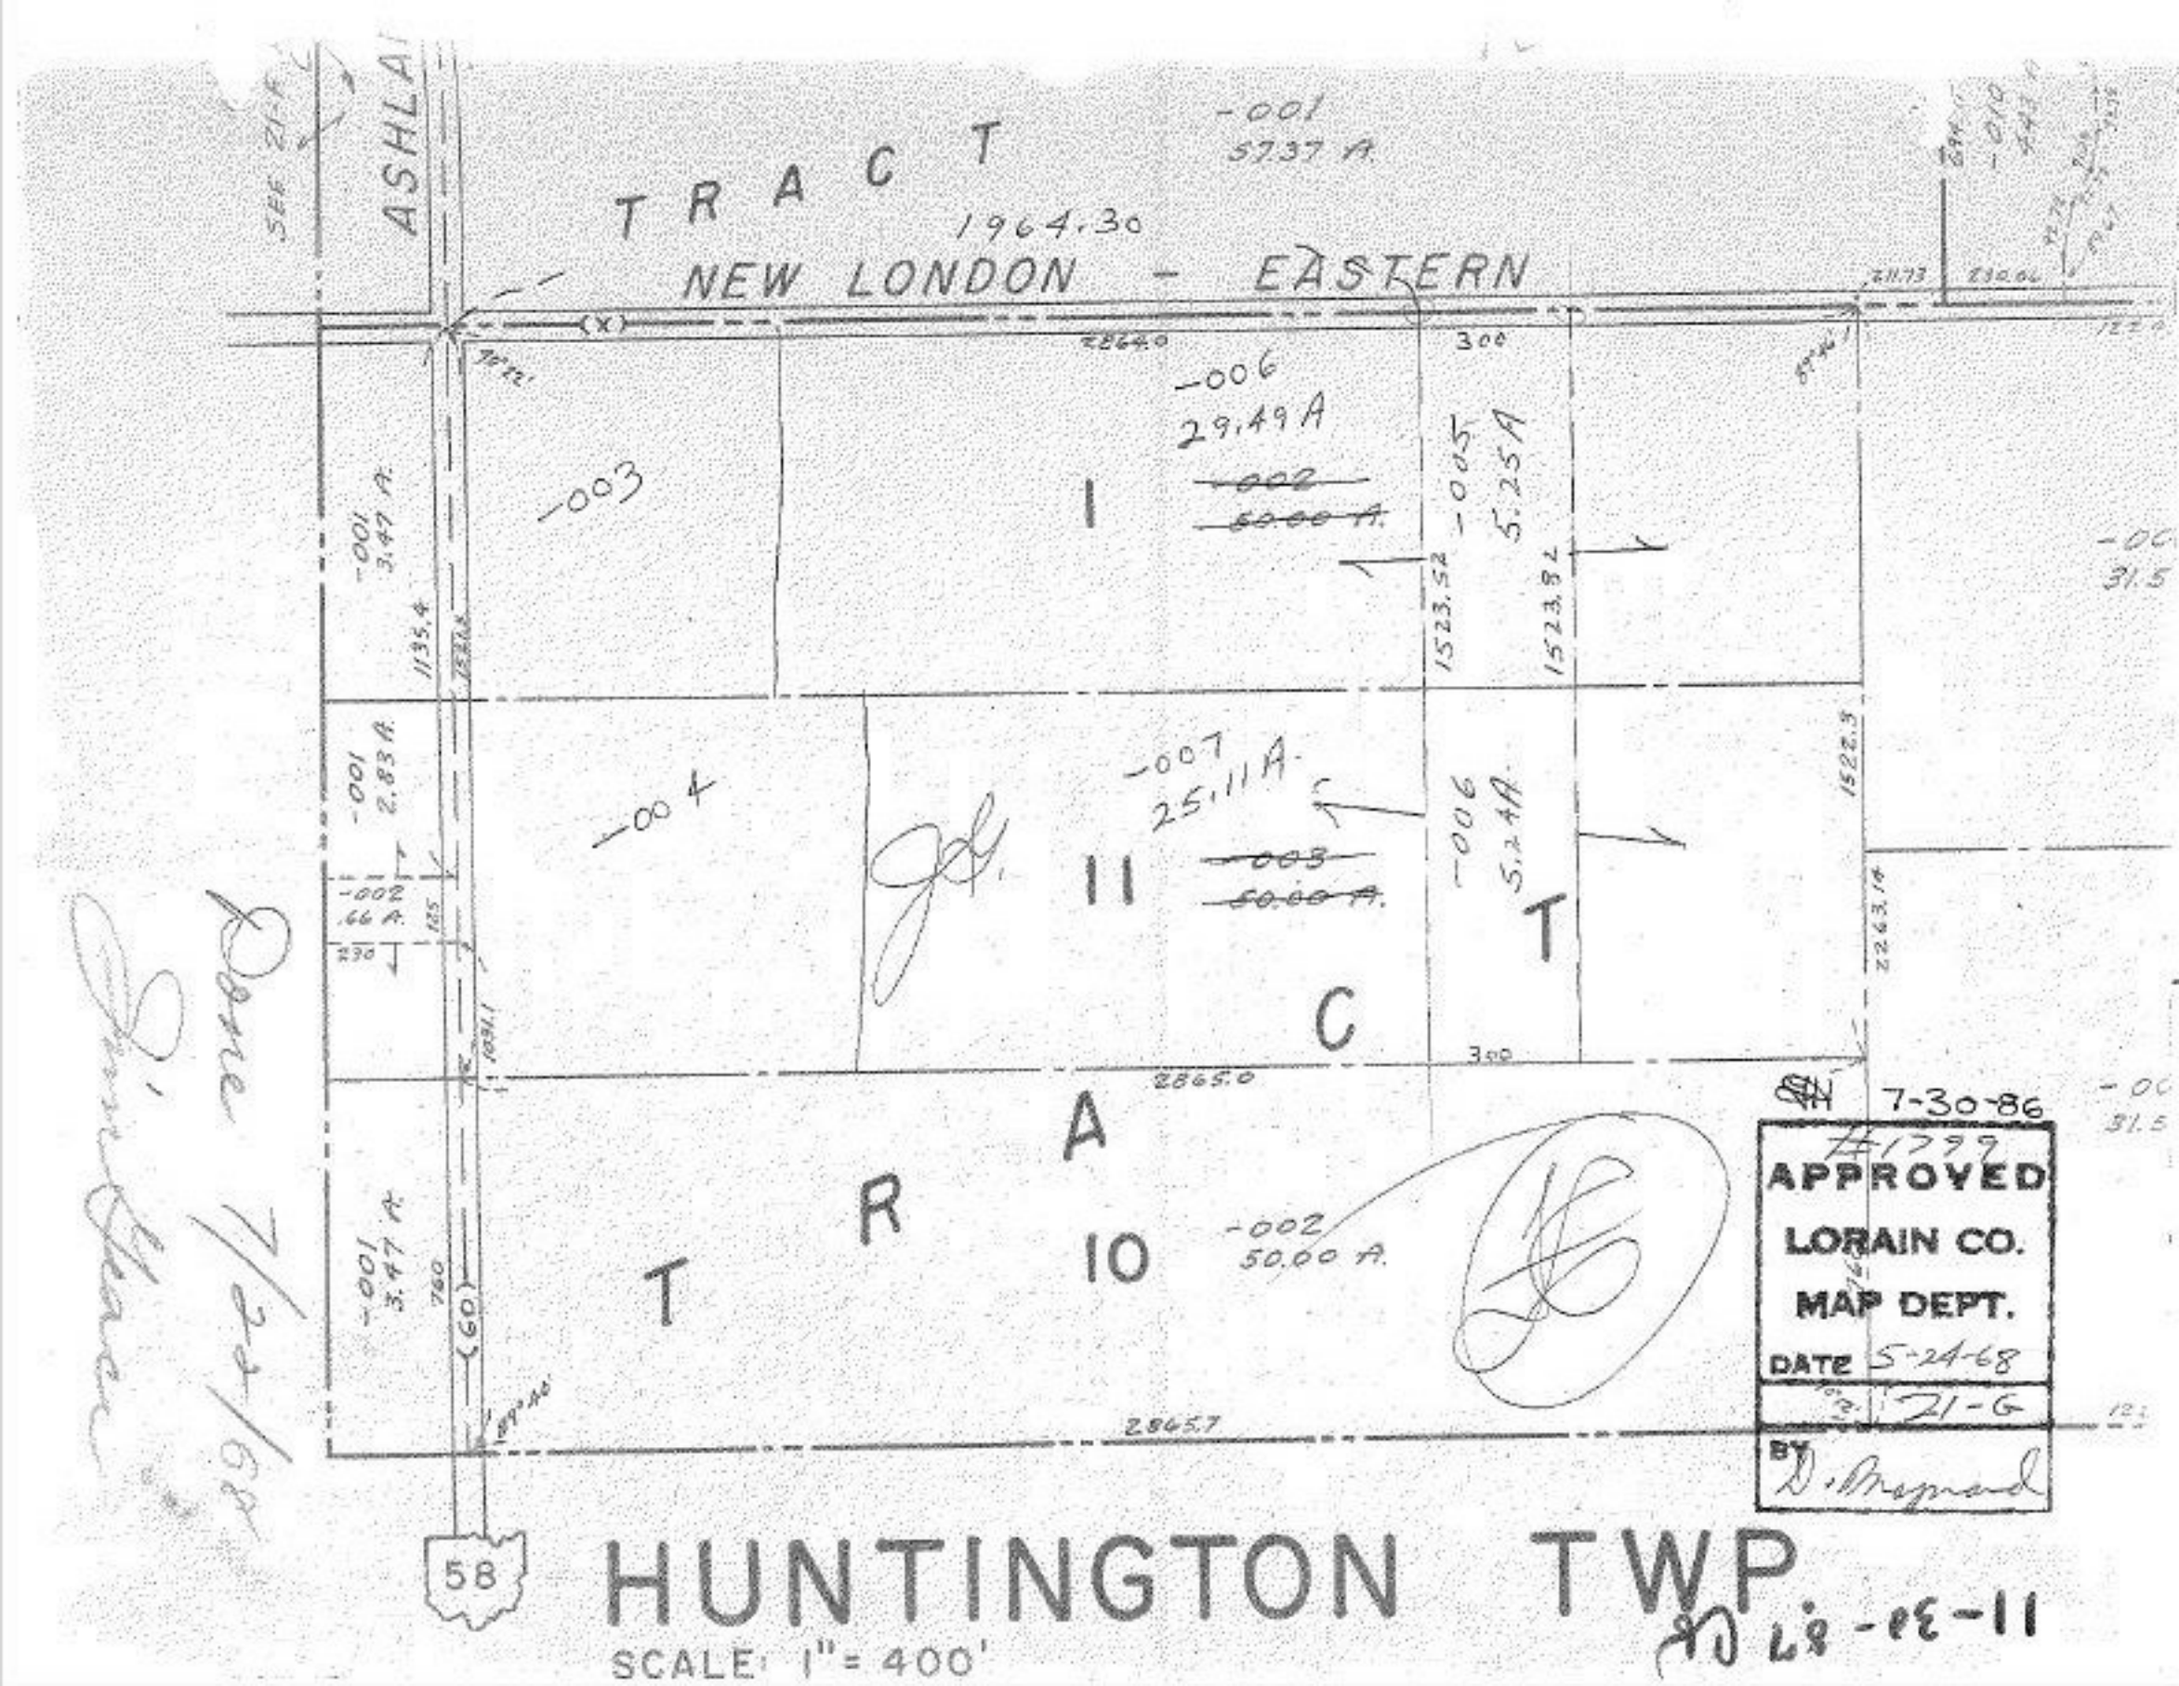
TRACT
1964.30
-001
57.37 A.
NEW LONDON - EASTERN
ASHLAND
SEE 21-F
-003
-001
3.47 A.
1135.4
-004
-001
2.83 A.
-002
.66 A.
-006
29.49 A.
-002
5.00 A.
-005
5.25 A.
1523.52
1523.82
-007
25.11 A.
-003
50.00 A.
-006
5.24 A.
1522.3
2263.14
TRACT 11
TRACT 10
-002
50.00 A.
-001
3.47 A.
2865.0
2845.7
760
(60)
58
7-30-86
#1799
APPROVED
LORAIN CO.
MAP DEPT.
DATE 5-24-68
21-G
BY D. Maynard
HUNTINGTON TWP
SCALE: 1" = 400'
Lane 7-24-68
Lorain Clerk
