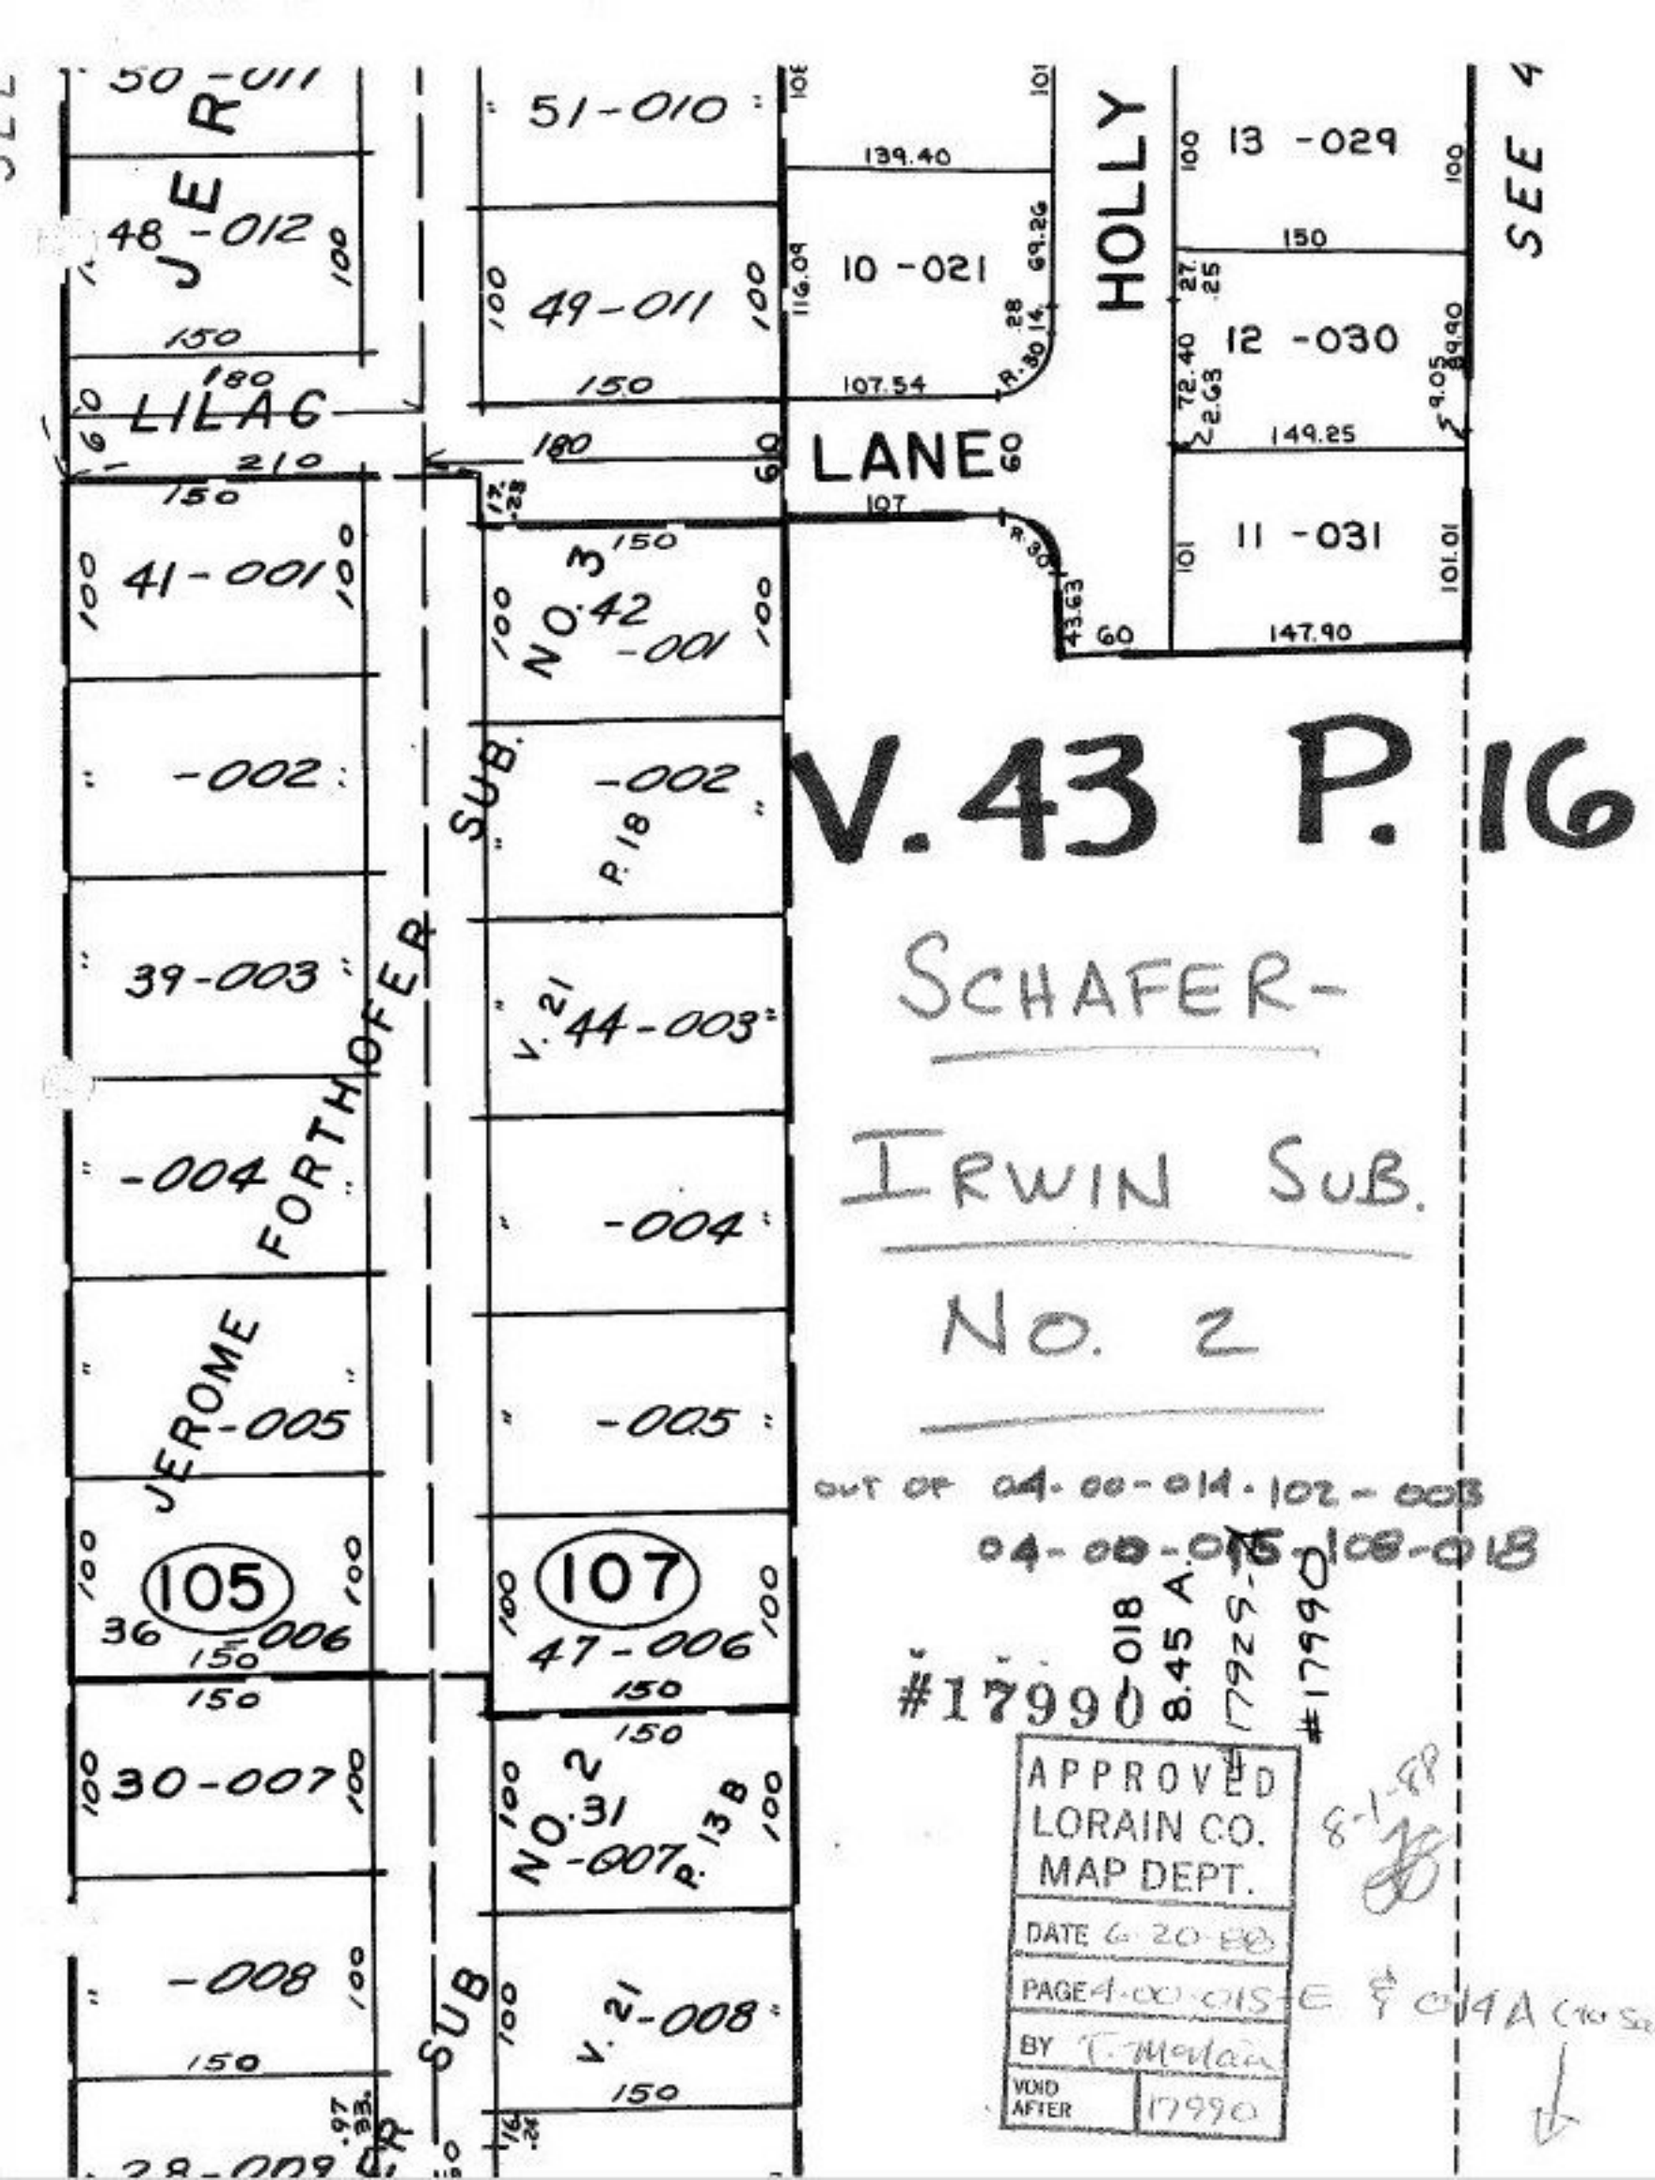

50-011
JER
48-012
LILAC
41-001
-002
39-003
-004
JEROME FORTHOFER SUB.
-005
105
36-006
30-007
-008
28-009
51-010
49-011
NO. 3
42-001
-002
P. 18
V. 21
44-003
-004
-005
107
47-006
NO. 2
31-007
P. 13 B
V. 21
-008
HOLLY
LANE
10-021
13-029
12-030
11-031
SEE 4
V. 43 P. 16
SCHAFER-
IRWIN SUB.
NO. 2
OUT OF 04-00-014-102-003
04-00-015-108-018
#17990
8.45 A.
#17929
#17990
APPROVED
LORAIN CO.
MAP DEPT.
DATE 6-20-88
PAGE 4-00-015-E & 014A (to South)
BY T. Moran
VOID AFTER 17990
8-1-88