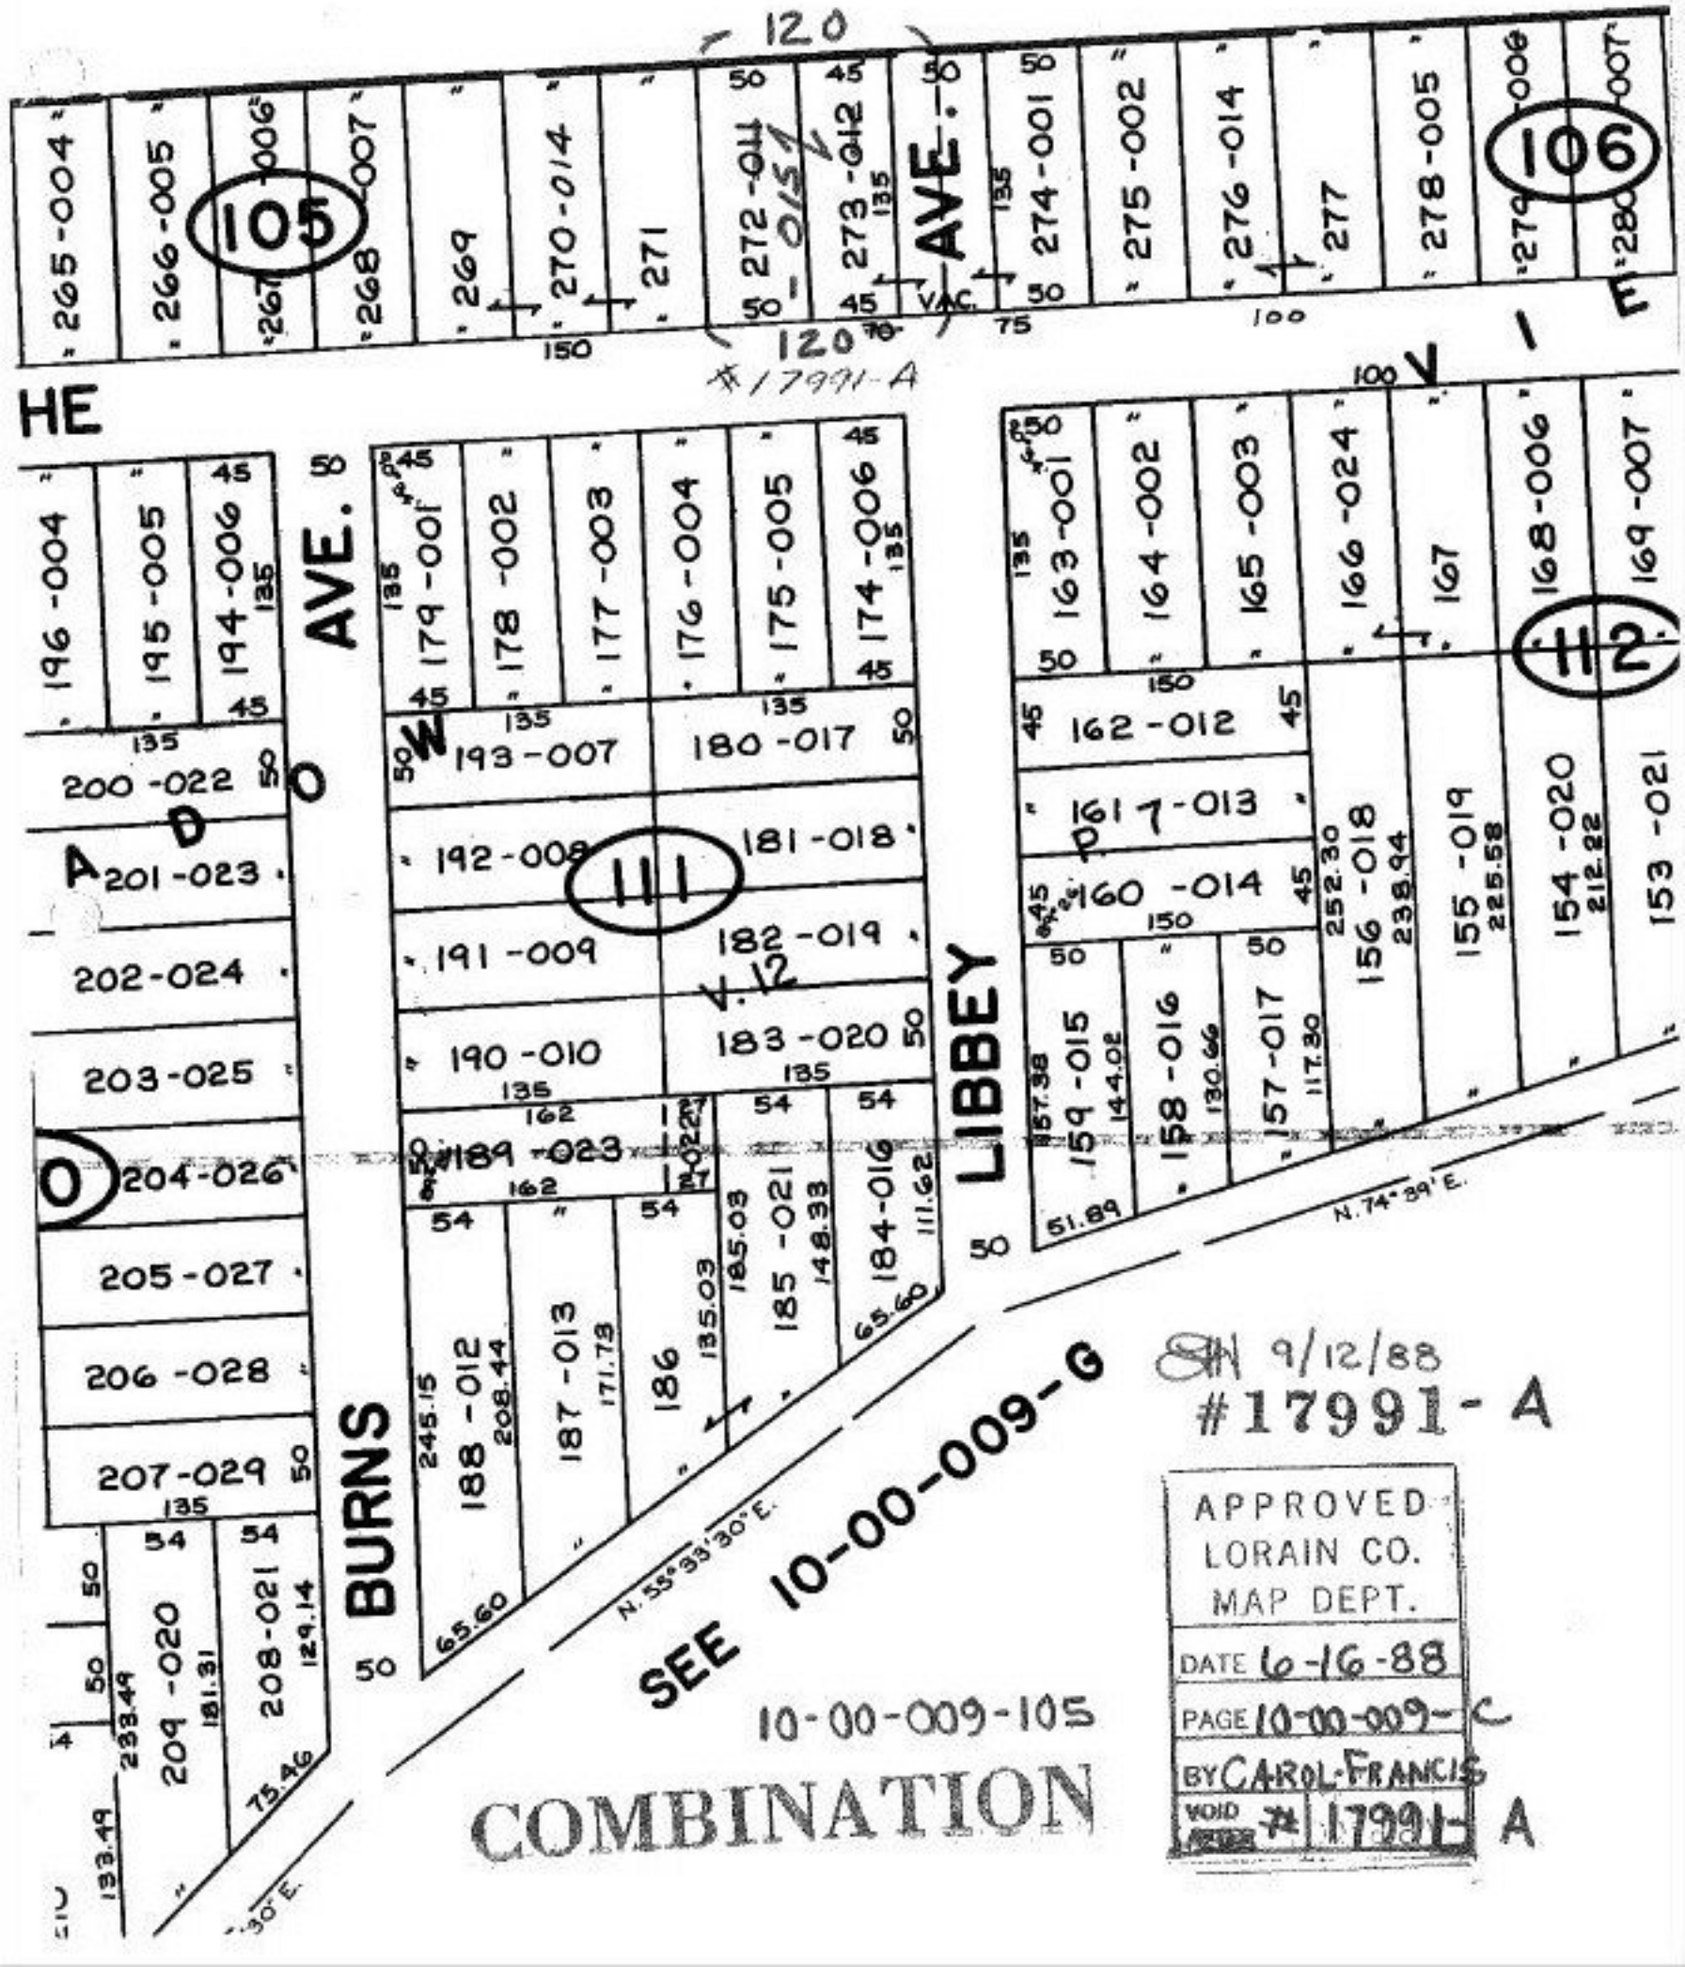

SN 9/12/88

#17991-A

APPROVED
LORAIN CO.
MAP DEPT.
DATE 6-16-88
PAGE 10-00-009-C
BY CAROL FRANCIS
VOID #17991-A

10-00-009-105

COMBINATION