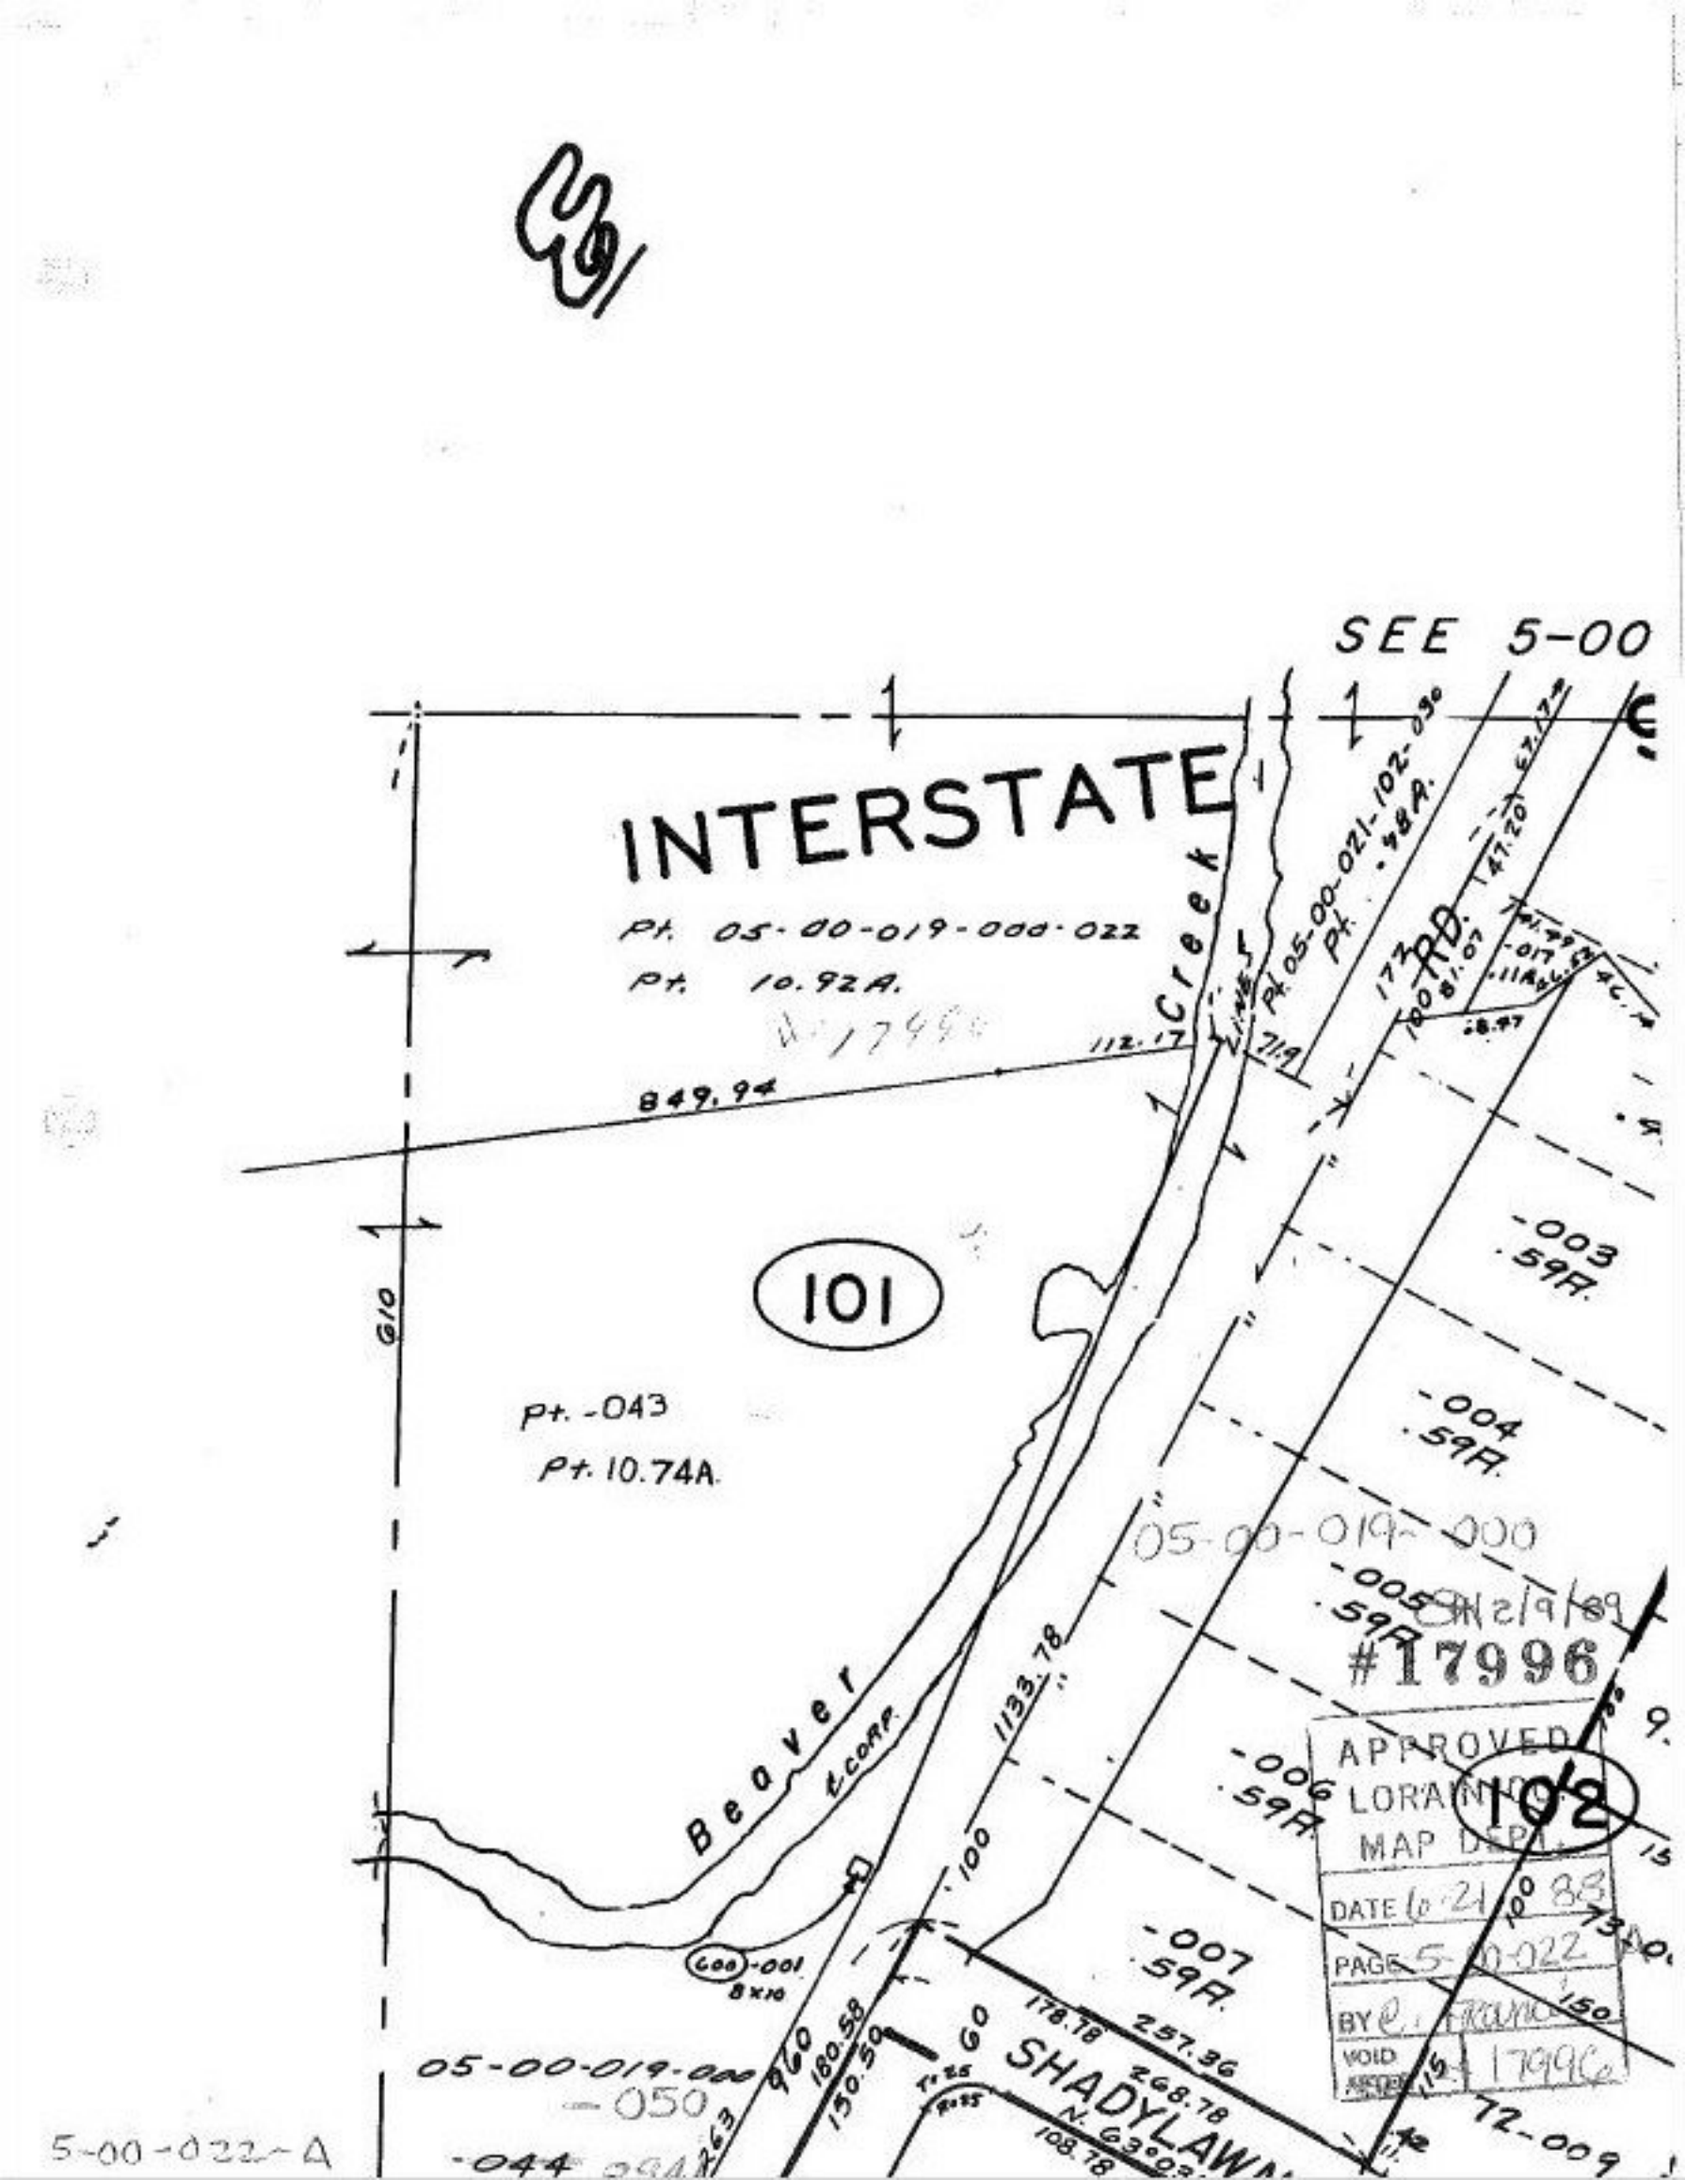
SEE 5-00
INTERSTATE
Pt. 05-00-019-000-022
Pt. 10.92A.
#17996
112.17
849.94
G10
101
Pt. -043
Pt. 10.74A.
Beaver Creek
1133.78
100
-003 .59A.
-004 .59A.
05-00-019-000
-005 .59A.
SN 2/9/89
#17996
-006 .59A.
APPROVED
LORAIN CO.
MAP DEPT.
DATE 6-21-88
PAGE 5-00-022
BY
VOID
ASSIGN
#17996
102
-007 .59A.
178.78
257.36
268.78
N. 63°02'
108.78
SHADYLAWN
960
180.58
130.50
263
60
05-00-019-000
-050
-044
5-00-022-A
72-009
150
100