PARENT PARCEL: 06-25-011-101-019
CHILD PARCEL: 06-25-011-101-031, -032
STARTING POINT: INTERSECTION OF C/L OF CLEVELAND ST. AND C/L OF S.R.57

18-00762

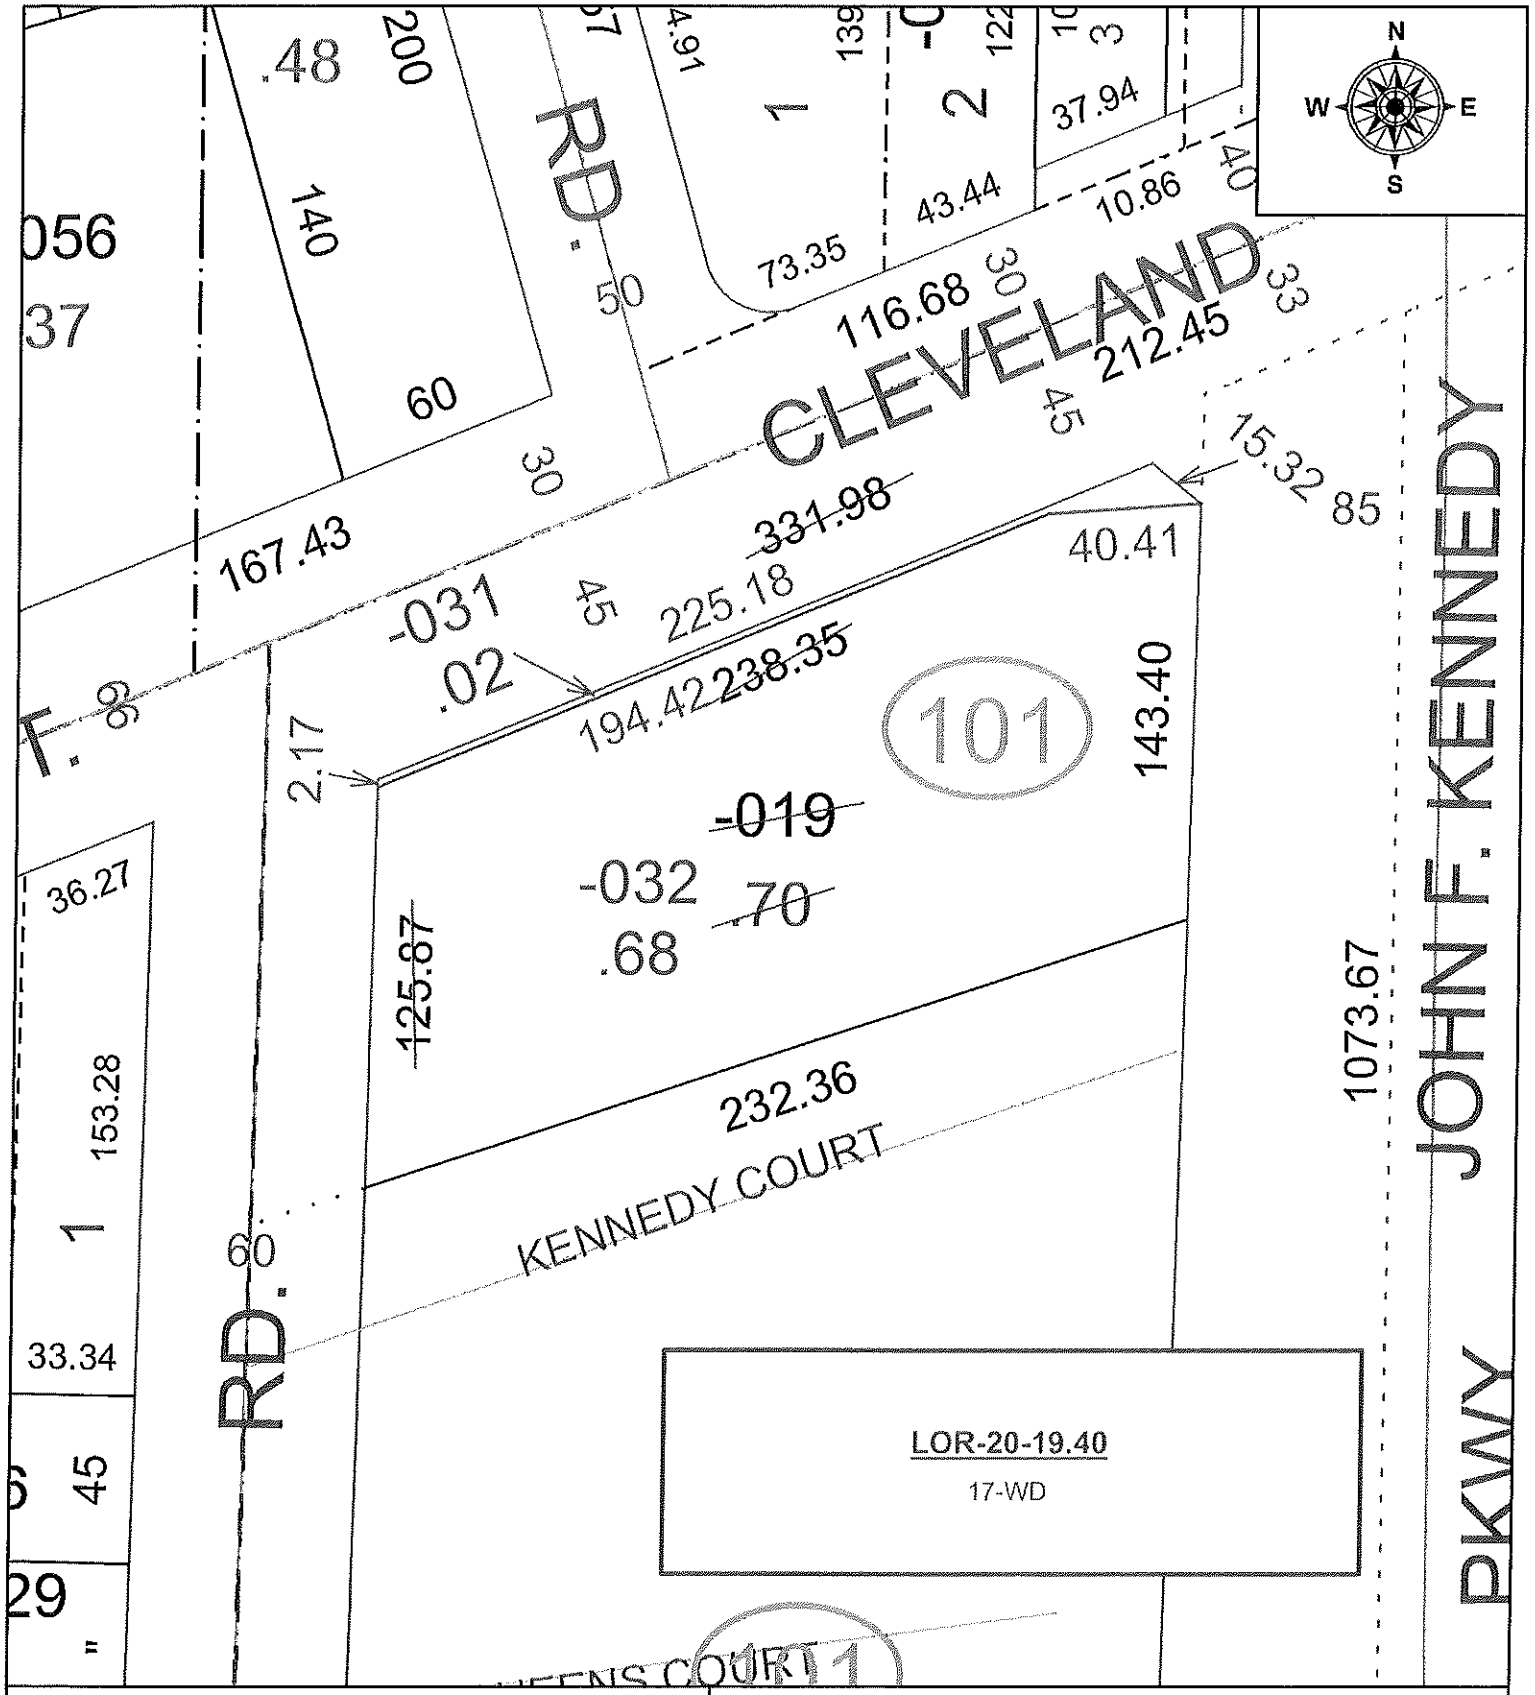

SPLITS/DEEDS PROCESSED
LORAIN COUNTY TAX MAP DEPARTMENT
226 MIDDLE AVE. ELYRIA, OH

SURVEYED BY: BRIAN P. BINGHAM
CLOSURE: 1: 69,686
MAP PAGE(S): 6-89
APPOVED BY: RRM **DATE:** 2-2-18
SCALE: 1" = 50 **PRIOR INSTRUMENT:** 20010784355